


VOID See New PLASTIC

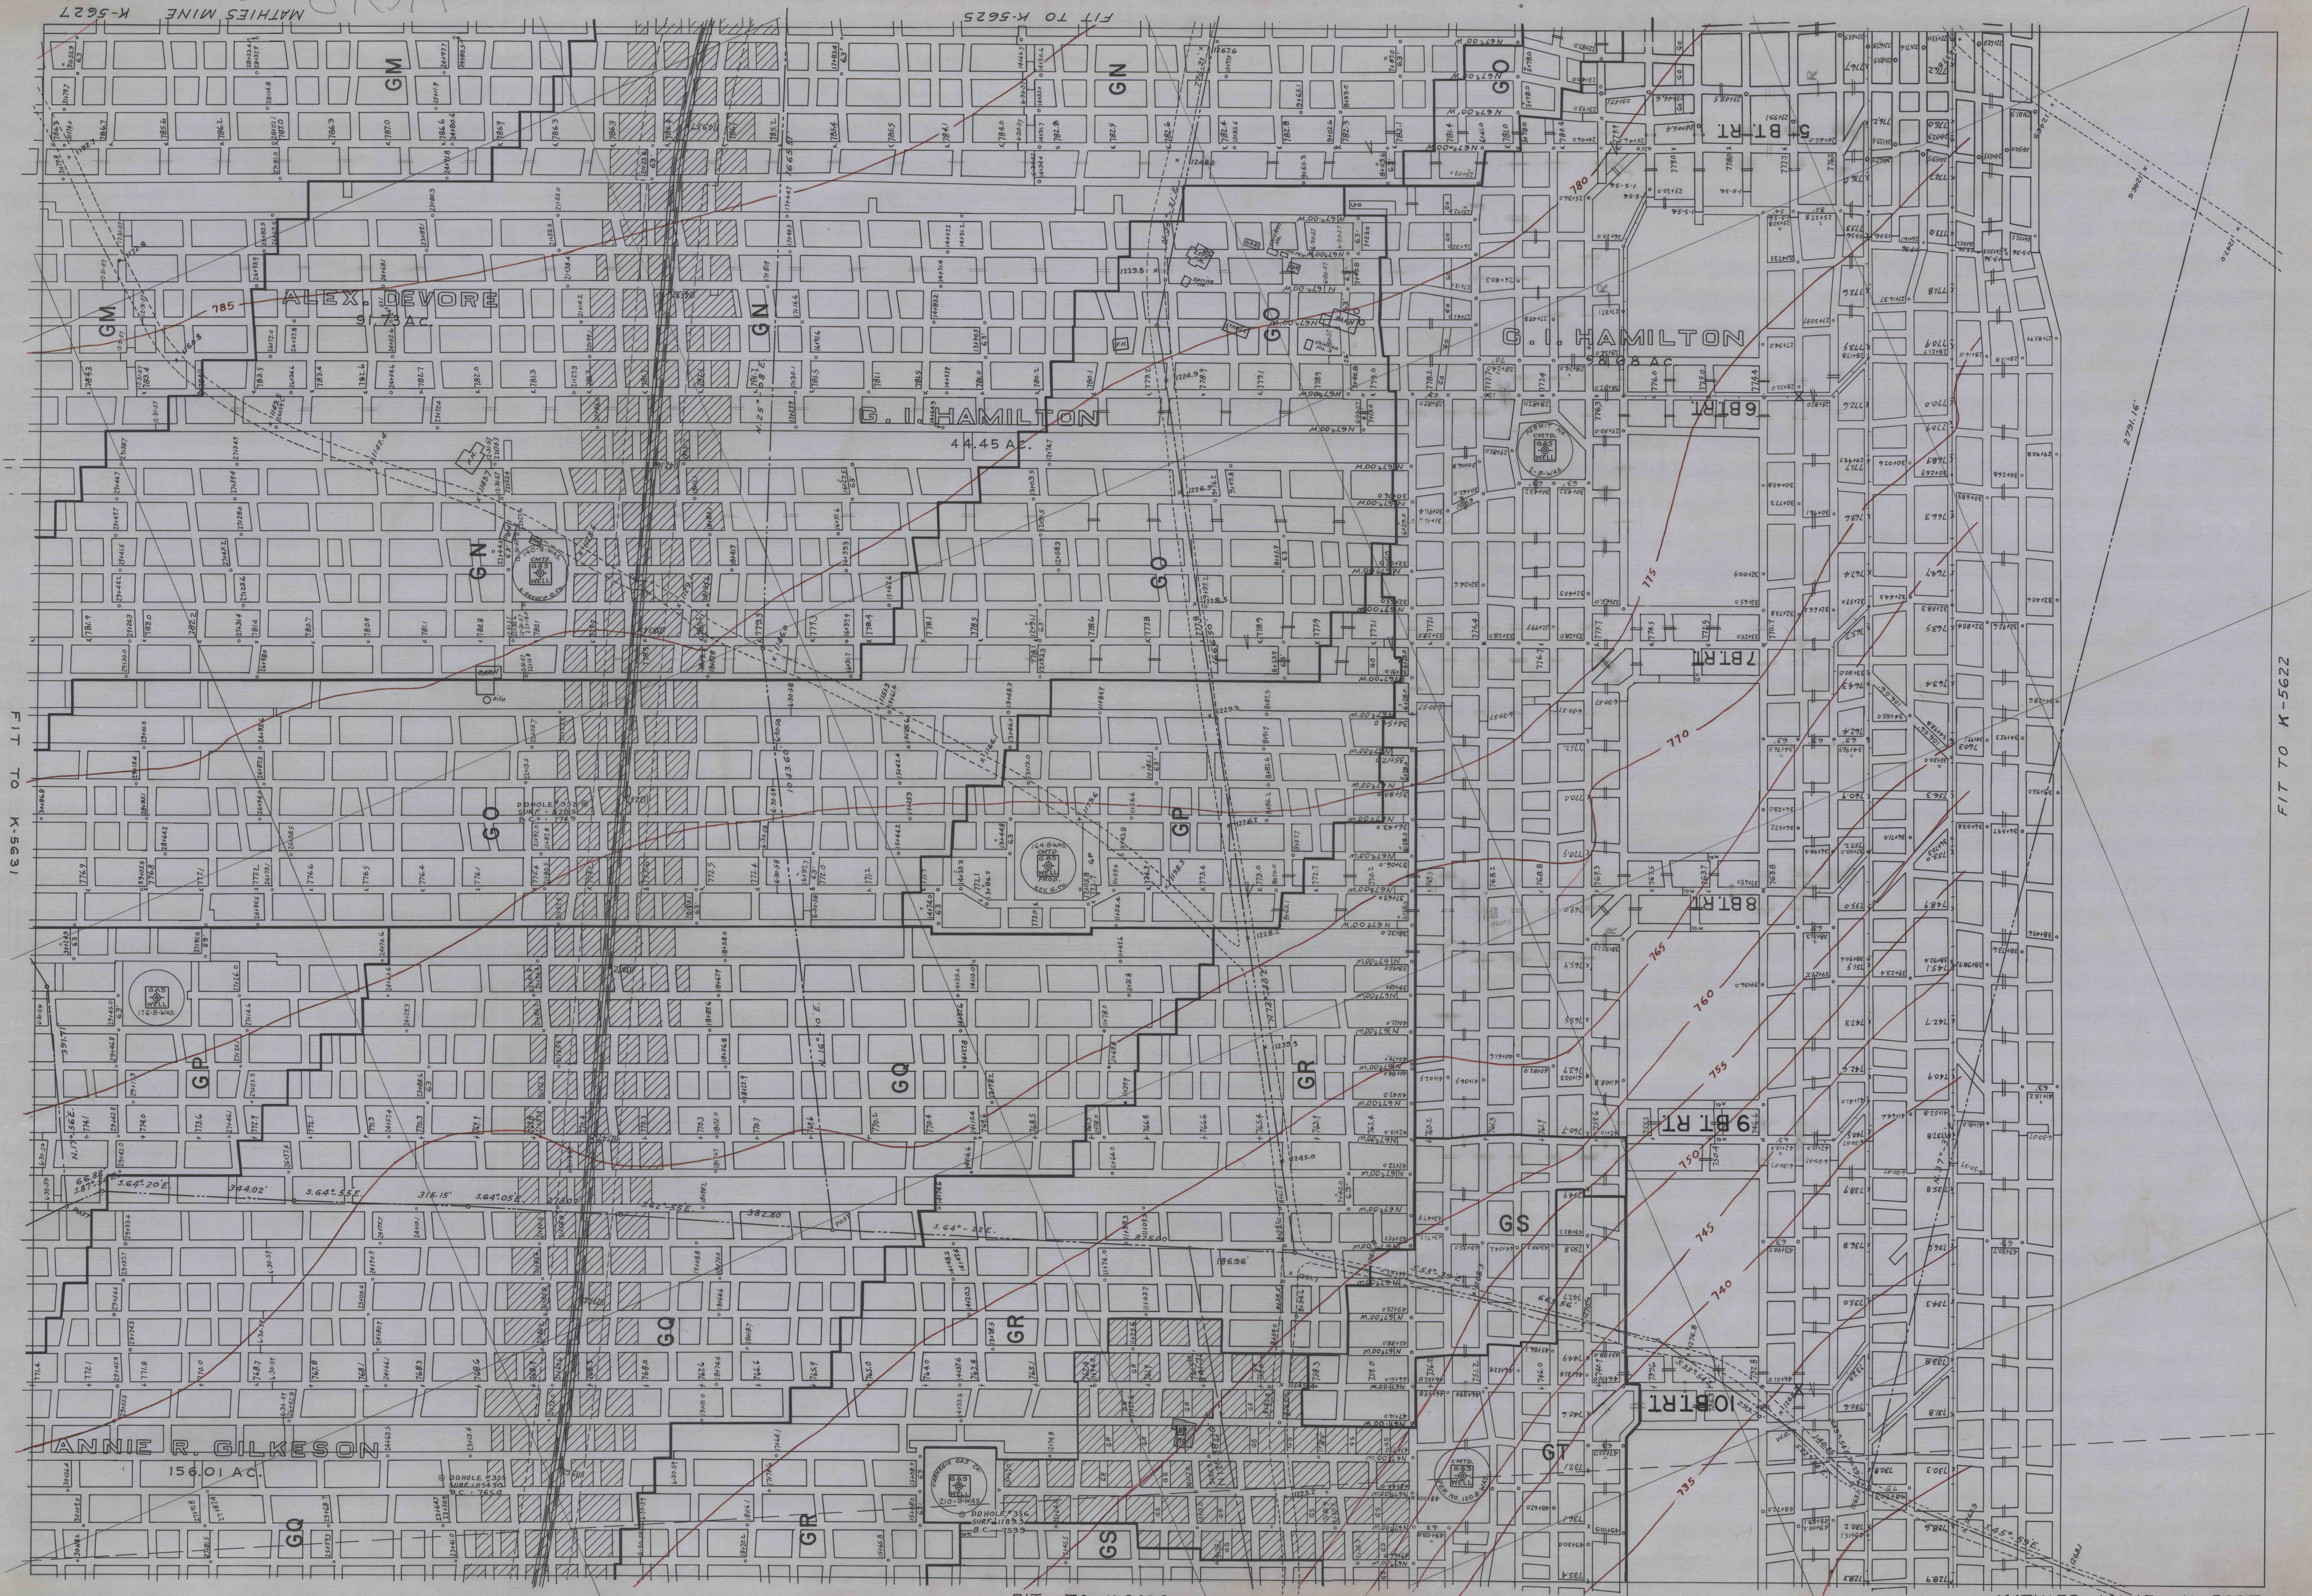

FIT TO K-5631

FIT TO K-5625

FIT TO K-5636

FIT TO K-5622

VOID See New PLASTIC

MATHIES MINE K-5622