


VOID See New Plastic

MATHIES MINE K-5649

Fit to K-5635

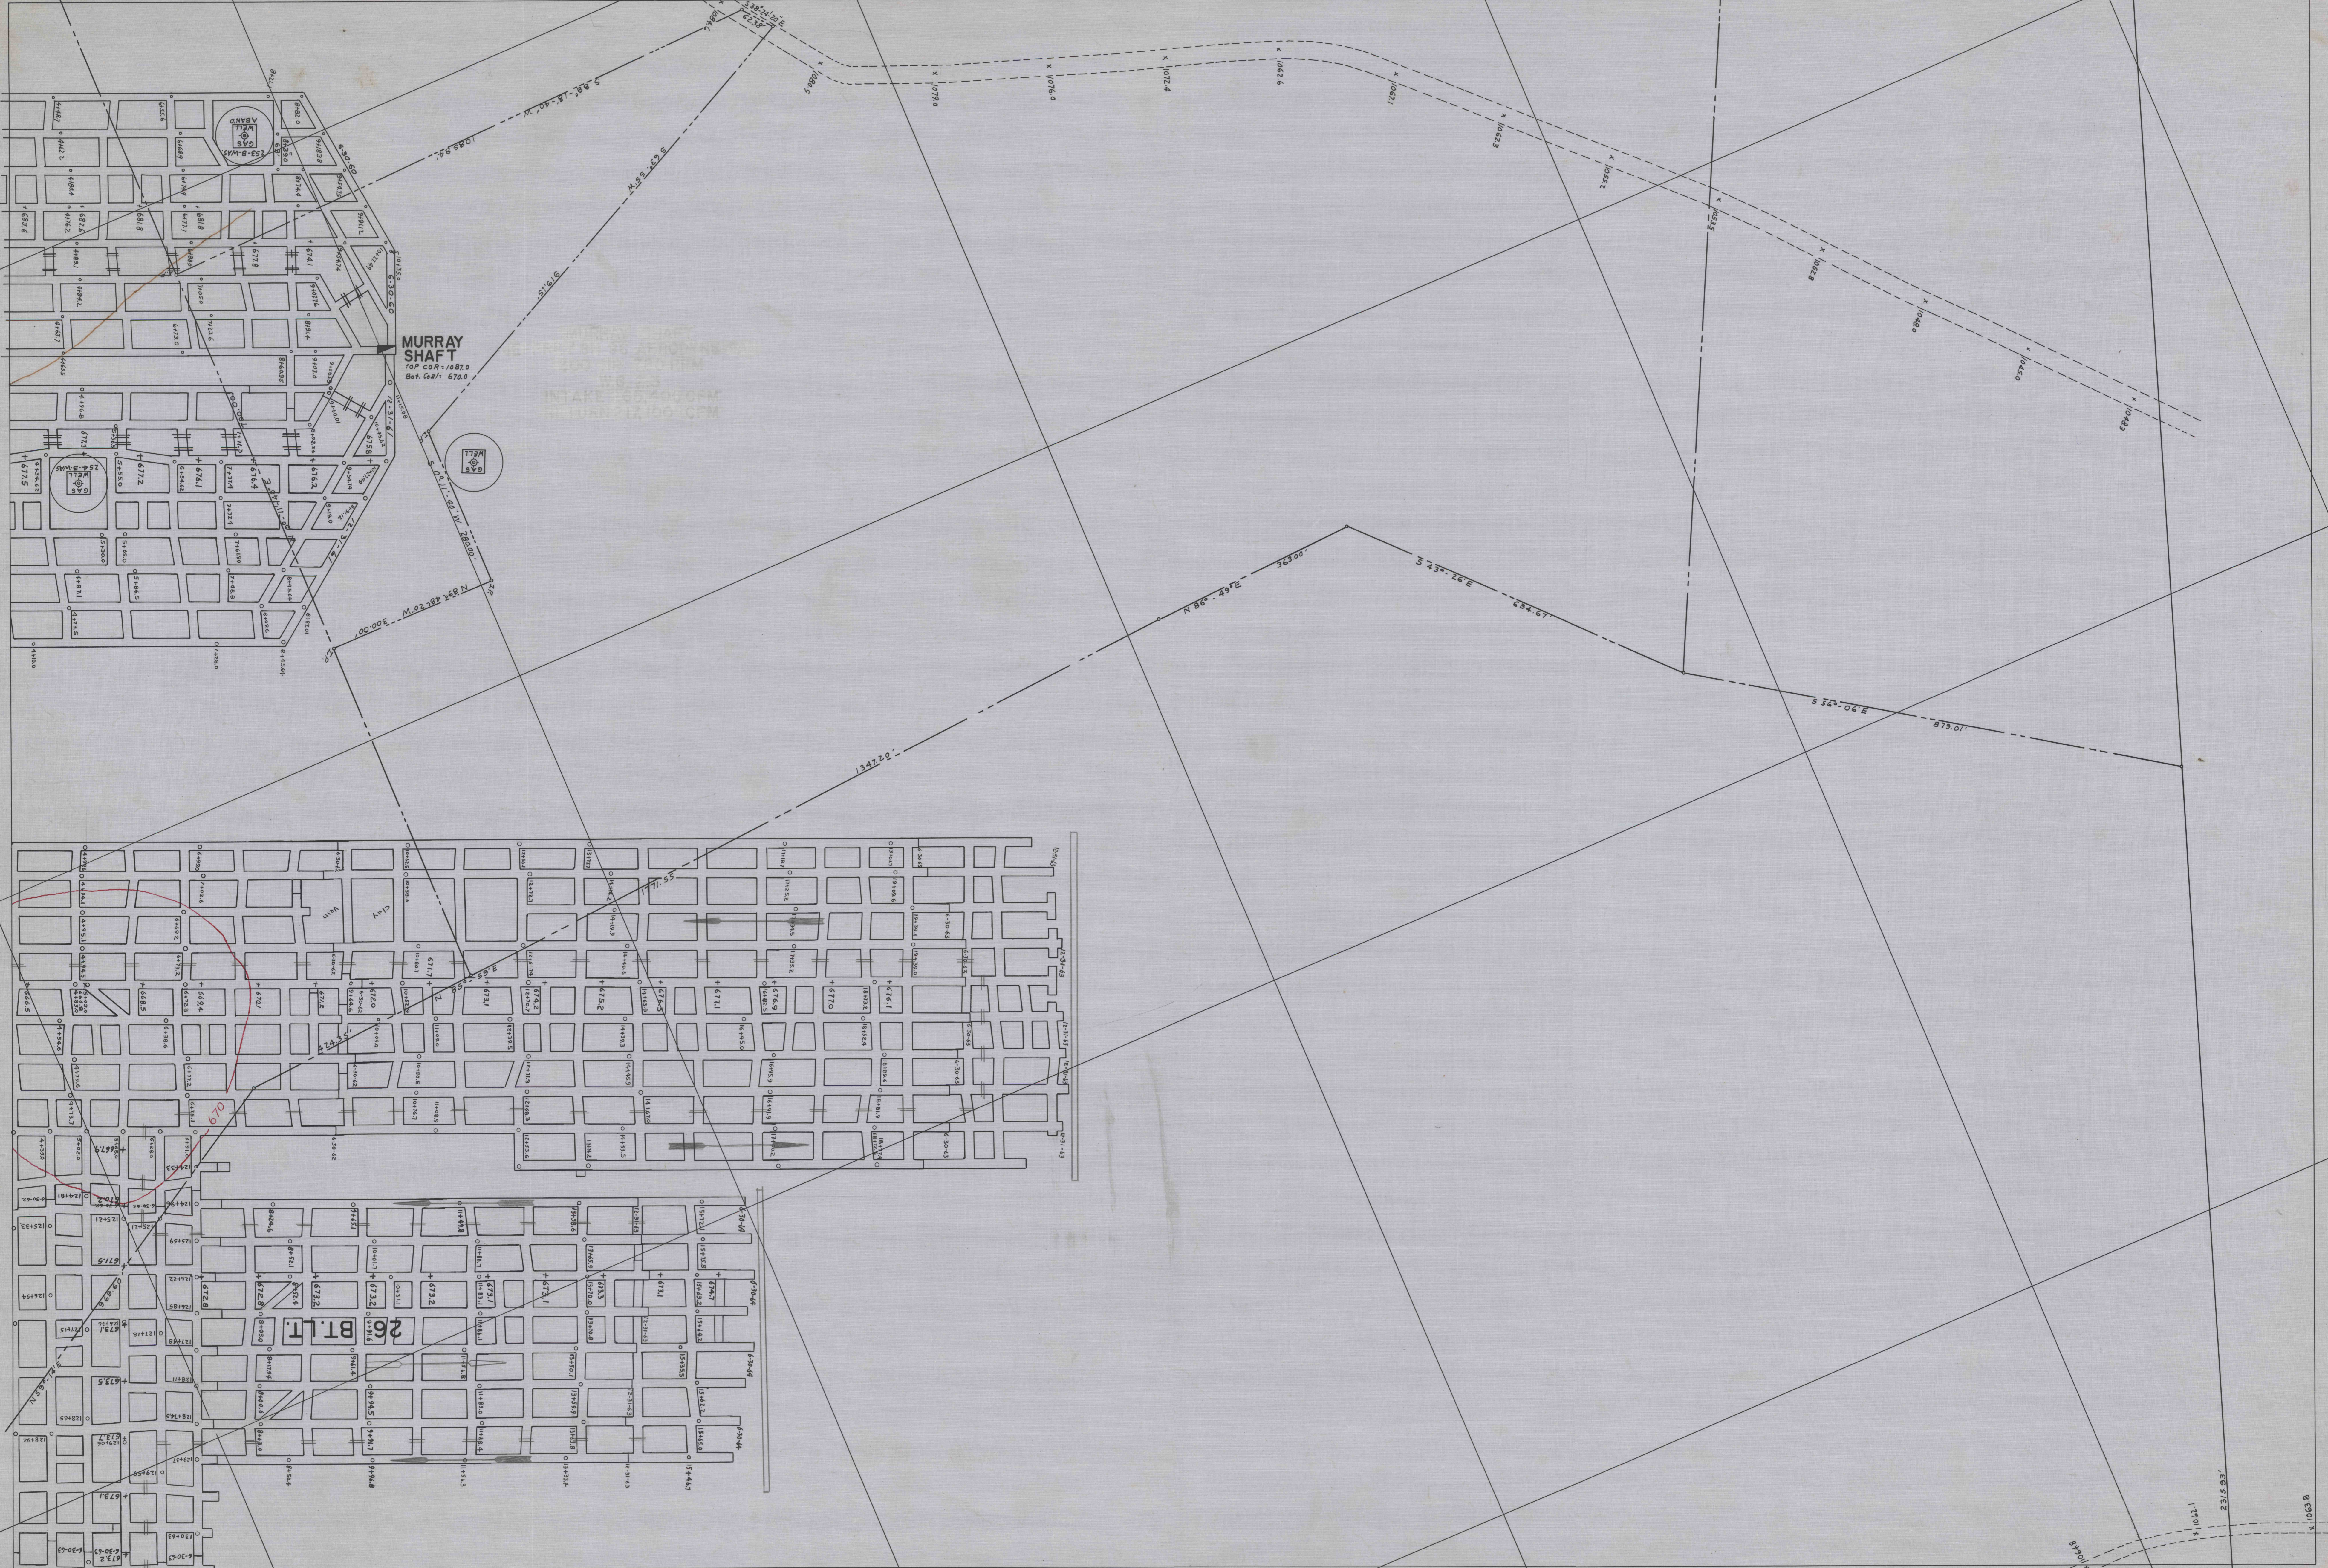

Fit to K-5650

VOID See New Sheet

MATHIES MINE K-5649