


29.007 AC SURF.
SAID TO
WM. F. HESS ET UX
10-17-33

FIT TO K-5630

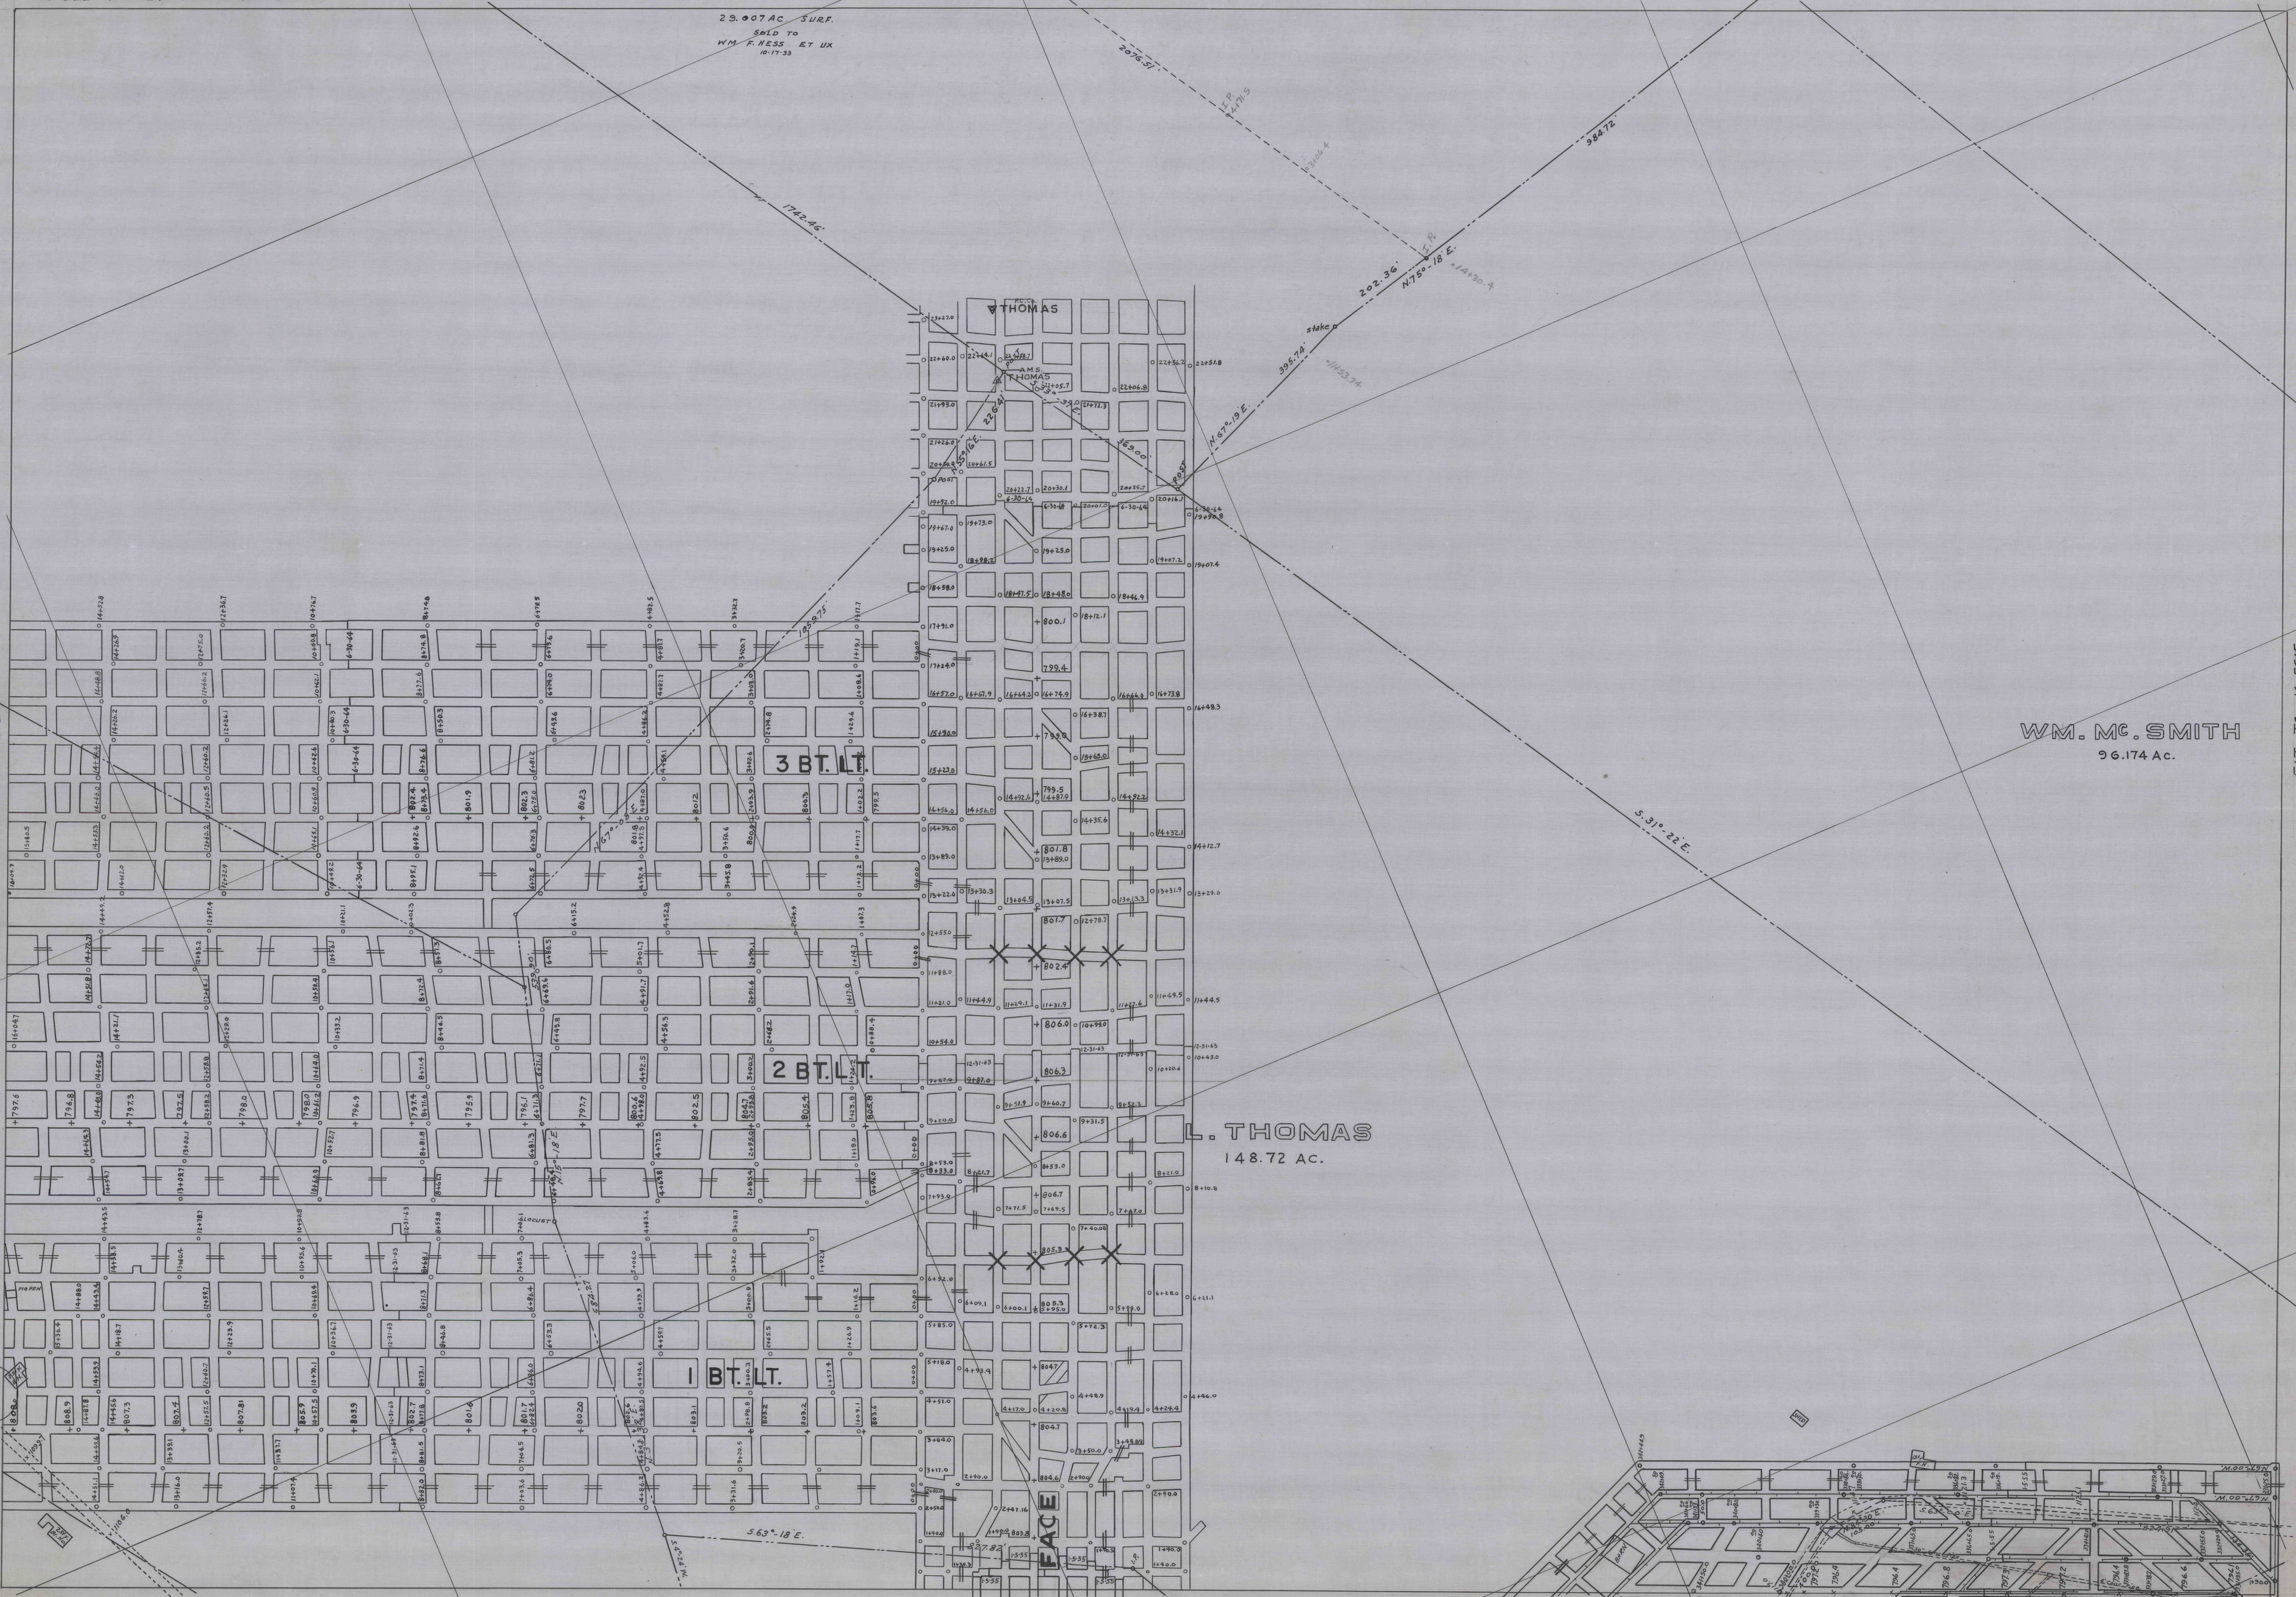

WM. MC. SMITH
96.174 AC.

L. THOMAS
148.72 AC.

1 BT. LT.

2 BT. LT.

3 BT. LT.

FACE

FIT TO K-5625

FIT TO K-5615