


# BUFFALO MINE

F. M. KENNEDY

192.35 AC.

JOHN A. HAPPER  
212.20A.

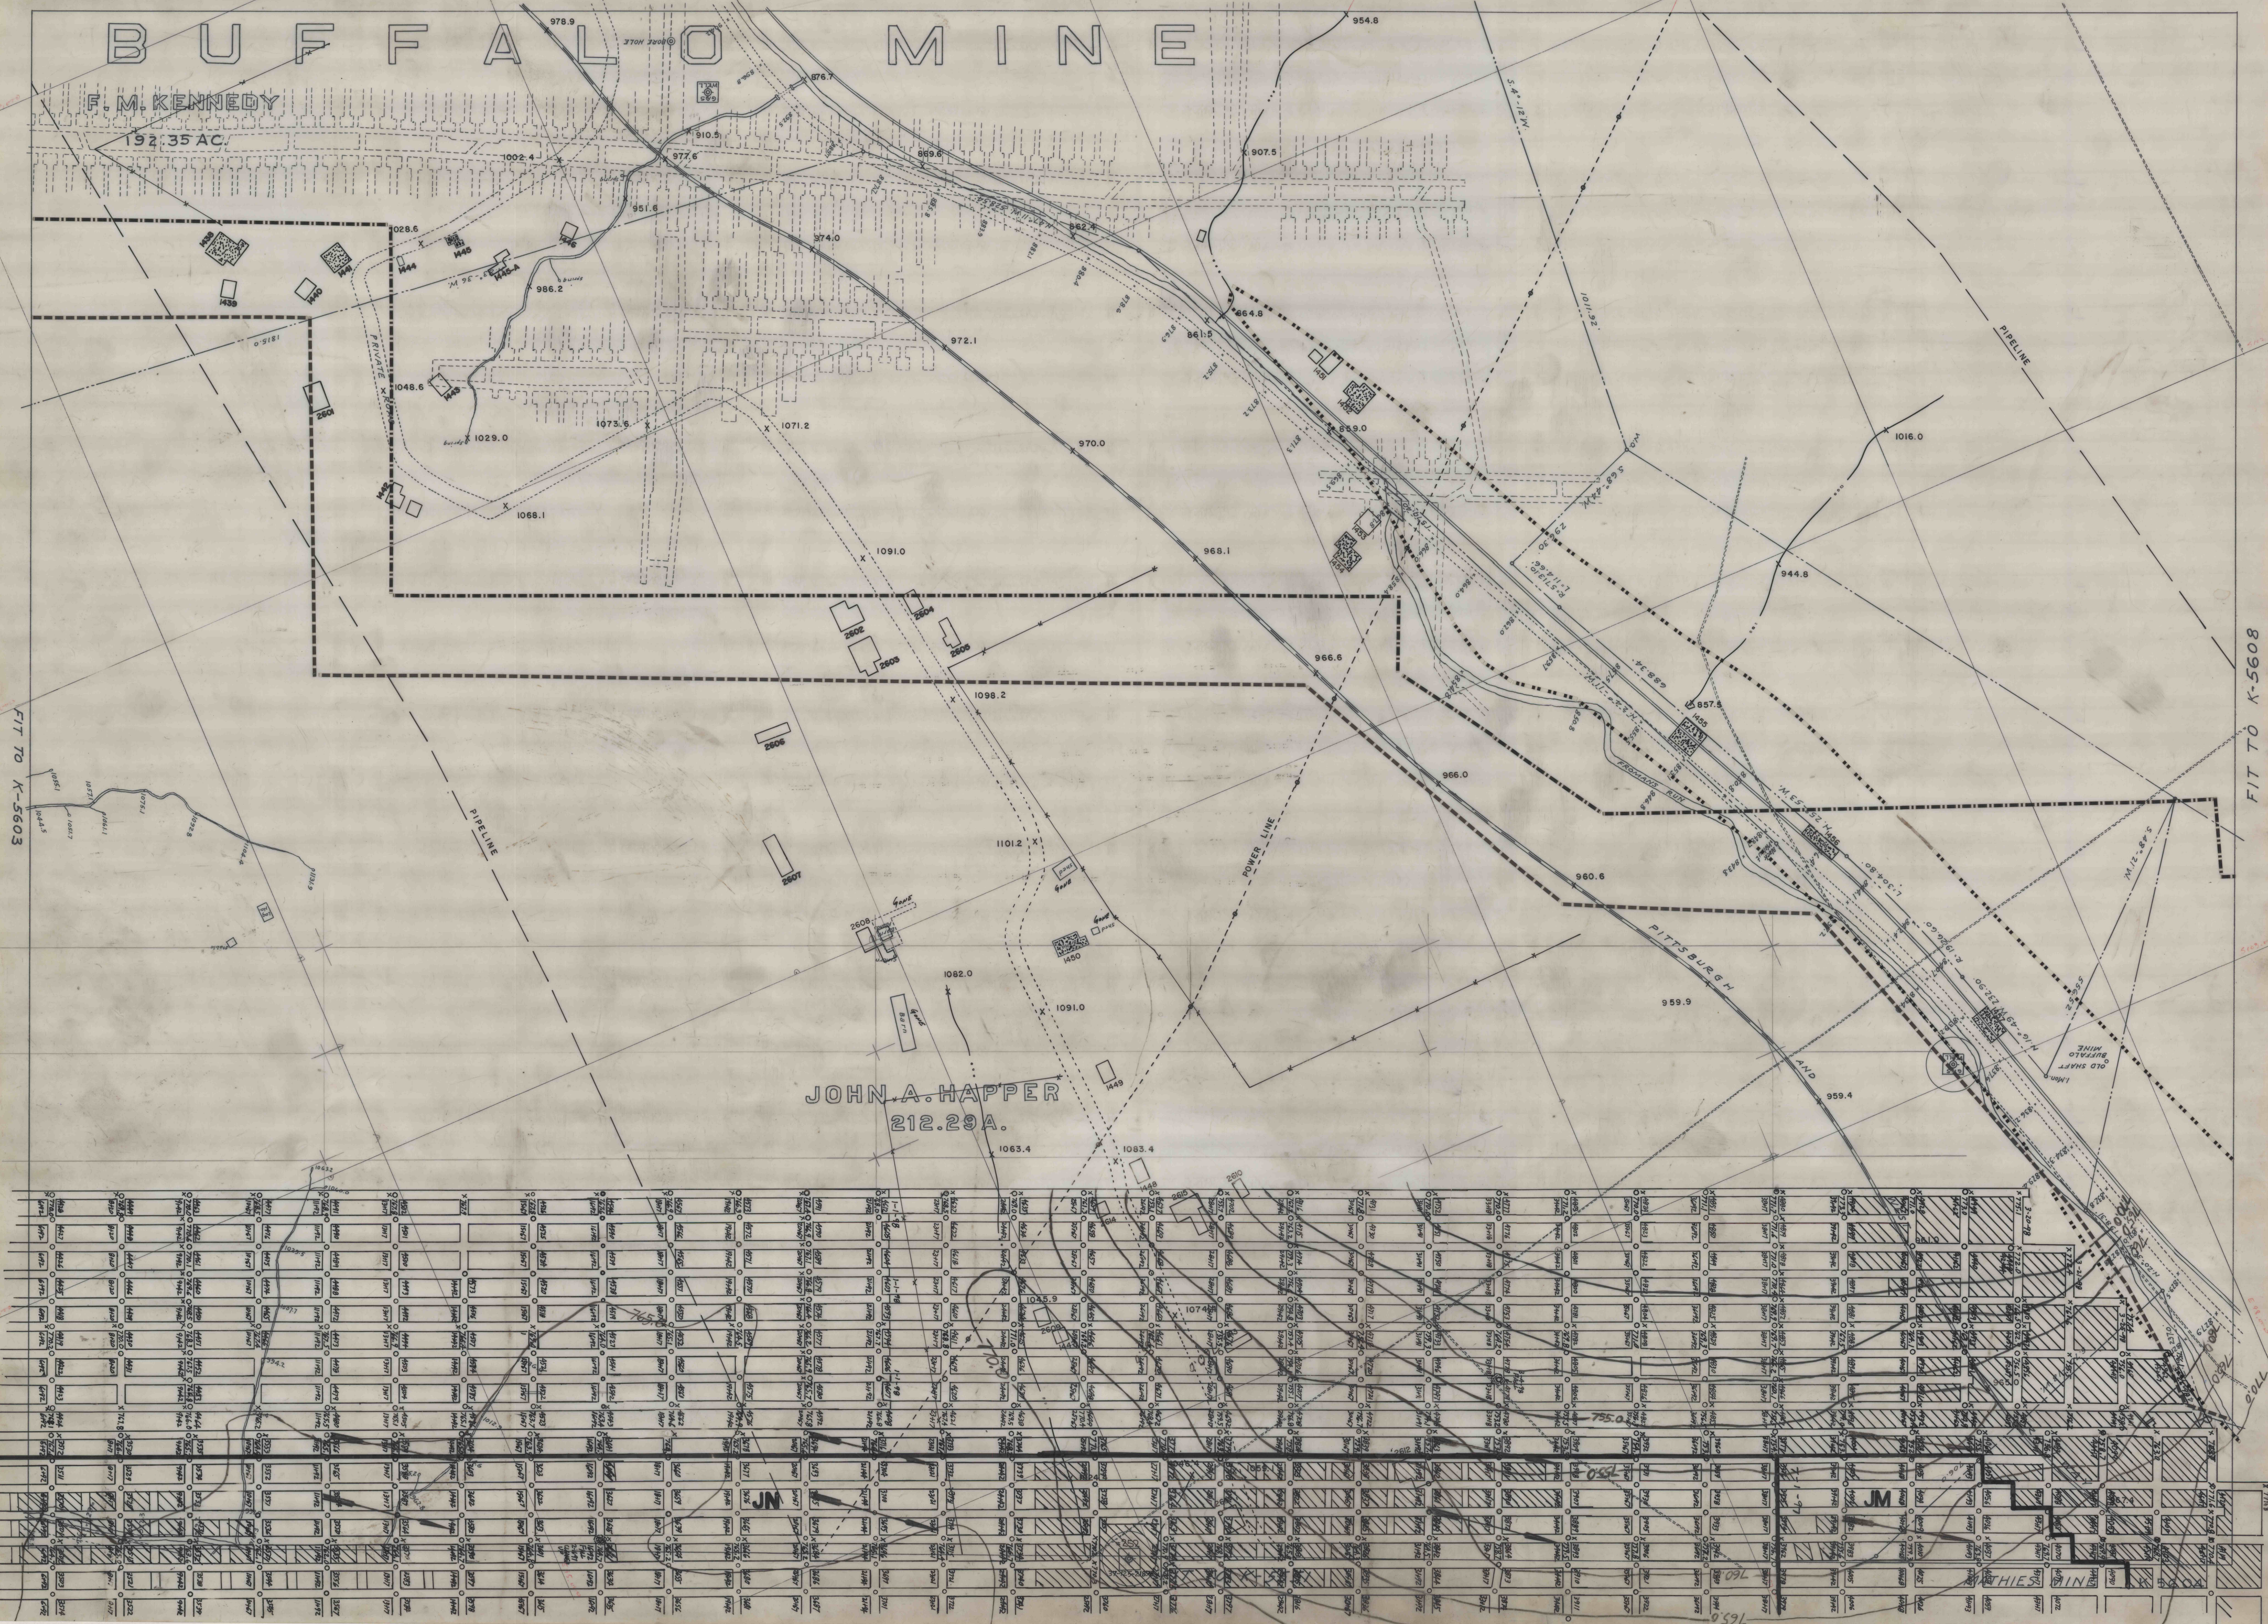

FIT TO K-5603

FIT TO K-5608


