


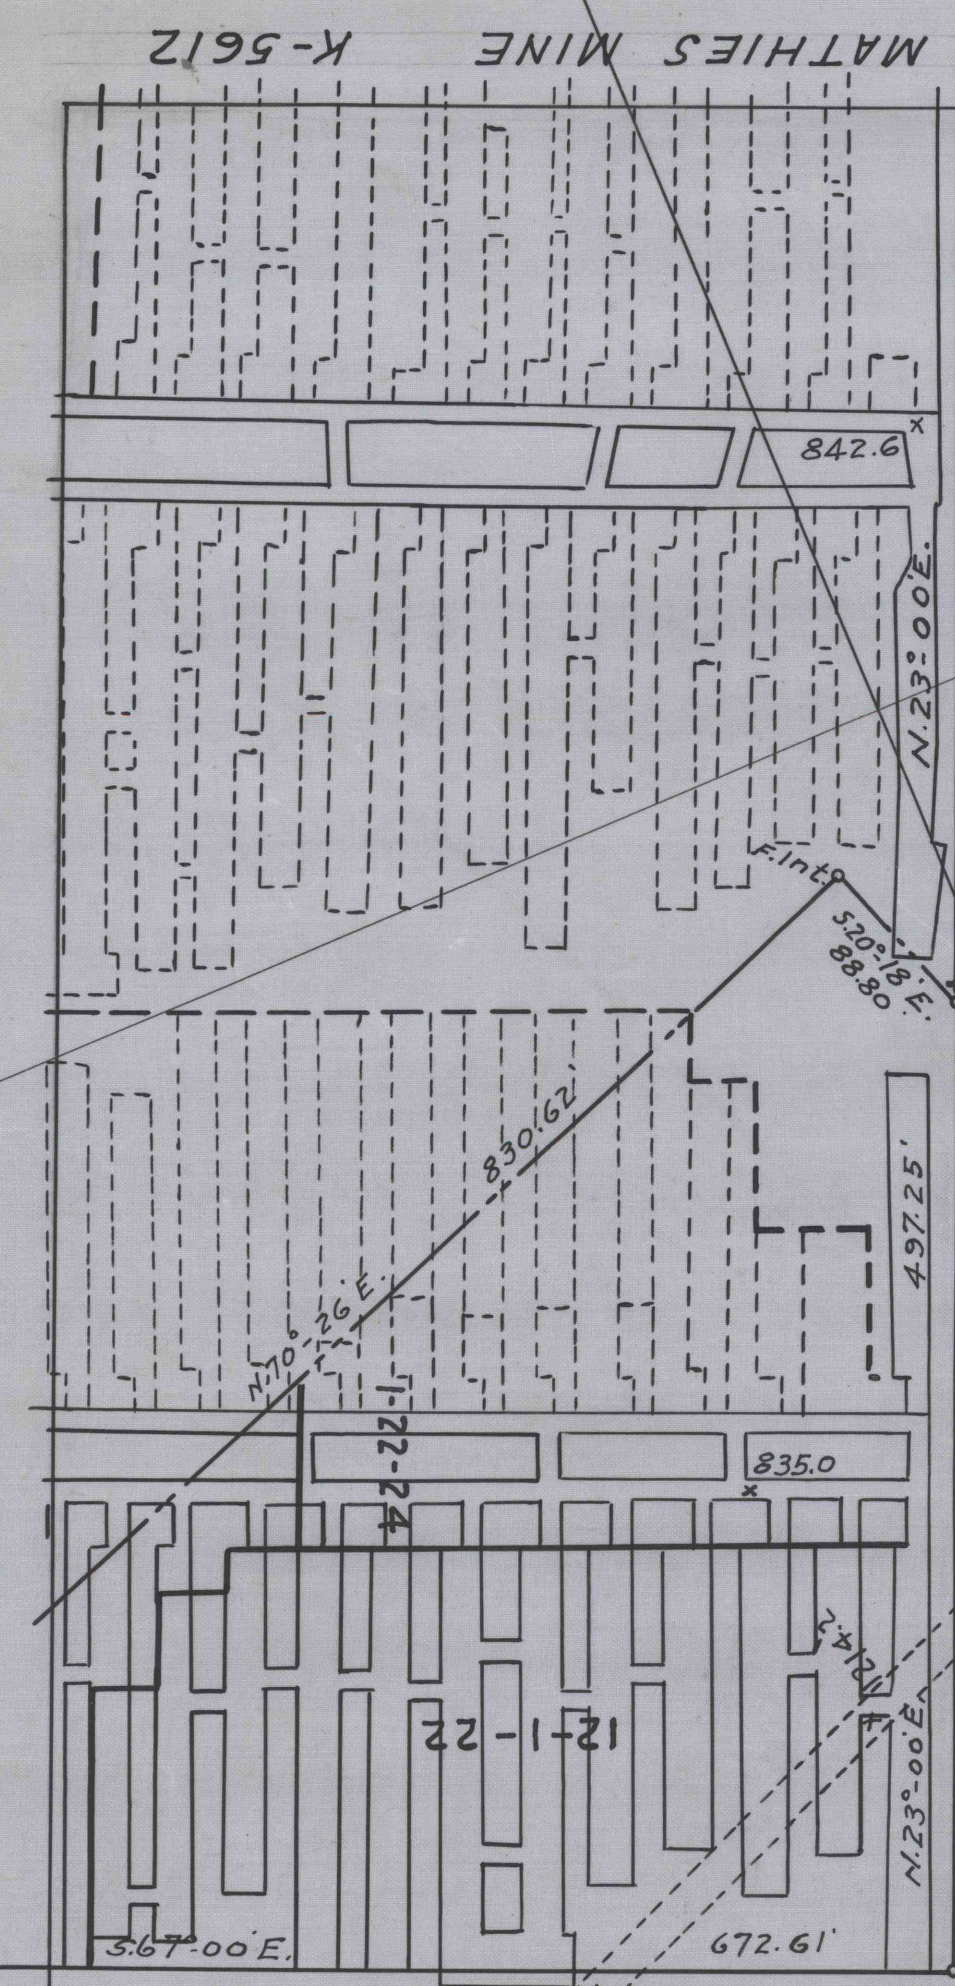

FIT TO K-5614


H. H. RAINEY
35.62 Ac.

MARG. BARKLEY
37.29 Ac.

AMOS H. CAESBAR
50.34 Ac.

WM. STEWART ET AL
126.46 Ac.

FIT TO K-5602

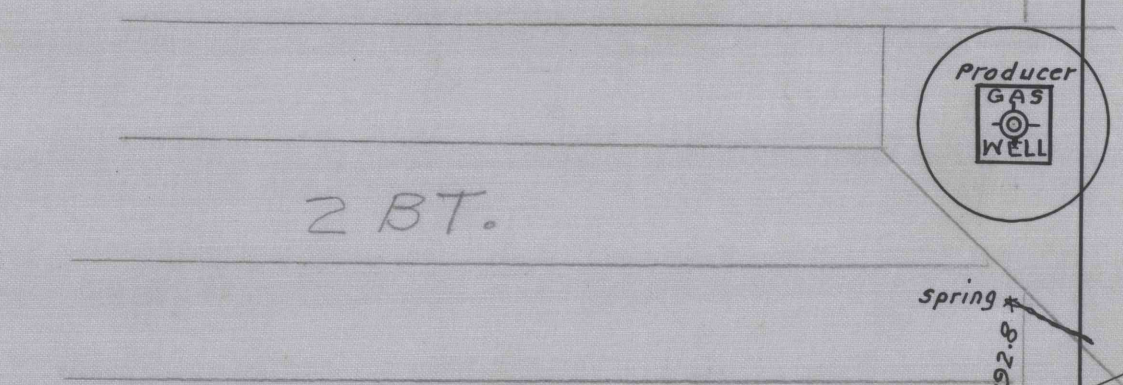

FIT TO K-5611

5109 MATHIES MINE K-5612