


BUFFALO MINE

F. M. KENNEDY

192.35 AC

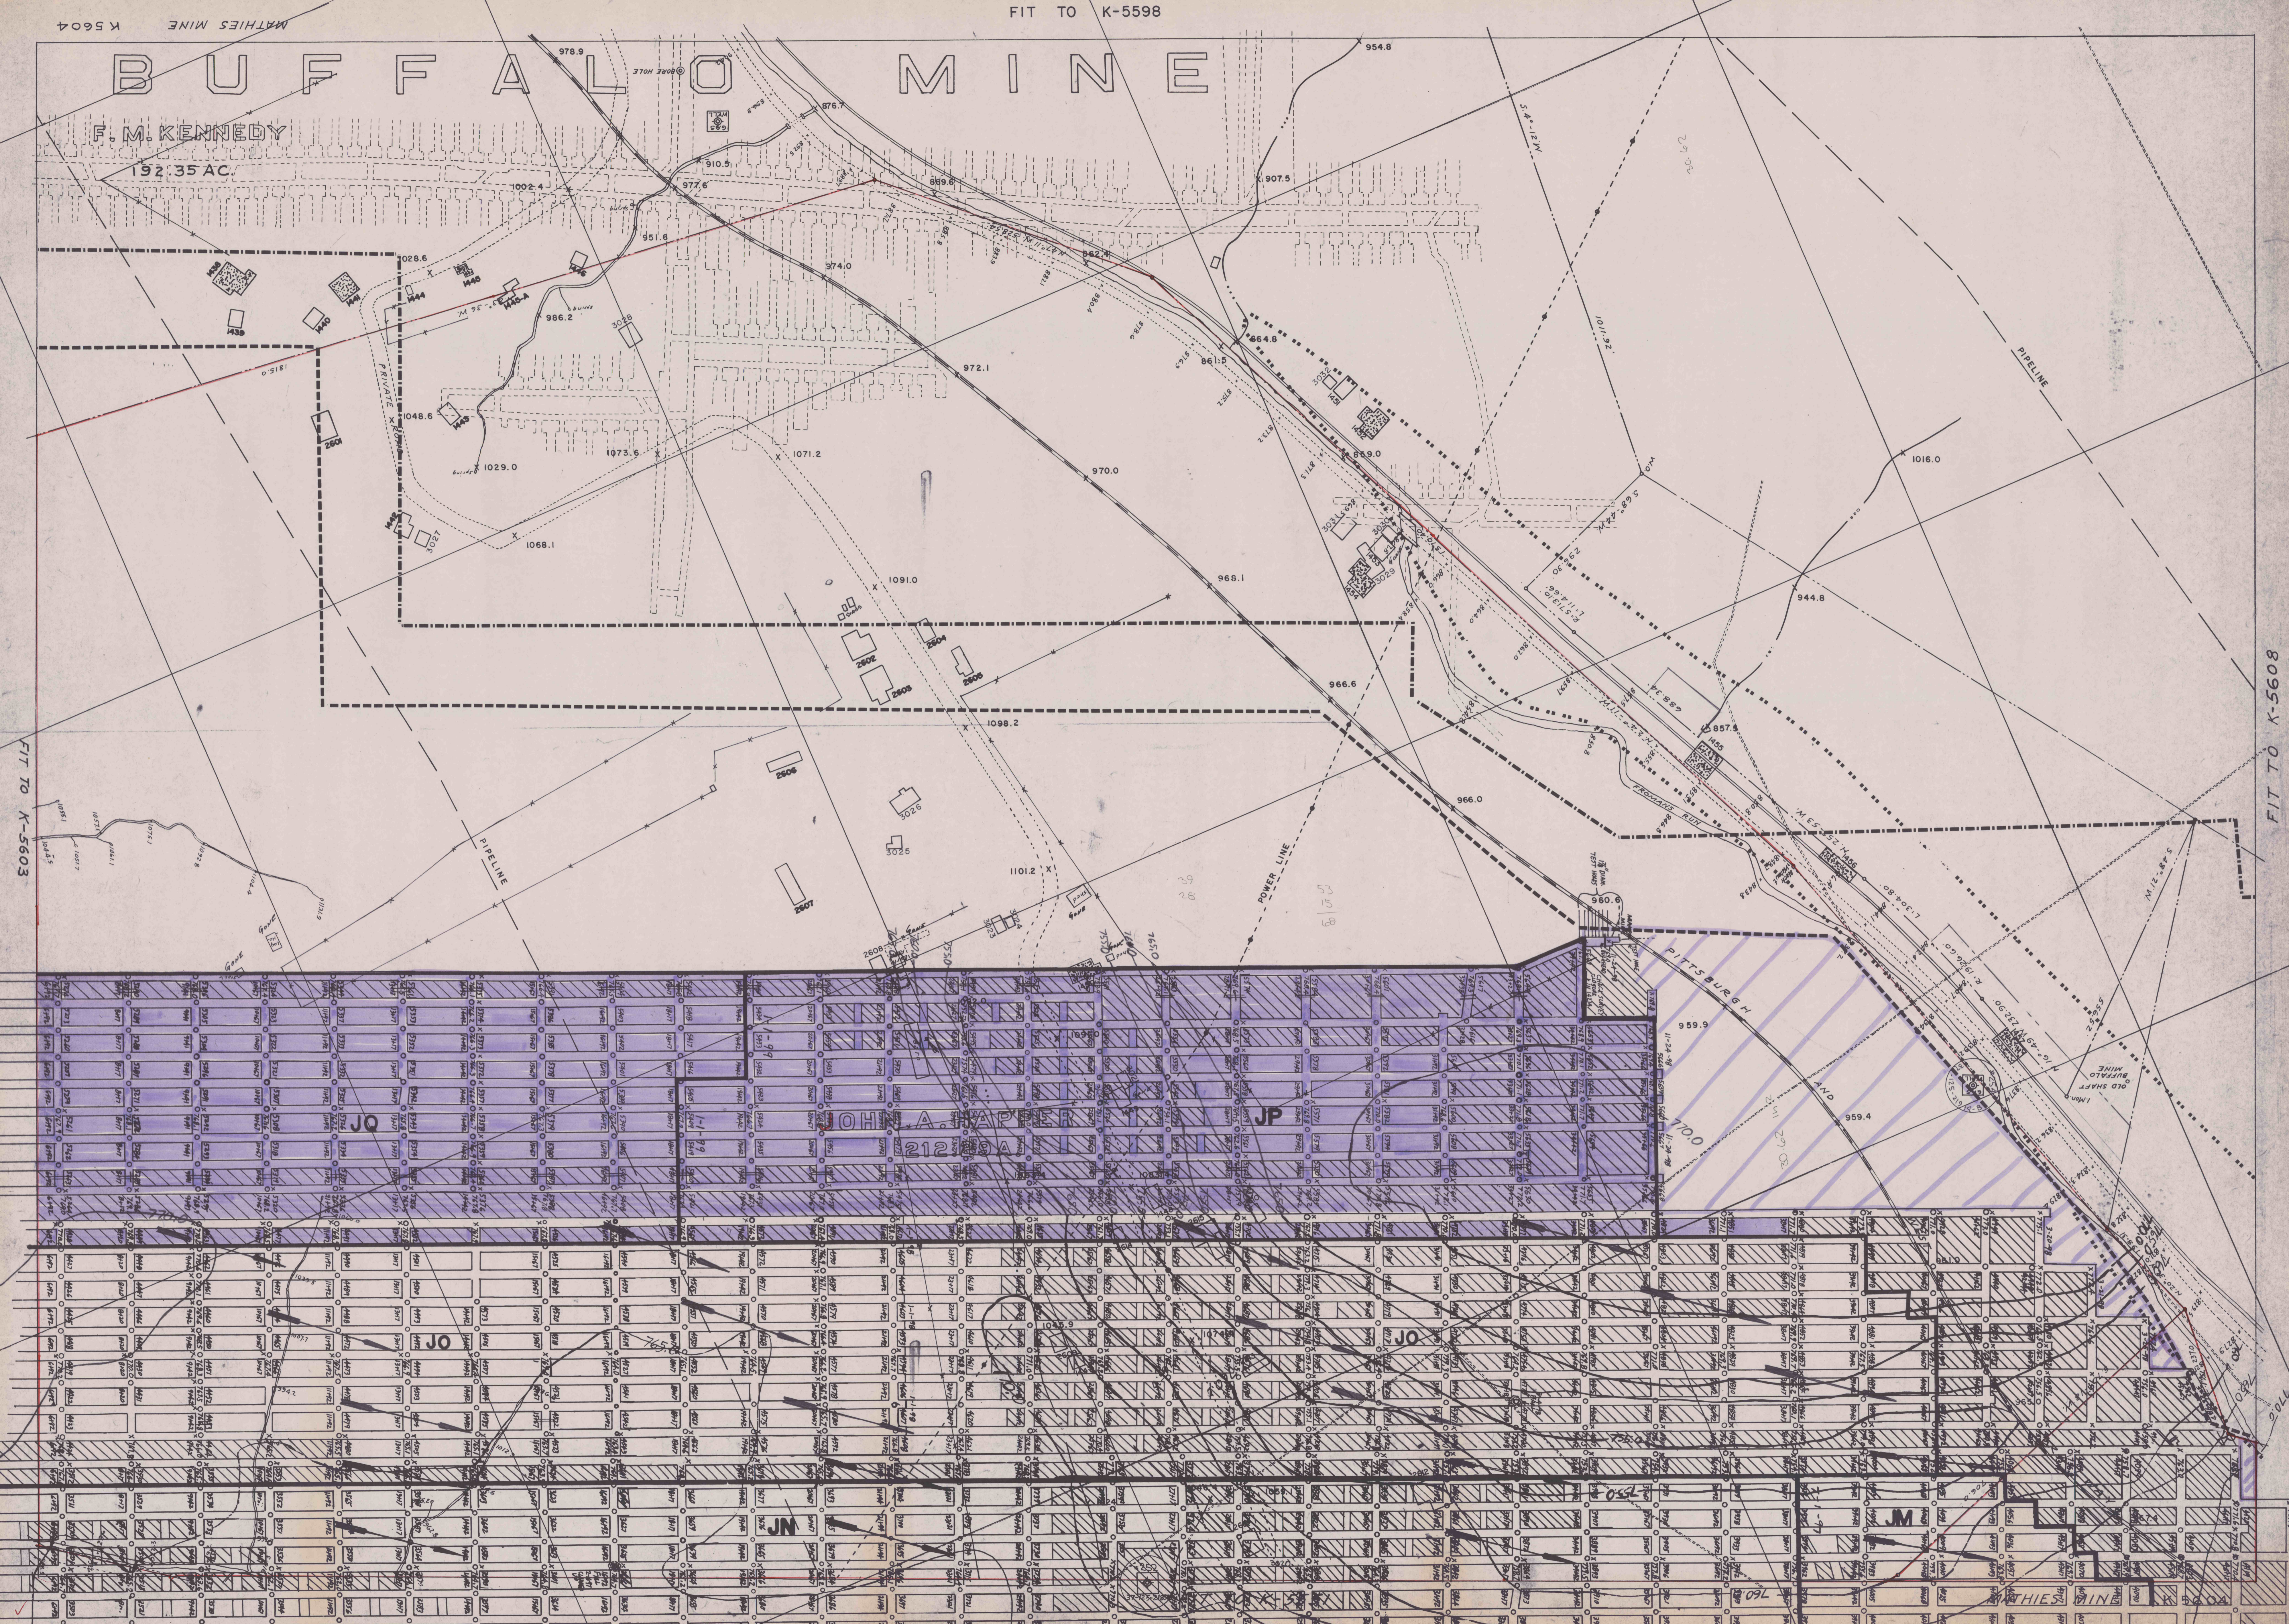

FIT TO K-5603

FIT TO K-5608