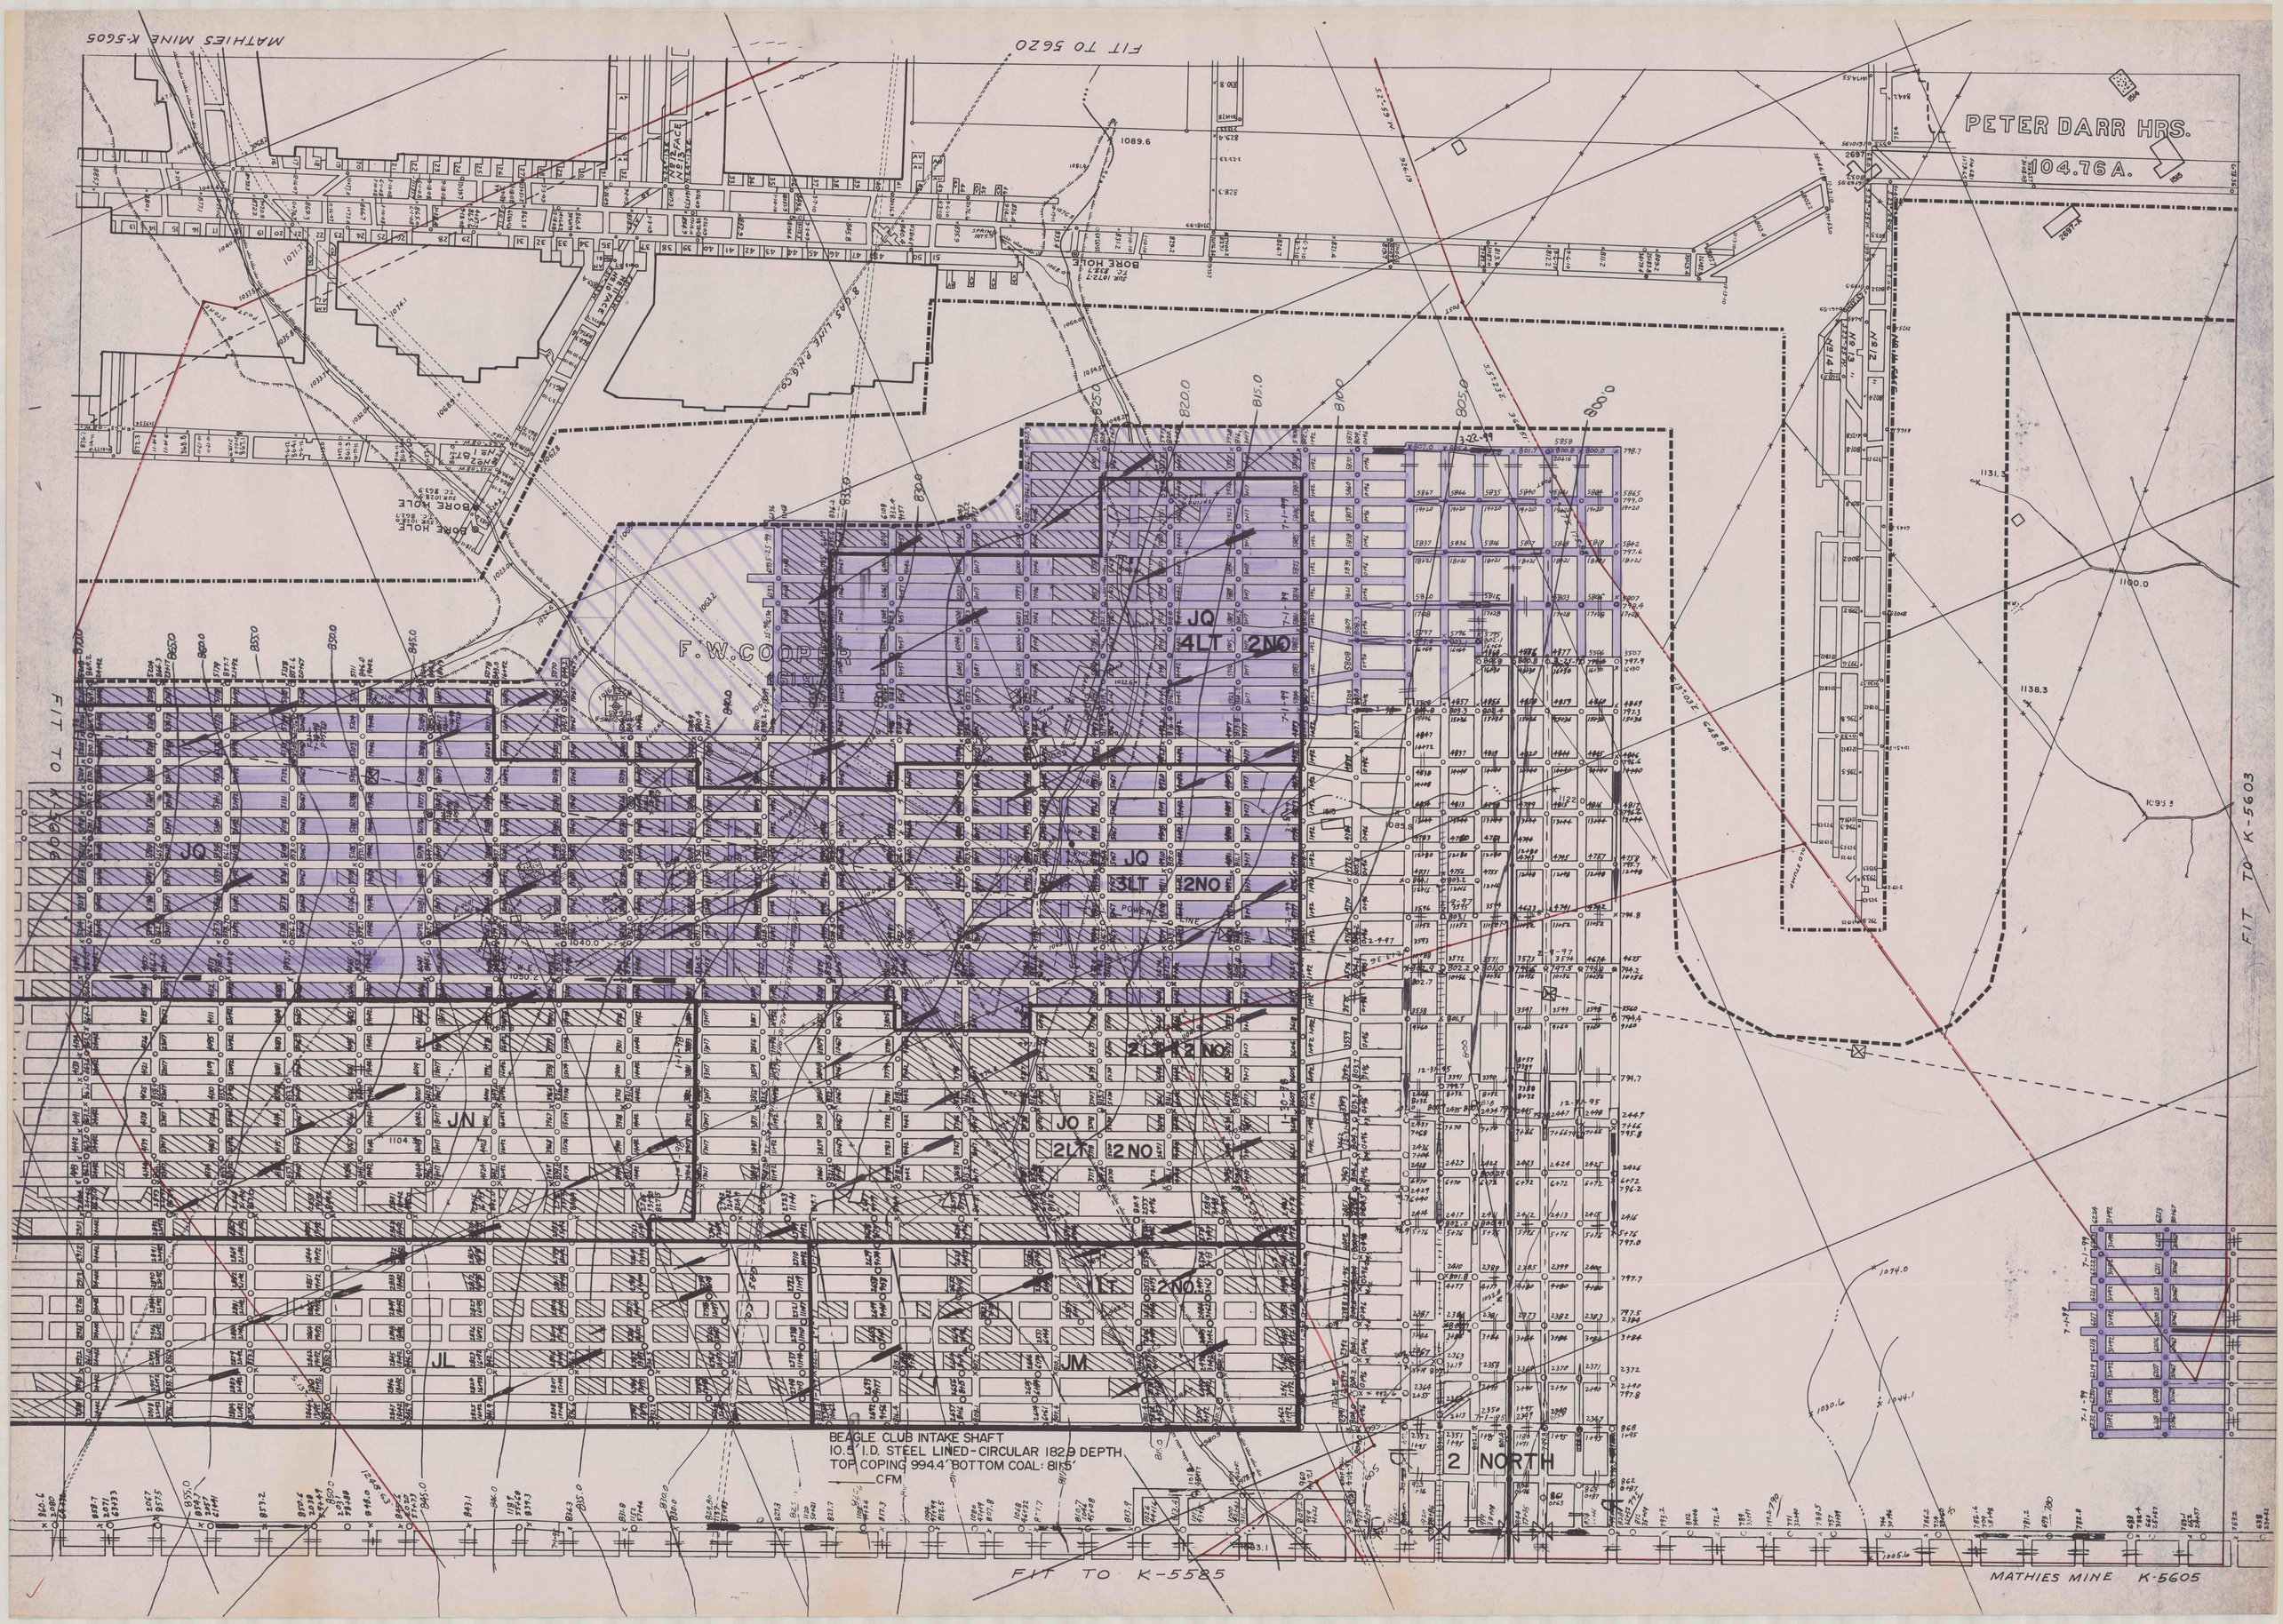
MATHIES MINE K-5605
FIT TO 5620
PETER DARR HRS.
104.76A.
F.W.COOP
JQ
4LT
2NO
3LT
2NO
2LT
2NO
JN
JL
JM
2 NORTH
FIT TO K-5603
FIT TO K-5585
MATHIES MINE K-5605
BEAGLE CLUB INTAKE SHAFT
10.5' I.D. STEEL LINED-CIRCULAR 182.9 DEPTH
TOP COPING 994.4' BOTTOM COAL: 811.5'
CFM