


Nelson H. Boyd

Wm. McMichael

BF Scott

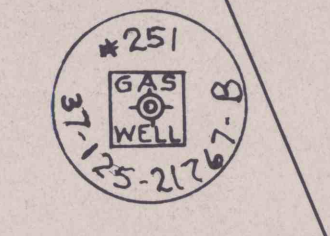

MINGO INTAKE SHAFT - TWO COMPARTMENT
CONCRETE LINED - RECTANGULAR 12'x21.8'
TOP COPING: 835.6' BOTTOM COAL: 779.4'
DEPTH: 56.2' STAIRWAY DEPTH: 38.8'
CFM