

MATHIES MINE K-5605

FIT TO 5620

PETER DARR HRS.

104.76 A.

F. W. COOPER


POWER LINE

FIT TO K-5585

MATHIES MINE K-5605

FIT TO K-5606

FIT TO K-5603

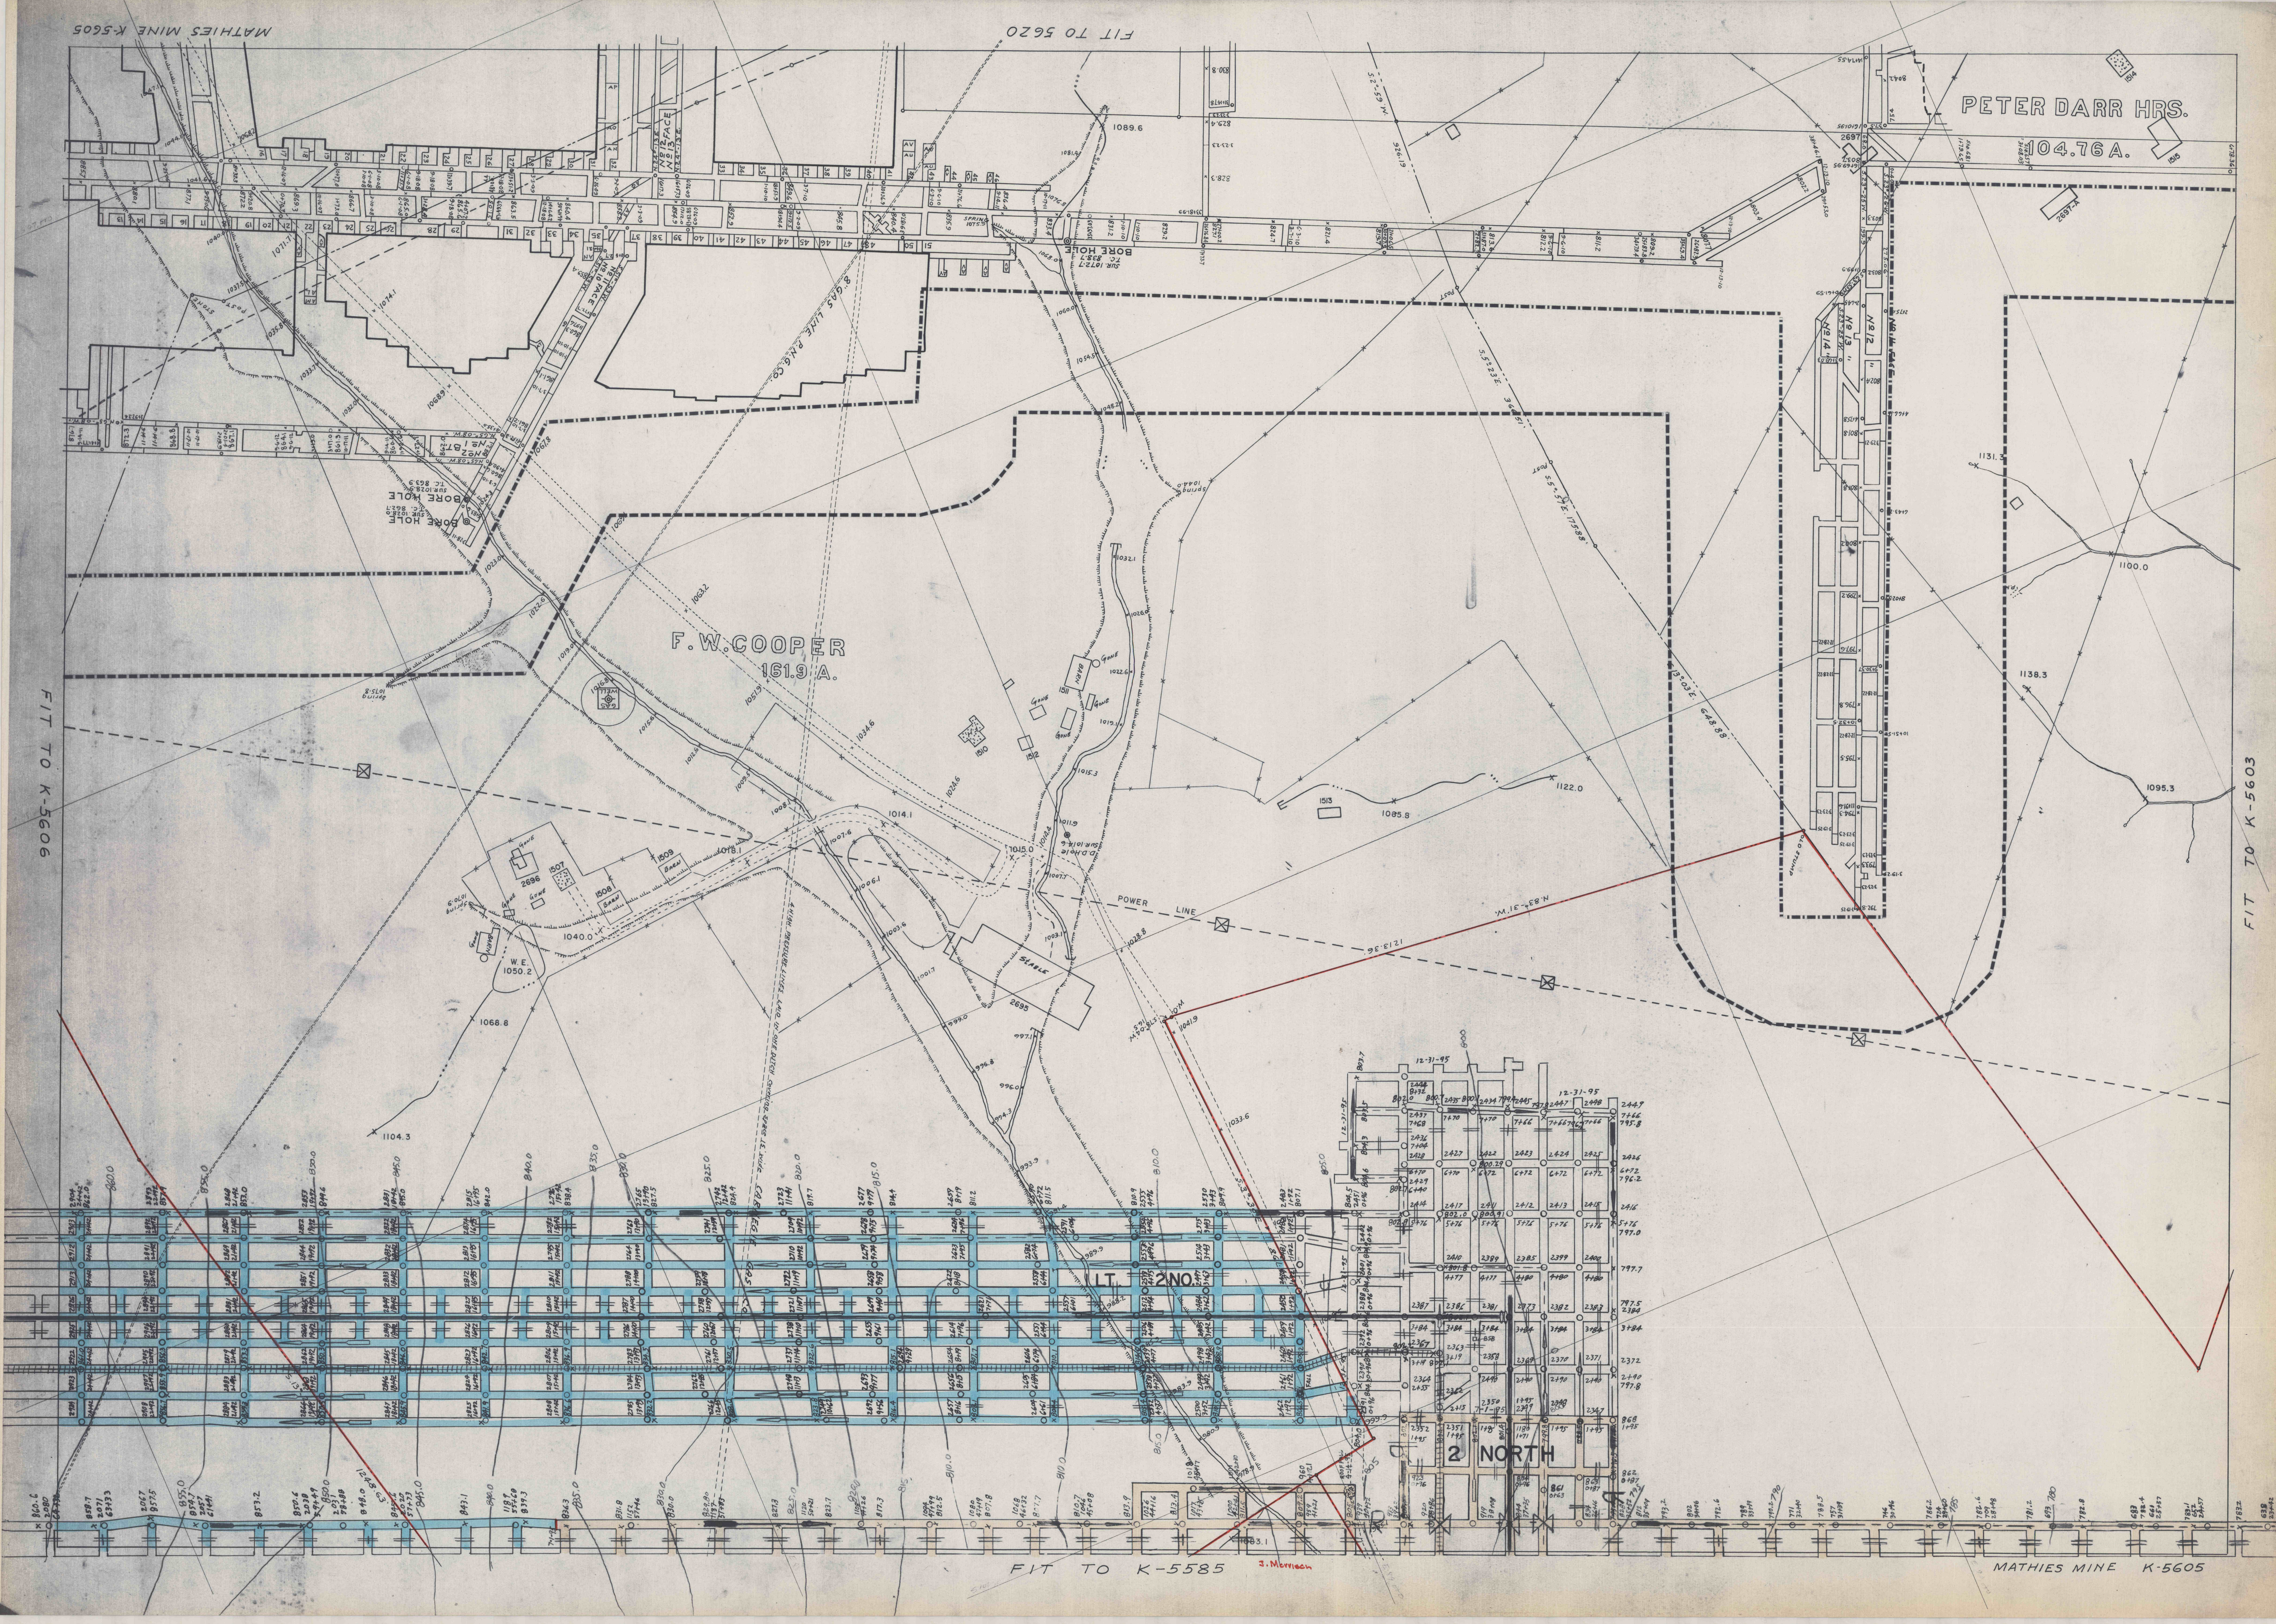

2 NORTH

J. Norman