


S. J. OPENSHAW
2.318 Acs.
MATHIES C. CO. SURF
1004.3

1019.8
ANTON BOBNAR
6.448 Acs.
MATHIES C. CO. SURF

LOUISA CAMPBELL

TOTAL AREA	2594 AC.
LESS 50% OF 1674	0.84 " R OF W.
	25.10 " NET SURF.
LESS 40% OF 128A	0.51 " GAS LINE SUP.
	24.59 " NET COAL AREA

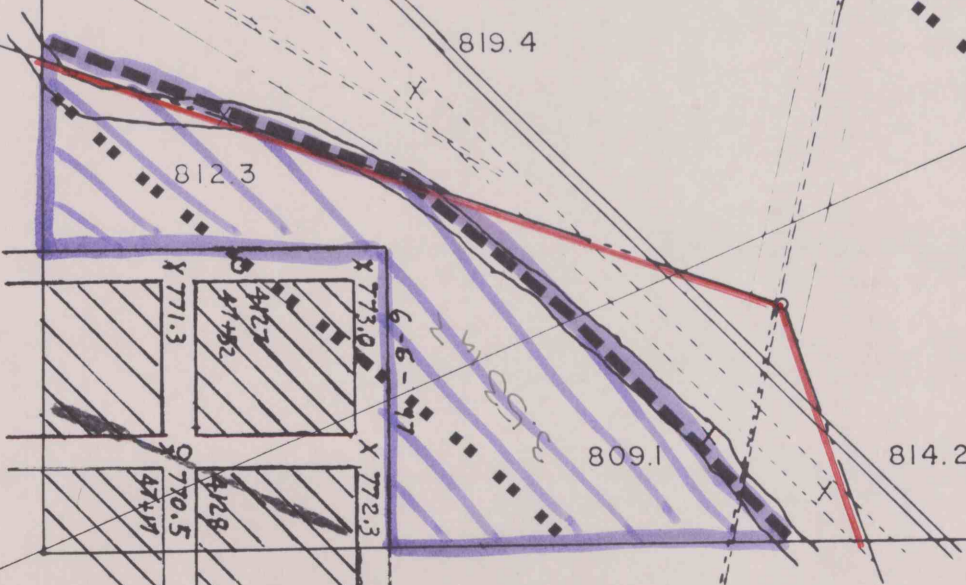

FIT TO K-5604

FIT 7