



BUFFALO MINE

F. M. KENNEDY

192.35 AC

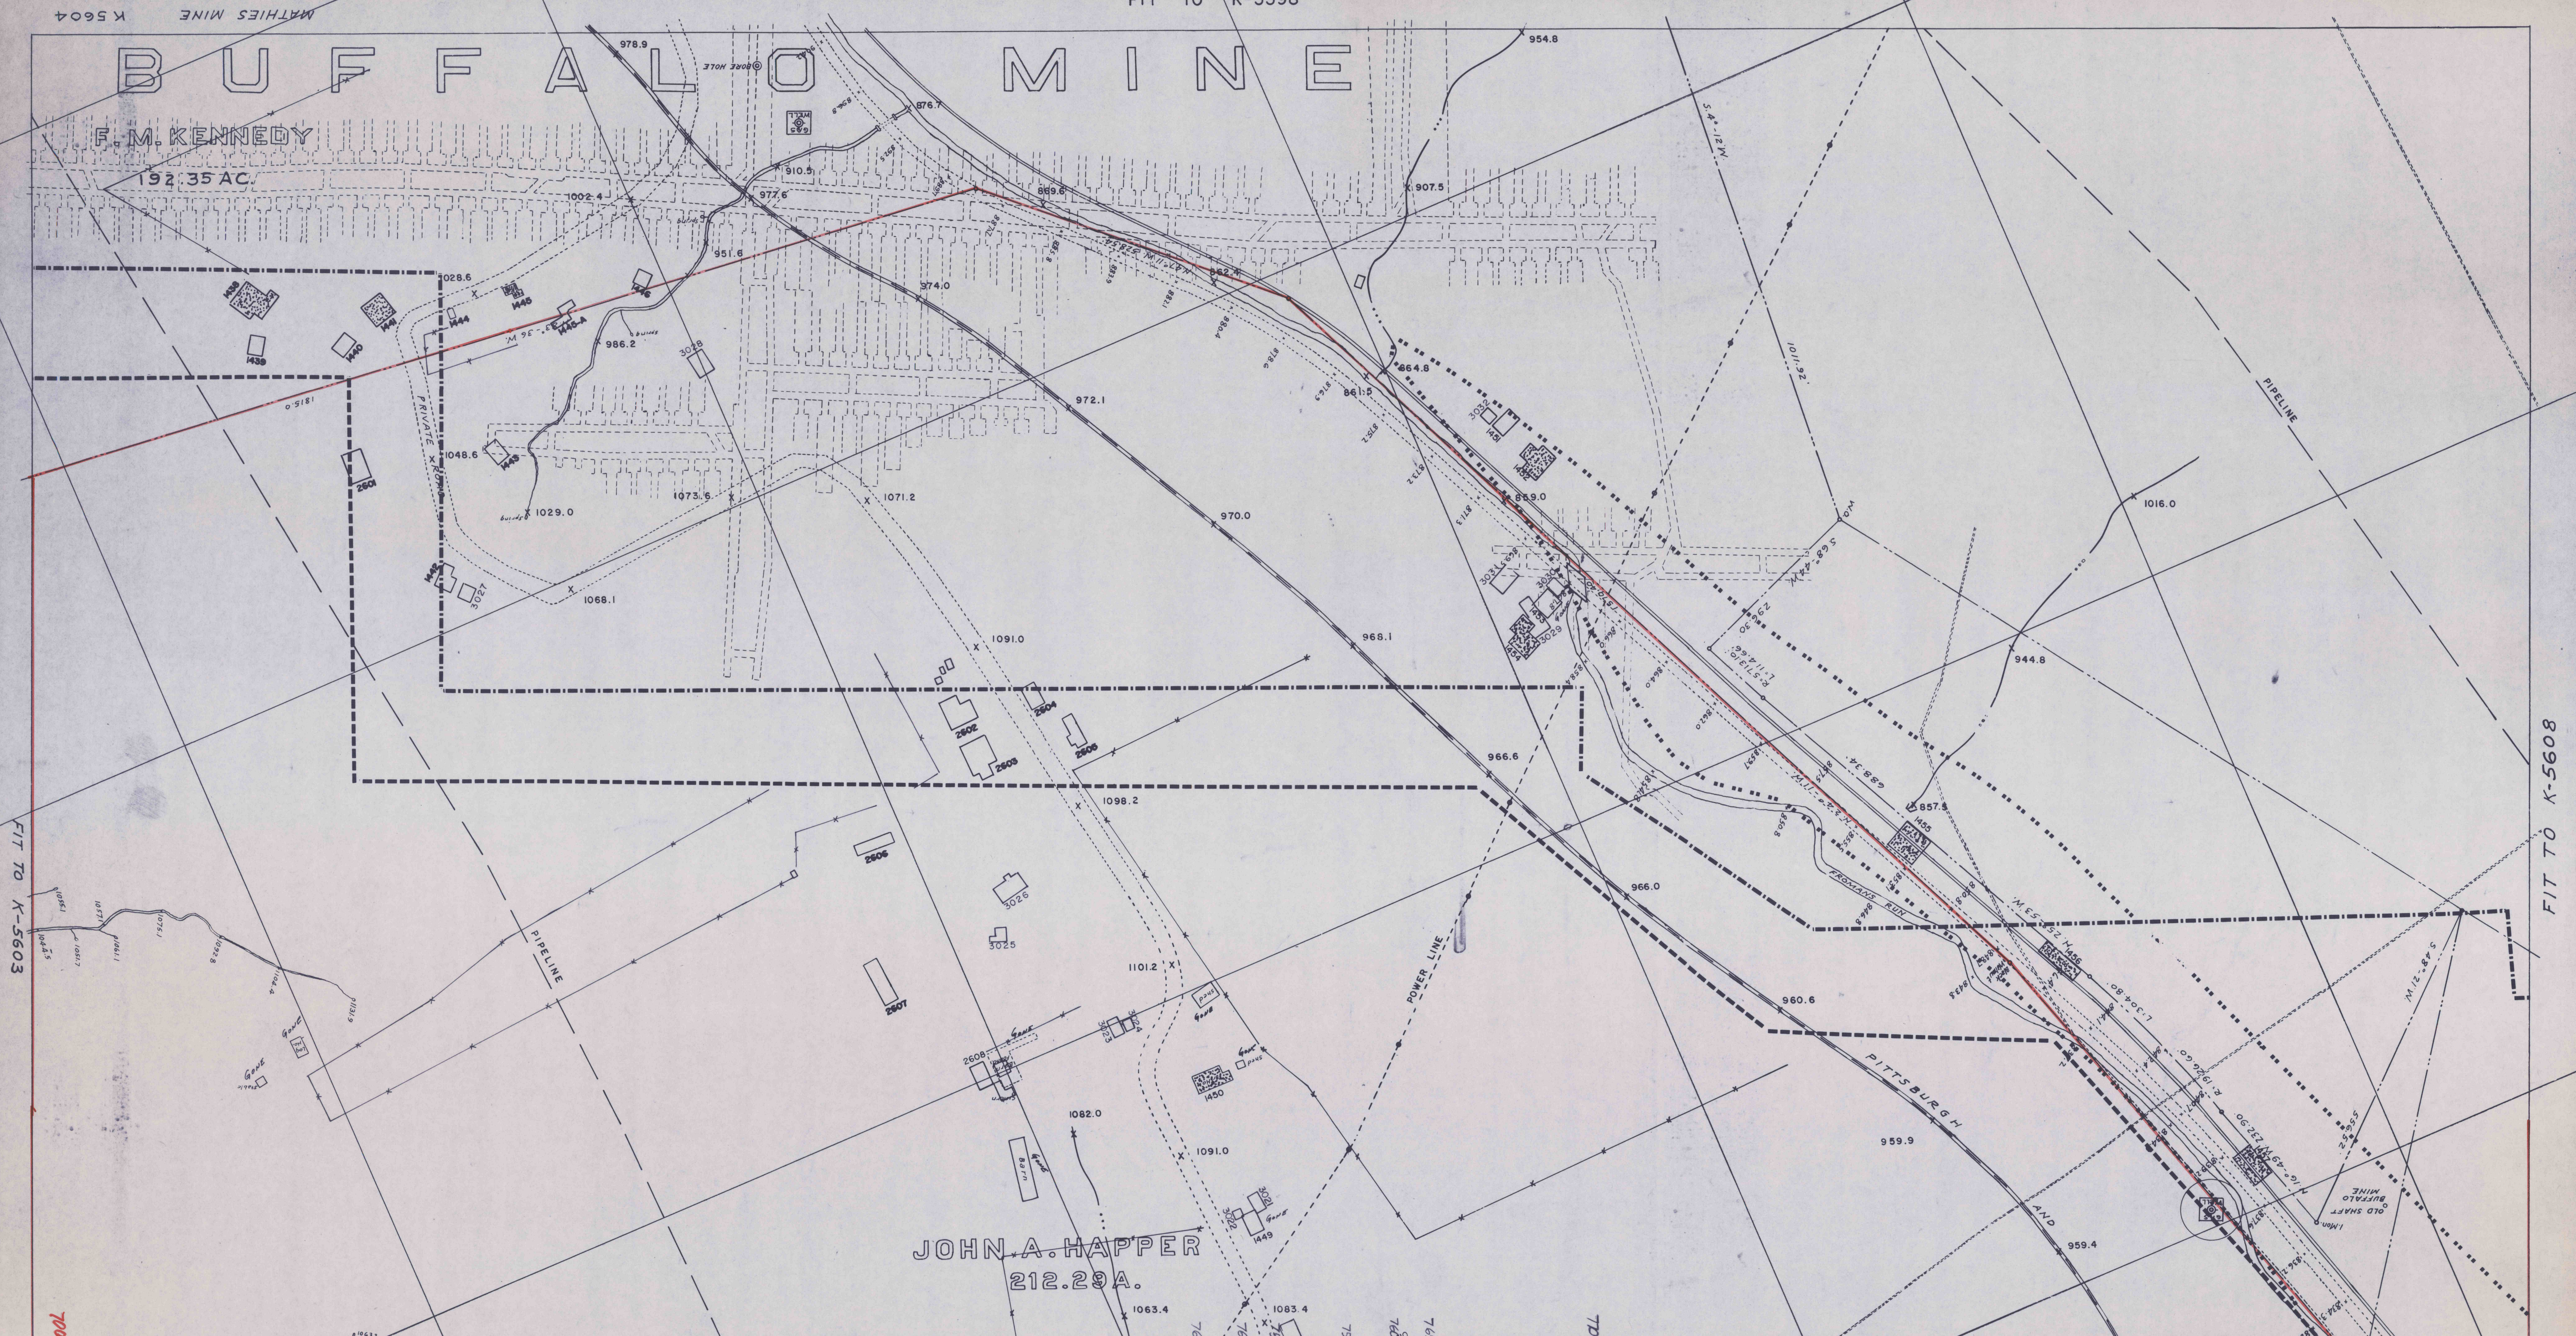

JOHN A. HAPPER
212.29A.

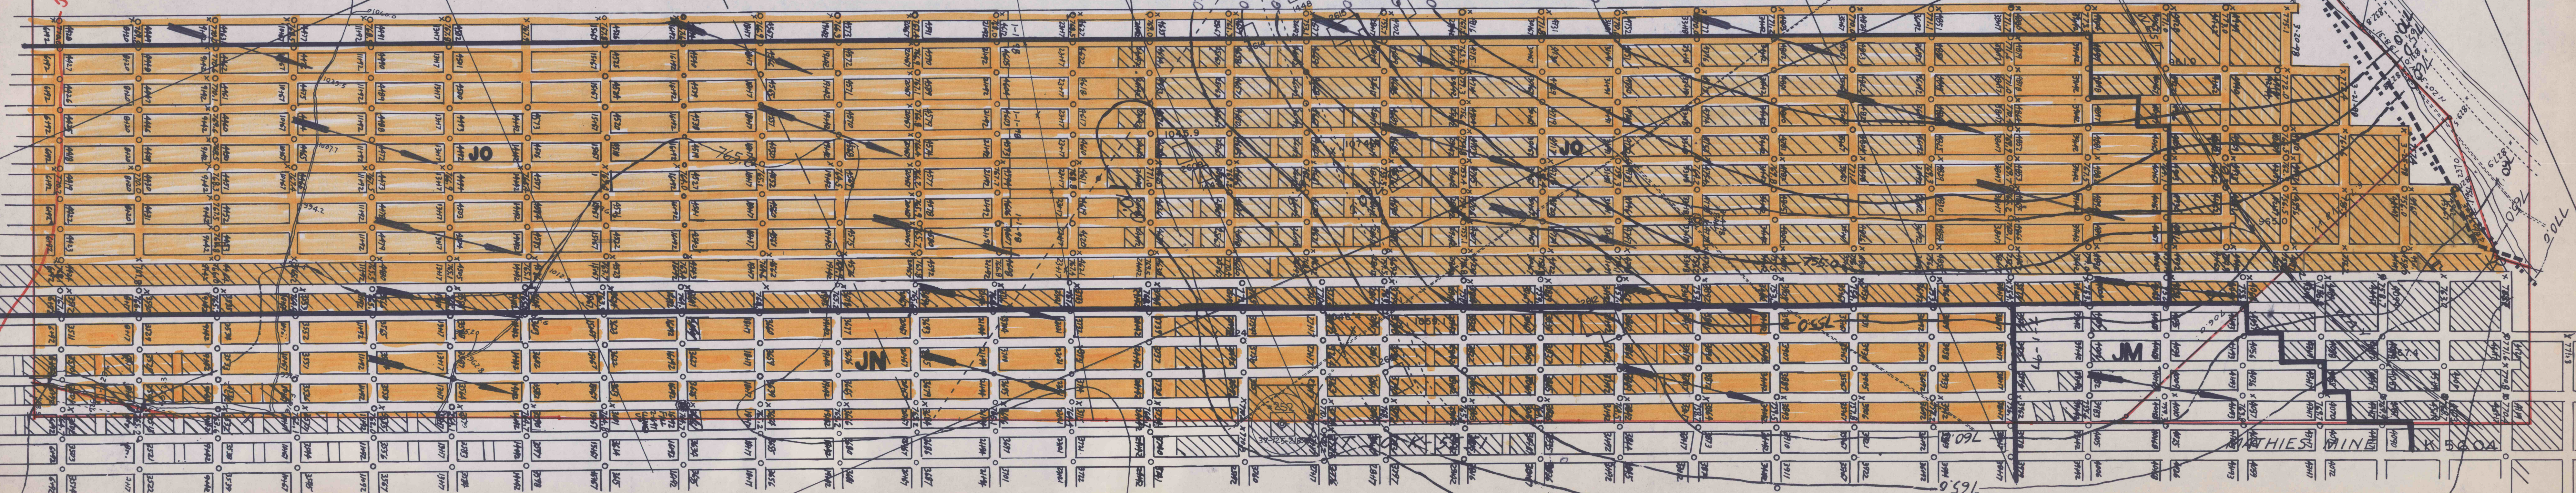

FIT TO K-5603

FIT TO K-5608