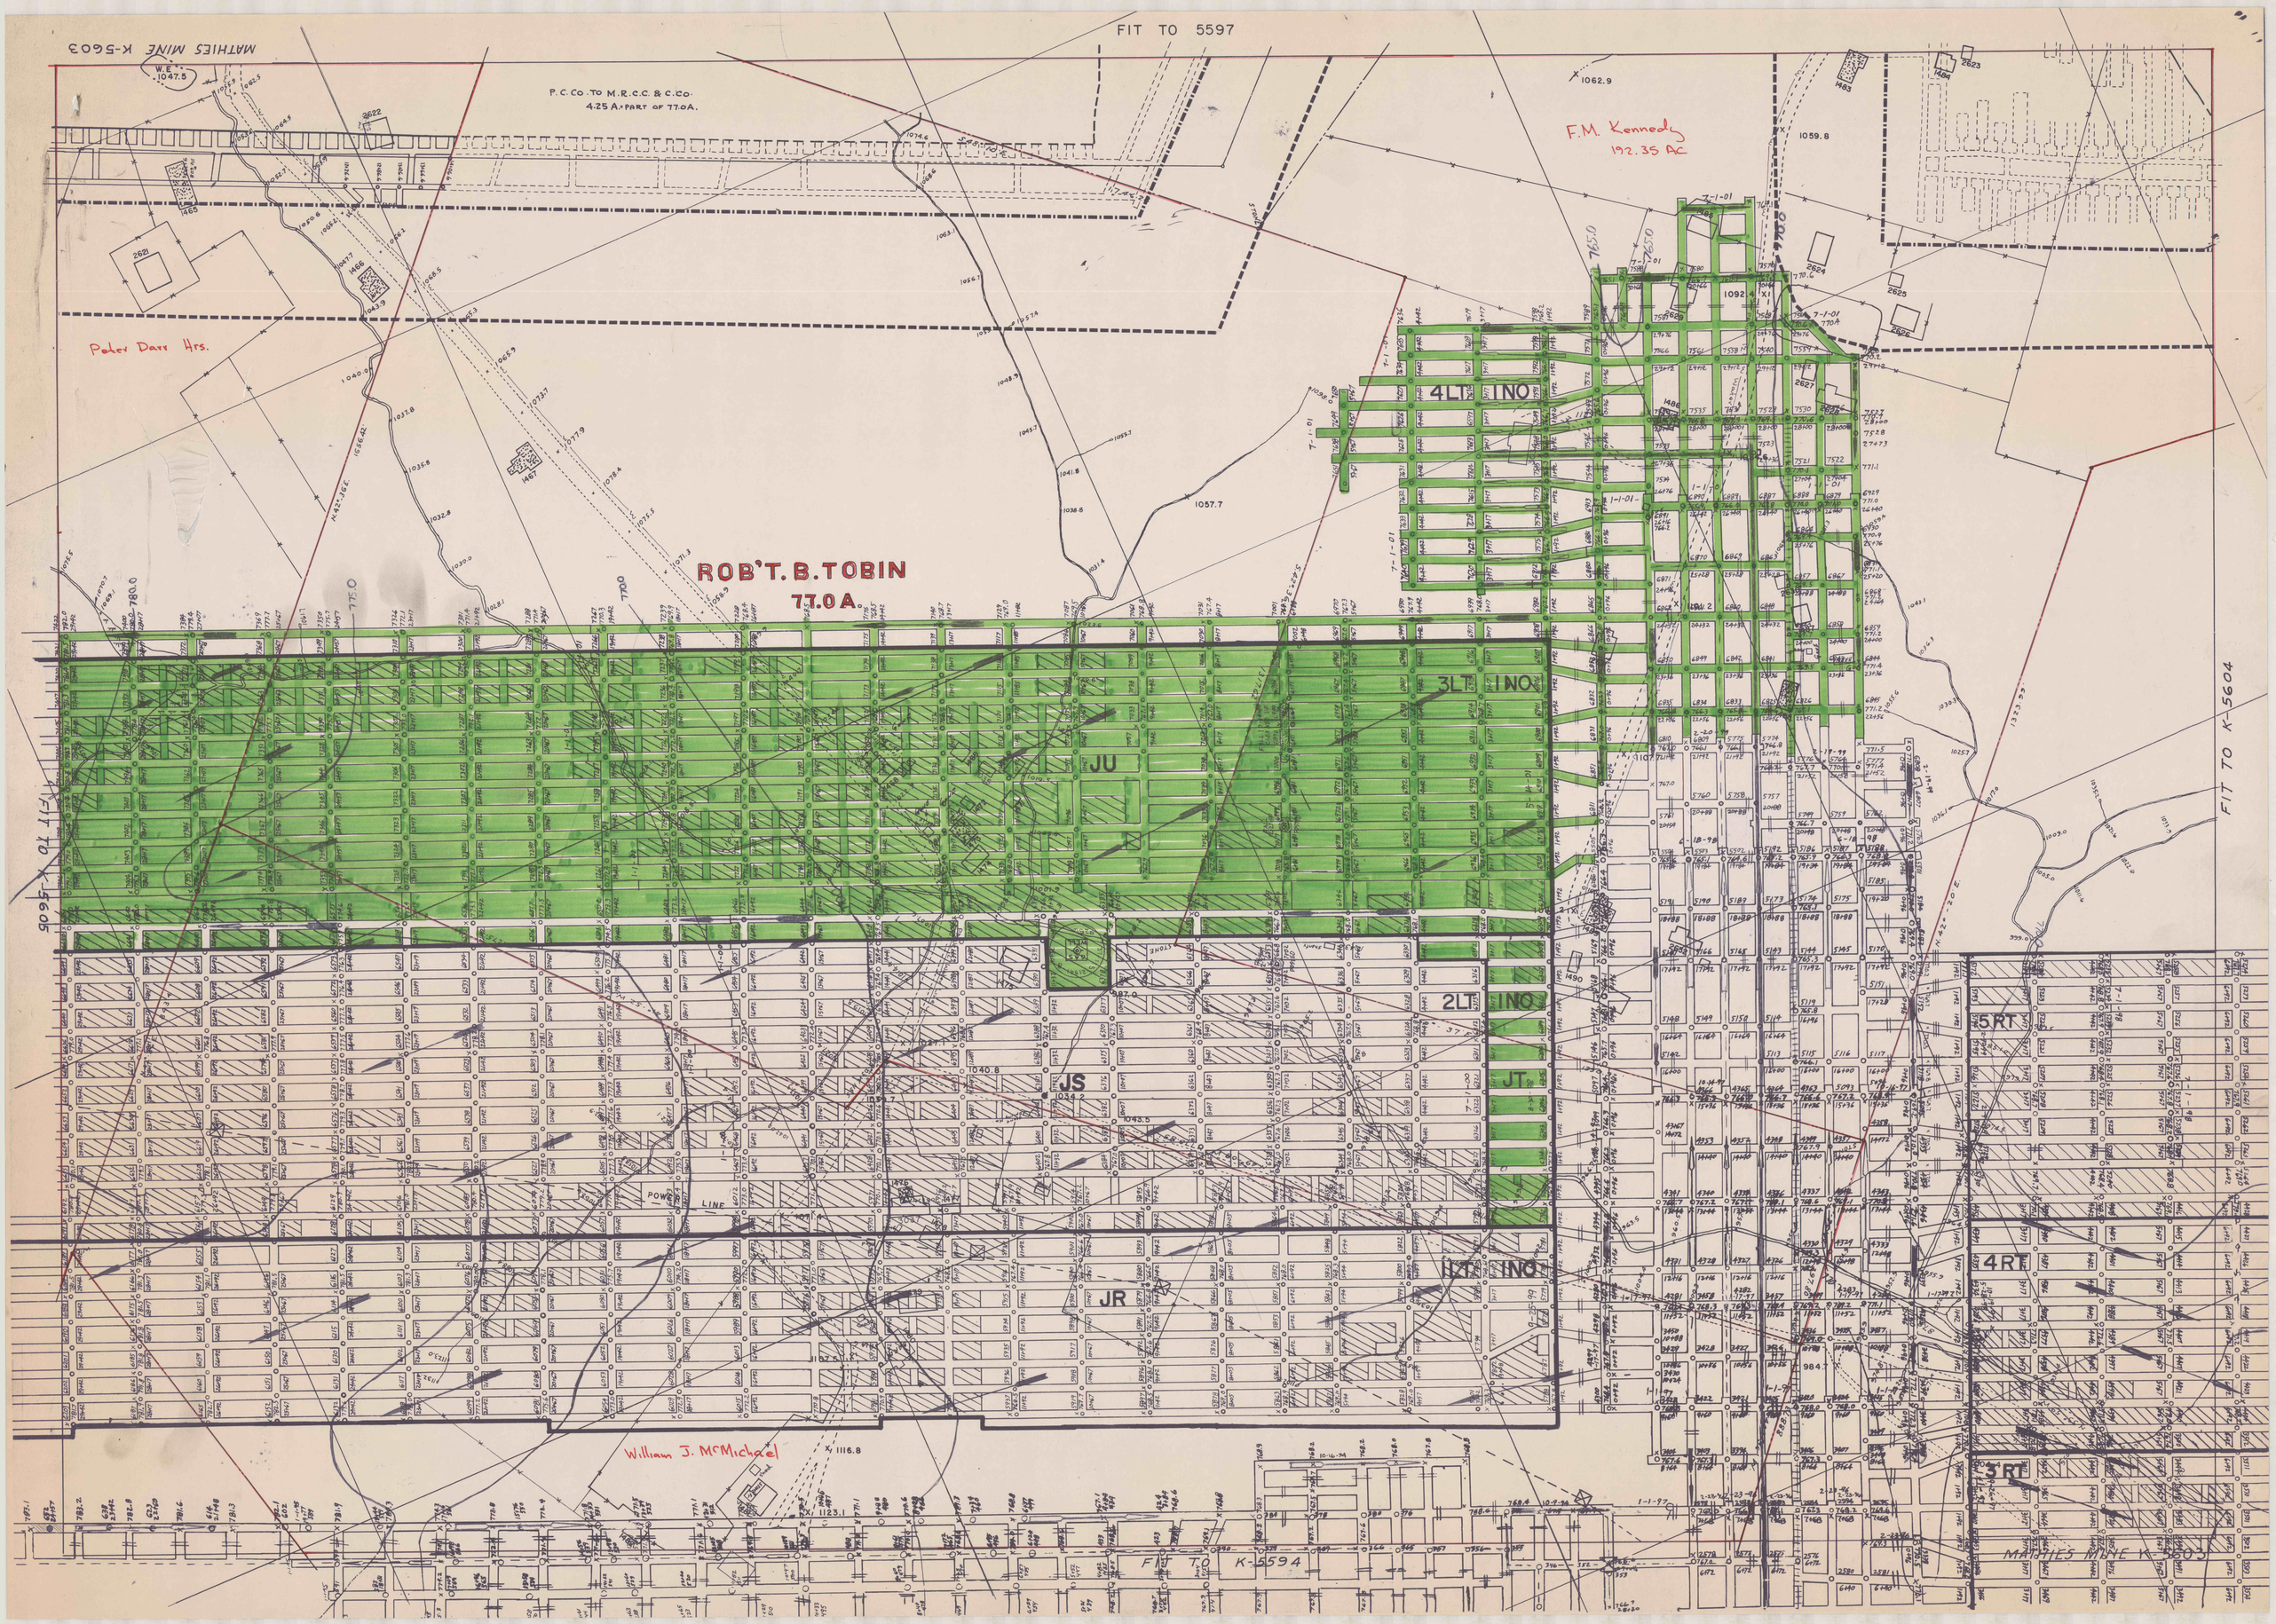
FIT TO 5597
MATHIES MINE K-5603
P.C.Co. TO M.R.C.C. & C.Co.
4.25 A. PART OF 77.0A.
F.M. Kennedy
192.35 AC
Peter Darr Hrs.
ROB'T. B. TOBIN
77.0 A.
4LT
1NO
3LT
1NO
2LT
1NO
1LT
1NO
JU
JS
JT
JR
5RT
4RT
3RT
POWER LINE
William J. McMichael
FIT TO K-5594
FIT TO K-5605
FIT TO K-5604
MATHIES MINE K-5603