


MATHIES MINE K-5620
(CINCINNATI SEC.)

FIT TO K-5619

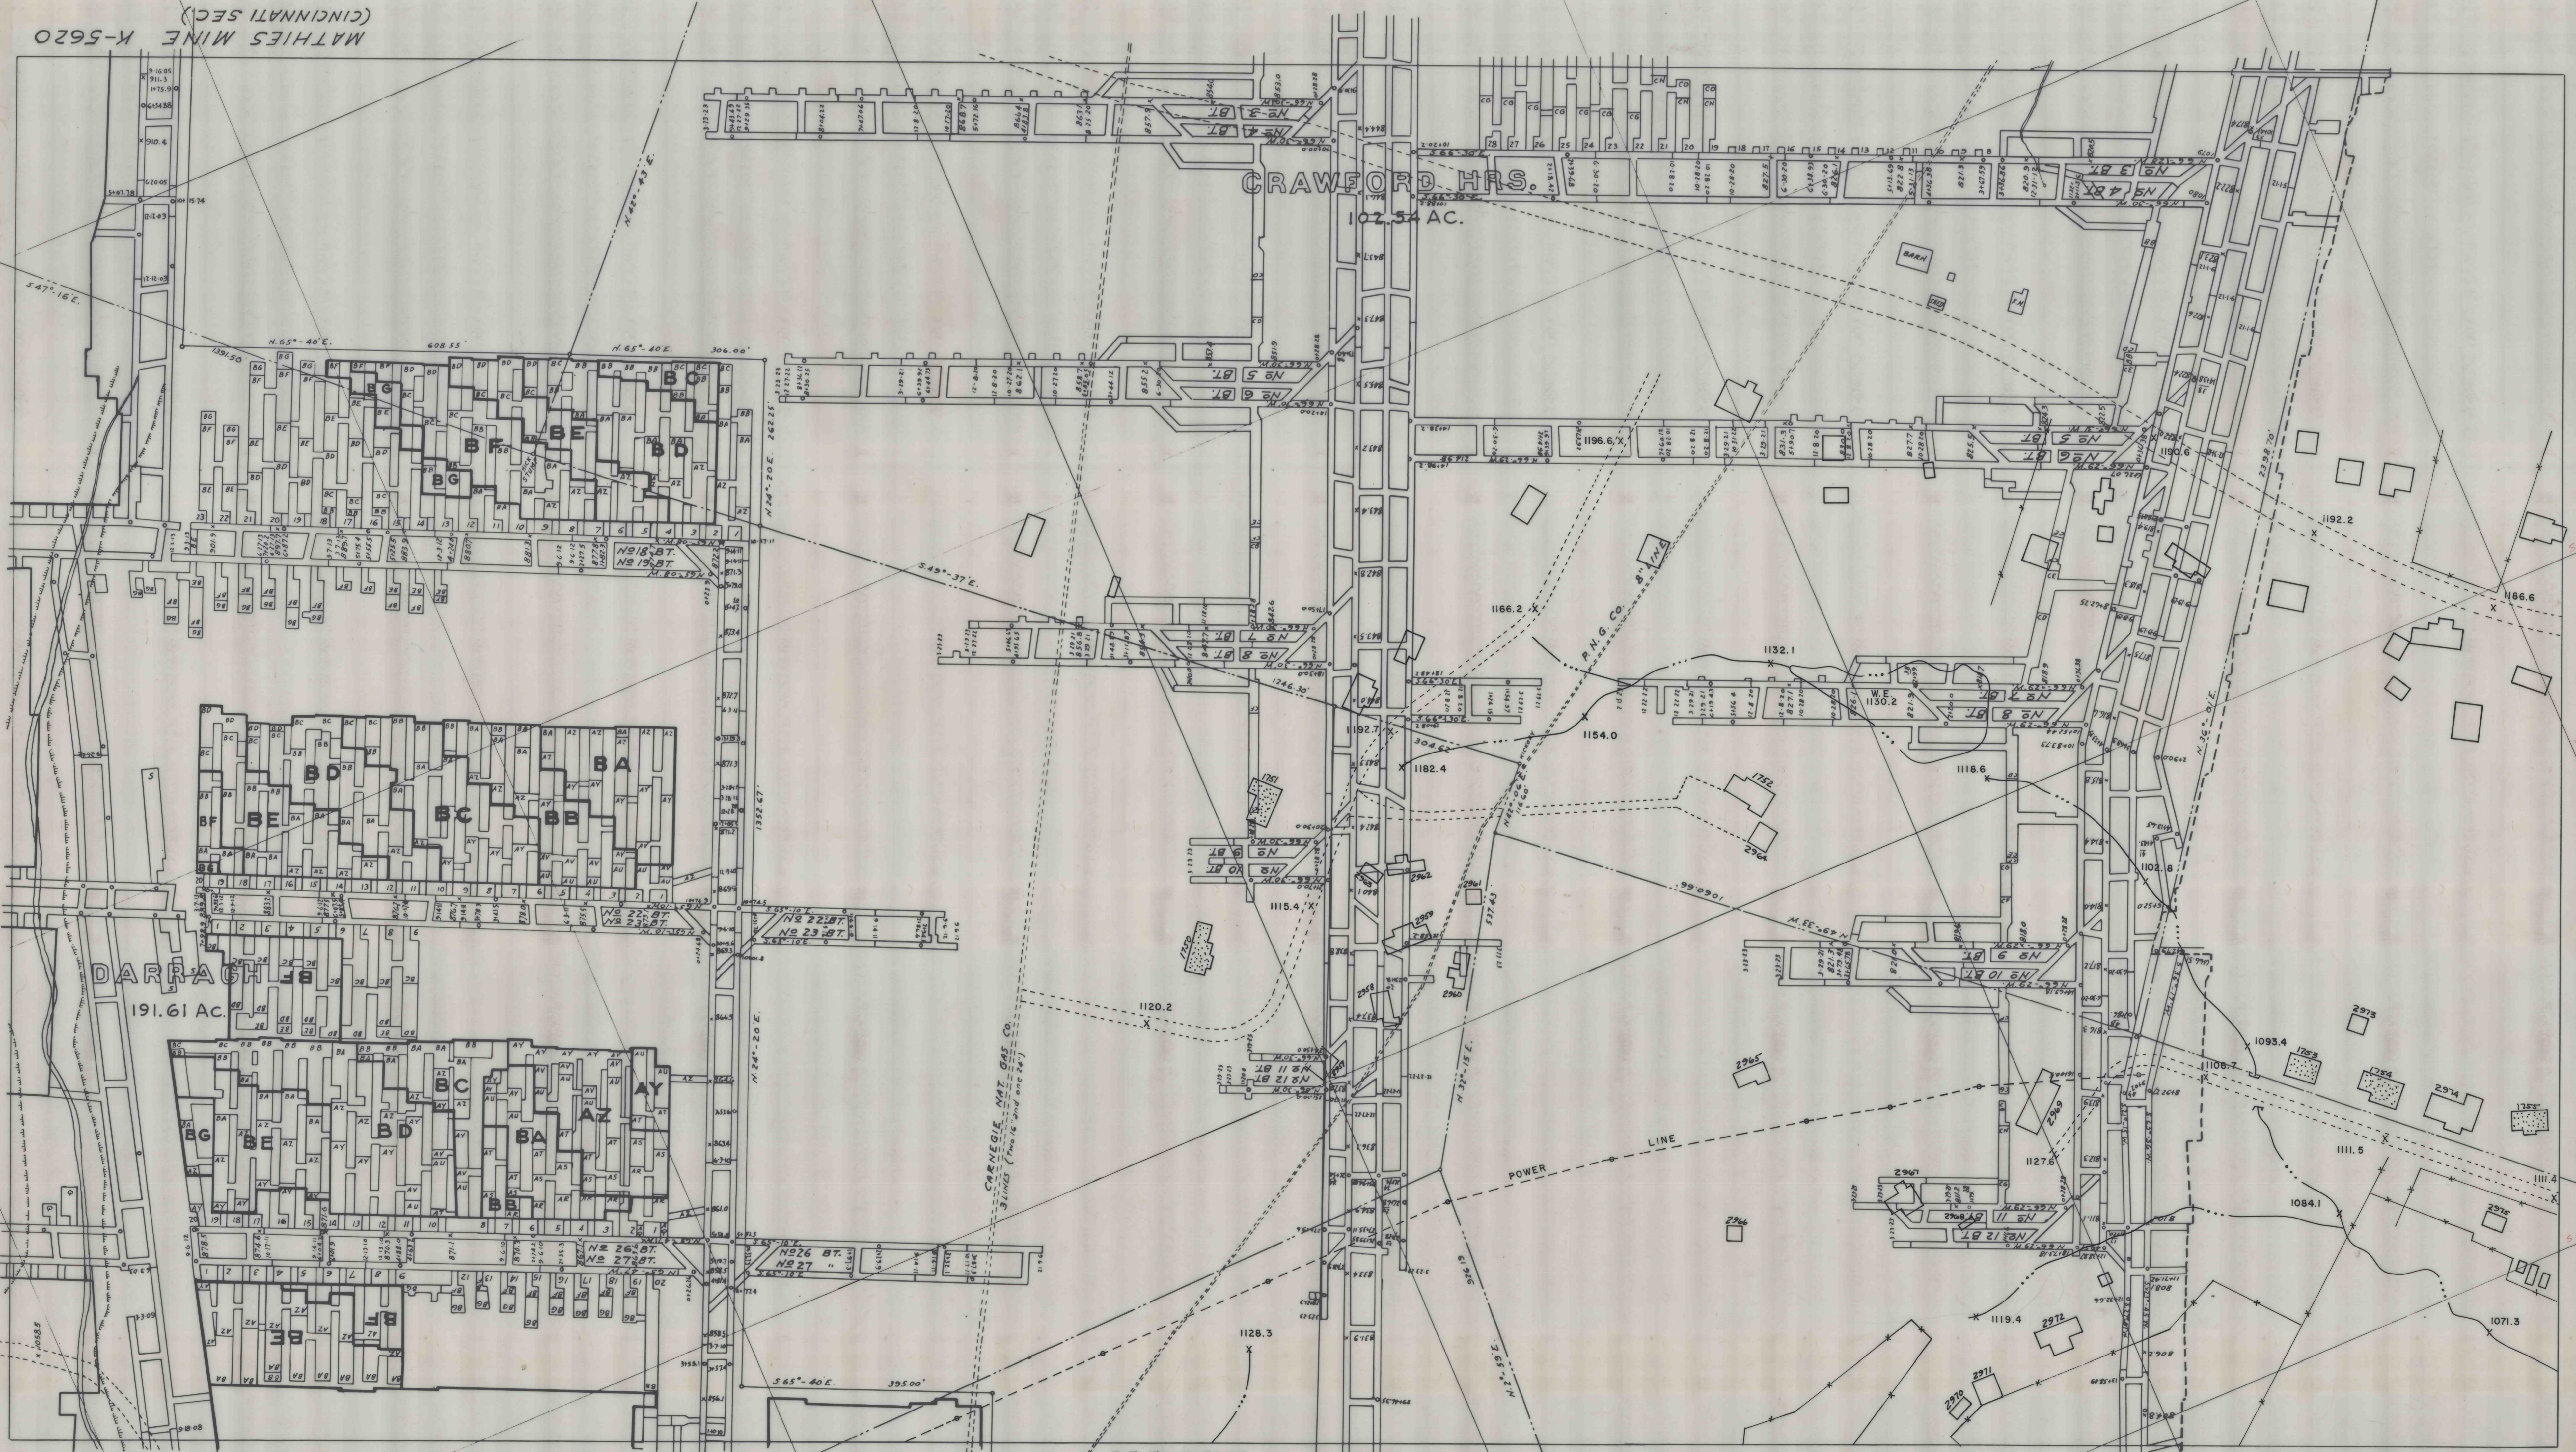

CRAWFORD HRS.
102.54 AC.

DARRACH
191.61 AC.

FIT TO K-5605

MATHIES MINE K-5620
(CINCINNATI SEC.)