


FIT TO 5620

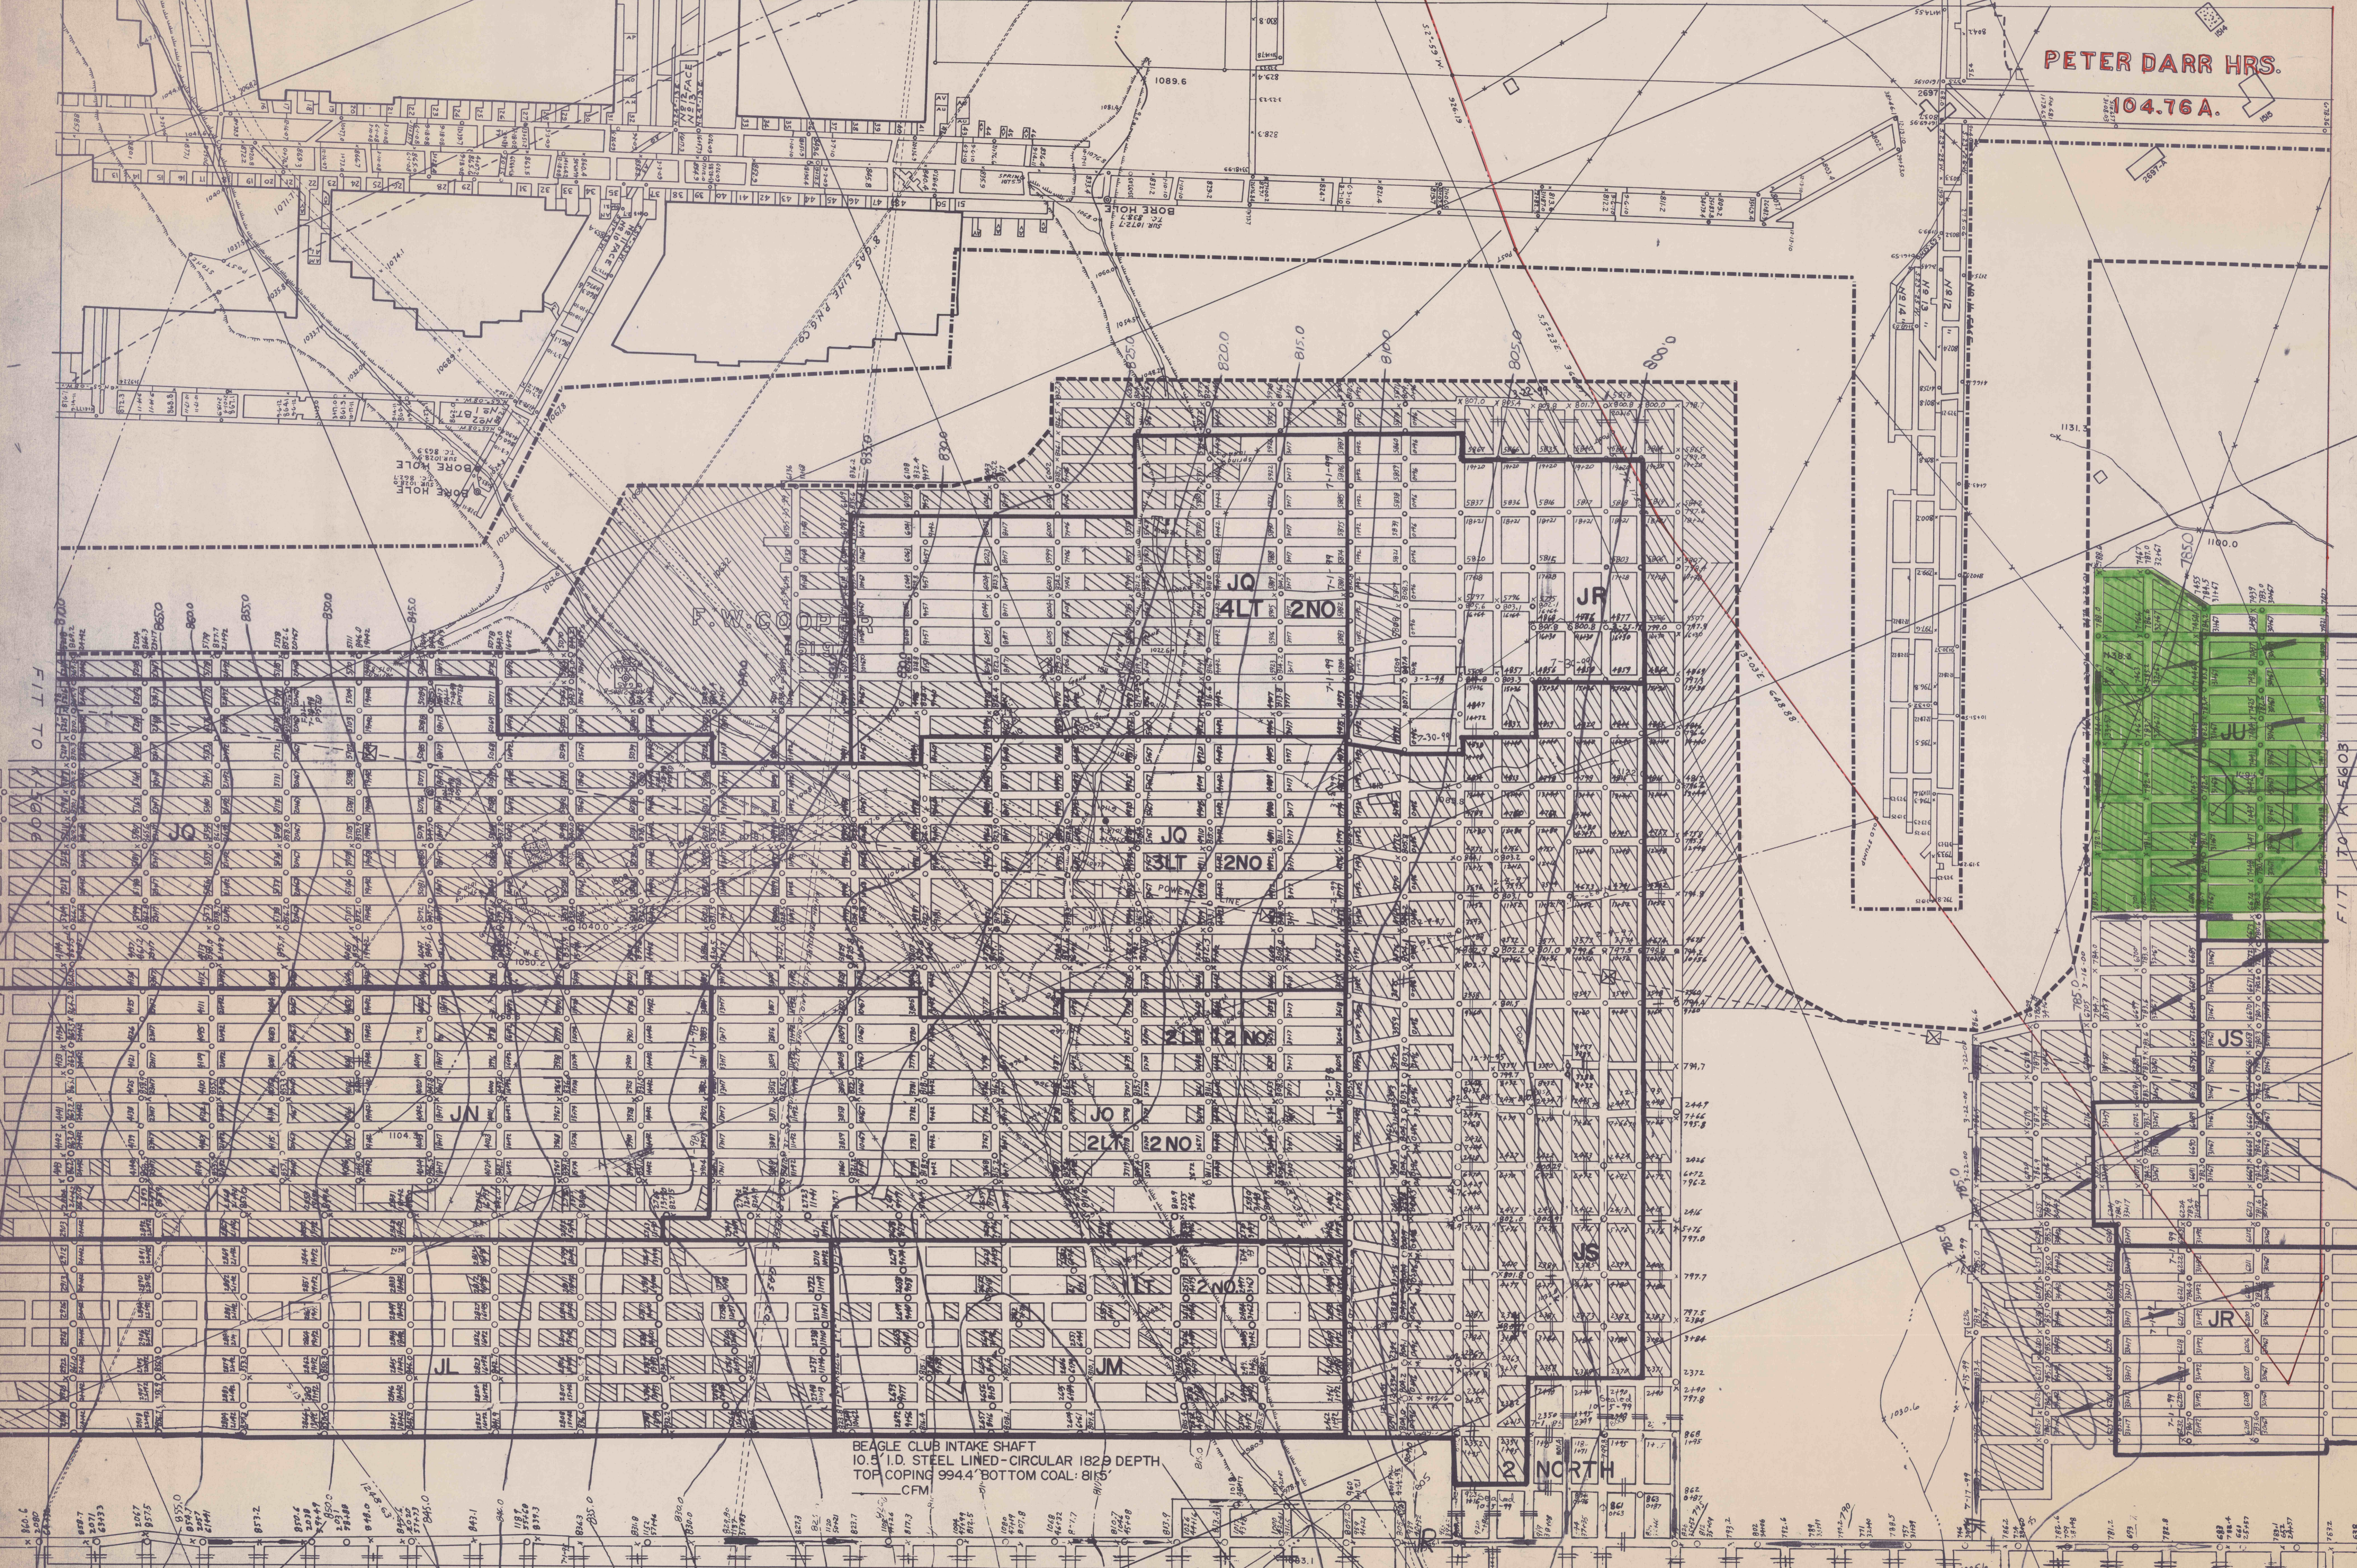

BEAGLE CLUB INTAKE SHAFT
 10.5" I.D. STEEL LINED-CIRCULAR 1829 DEPTH
 TOP COPING 994.4' BOTTOM COAL: 815'
 CFM

FIT TO K-5585