


J.G.R Hamilton

J.T.G. HAMILTON
81.08 AC.

HENRY MORRISON
78.50 AC

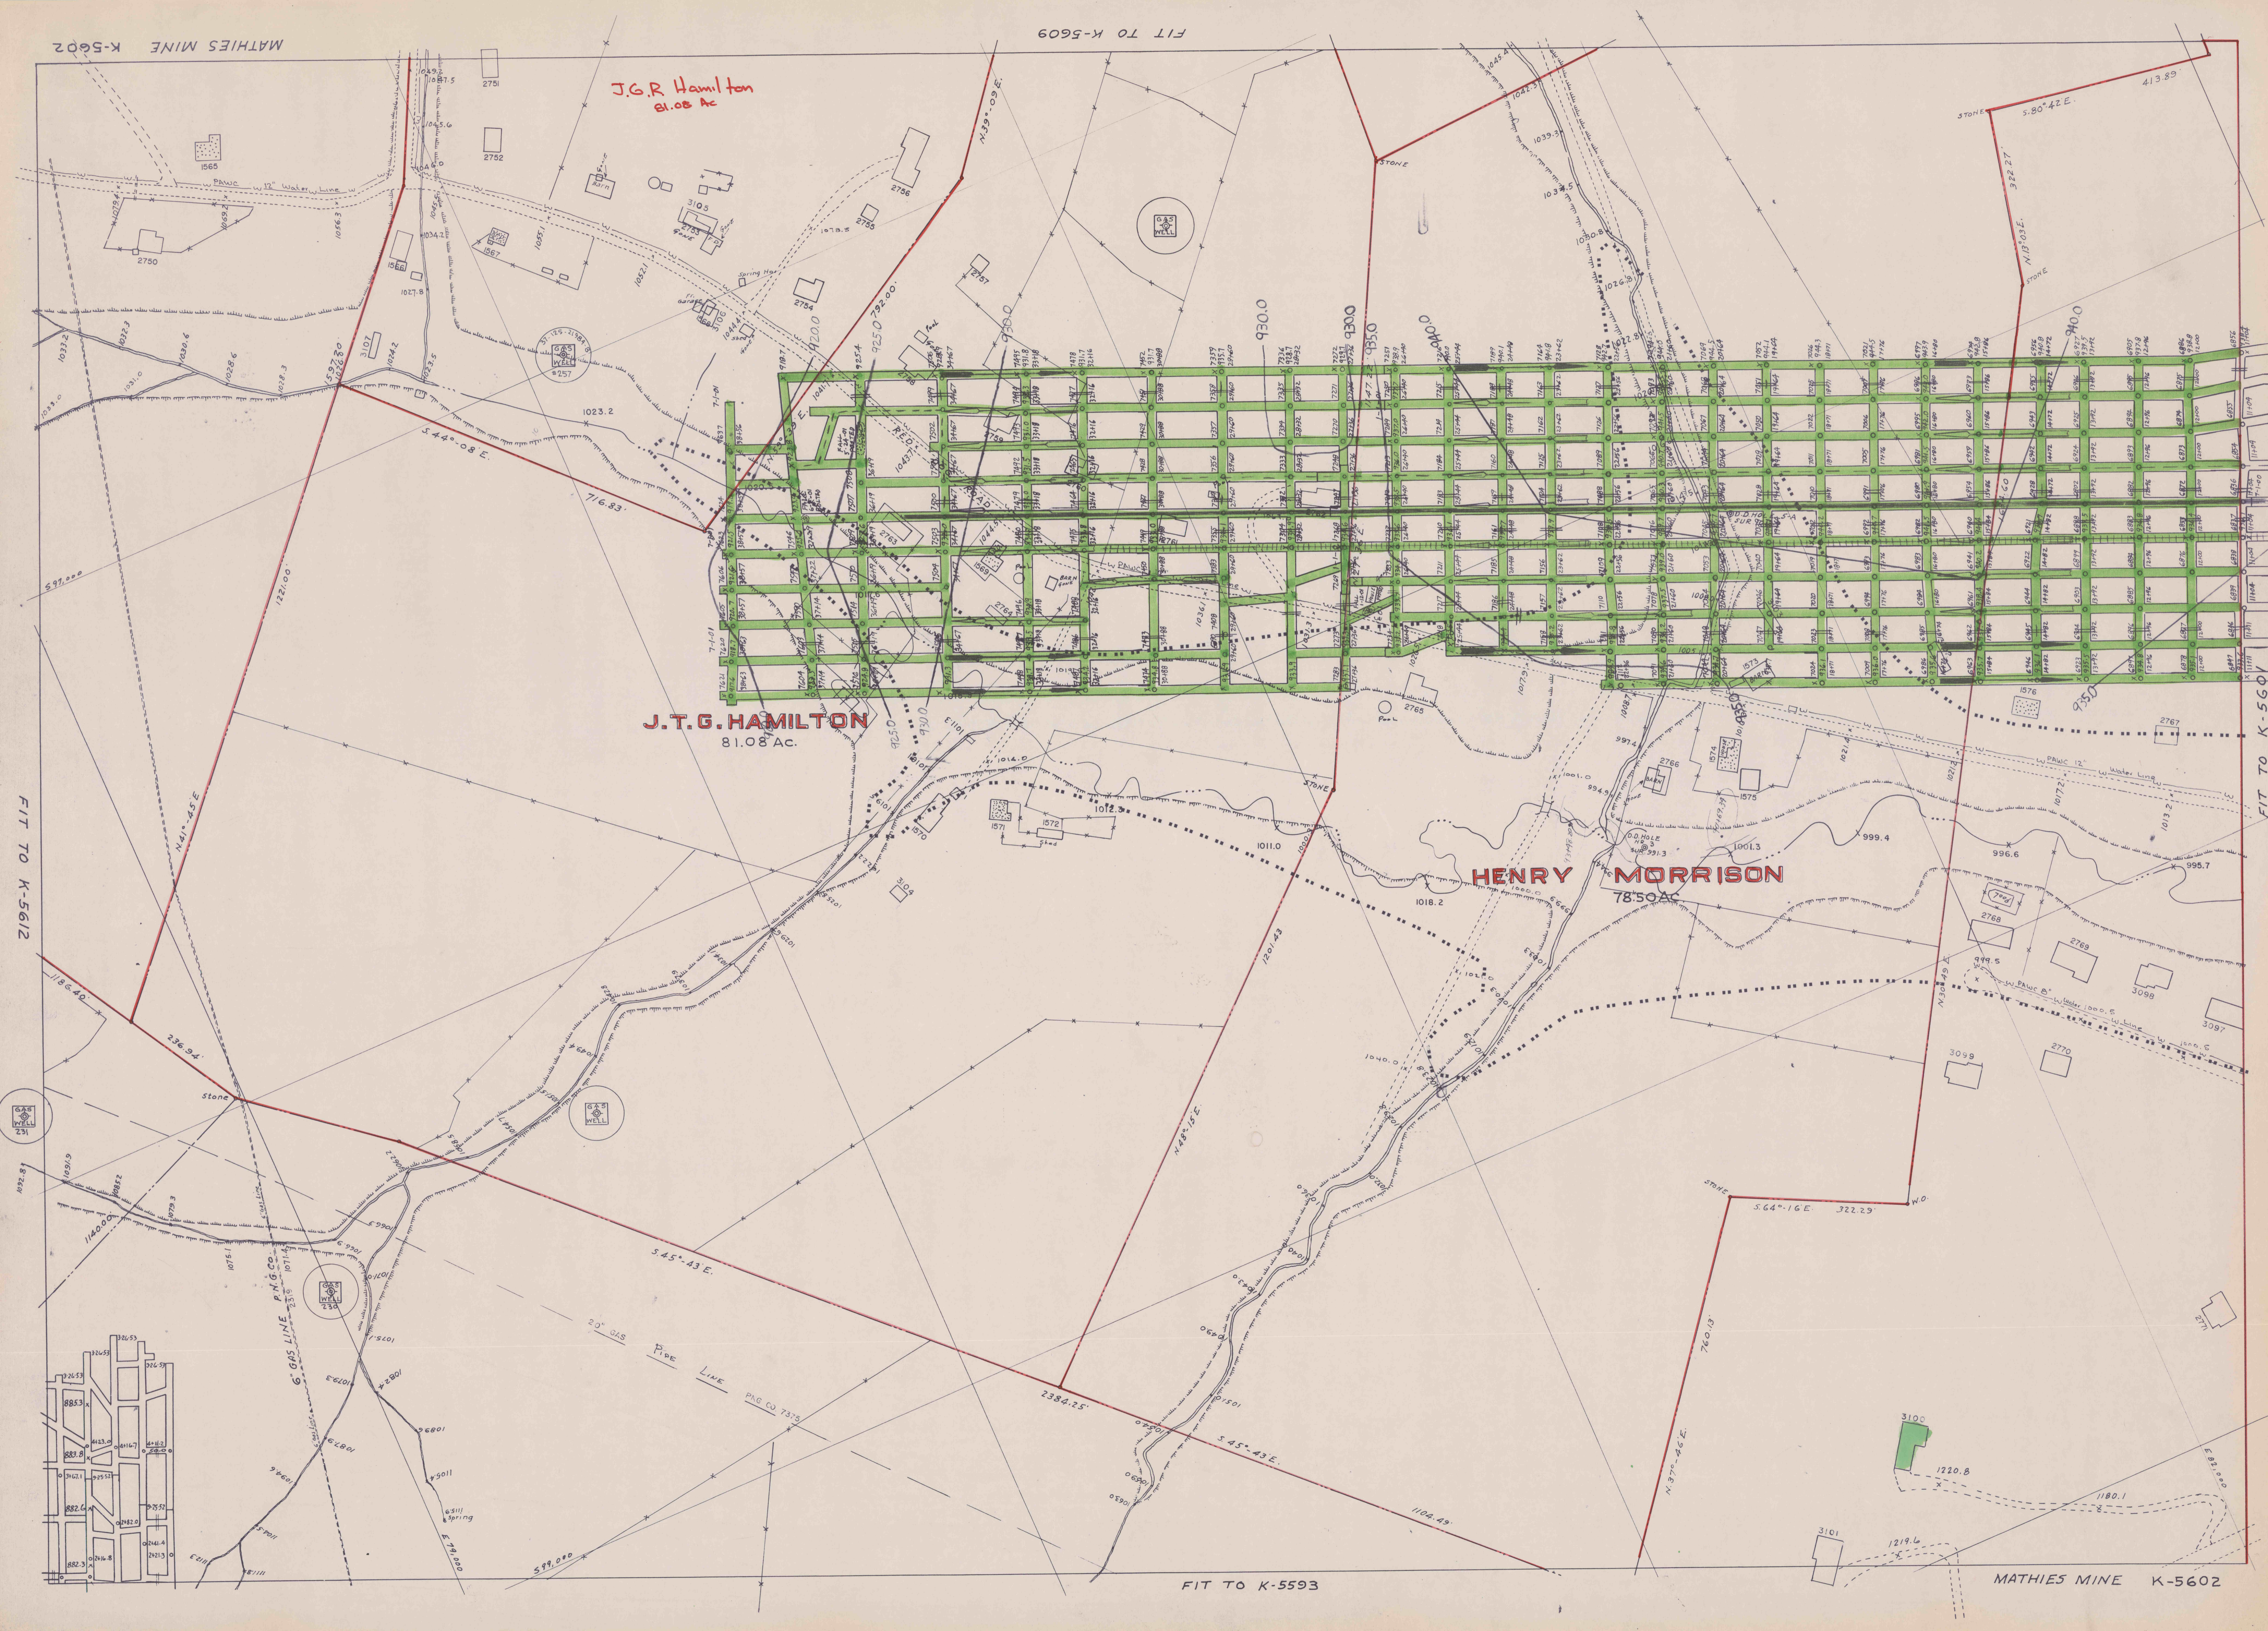

FIT TO K-5612

FIT TO K-5609

FIT TO K-5593