


INDIANA COUNTY
CAMBRIA COUNTY

MATCH TO 45
A.A. BENNETT
101.53 A.

JAMES BENNETT
89.89 A

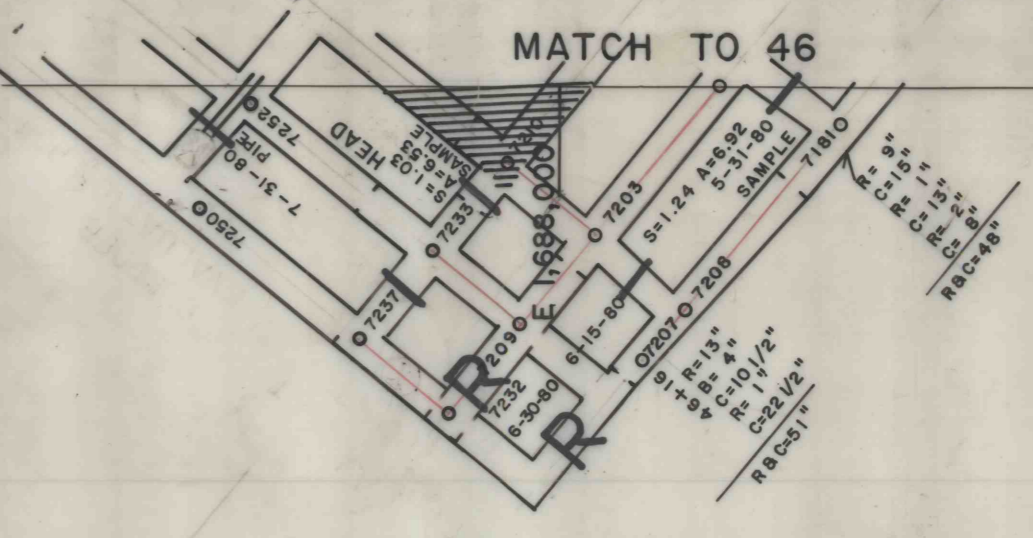

R-2
R-1
"B-22" HDG.

D.D.H. 24-76-01
S= 1770.3
D= 1454.3
C= 30"

C.T. ROBERTS
58.76 A

A.A. BENNETT
14.43 A

JAMES BENNETT
2.86 A.

(APPROX. LOC.)
D.D.H. 349
S= 1677
D= 1400
C= 40"

D.D.H. 24-76-05
S= 1710
D= 1400
C= 33"

CLOSING DATE: 6-30-85

LANCASHIRE 24" SEAM