


MATCH TO SHEET 23

MATCH TO SHEET 24

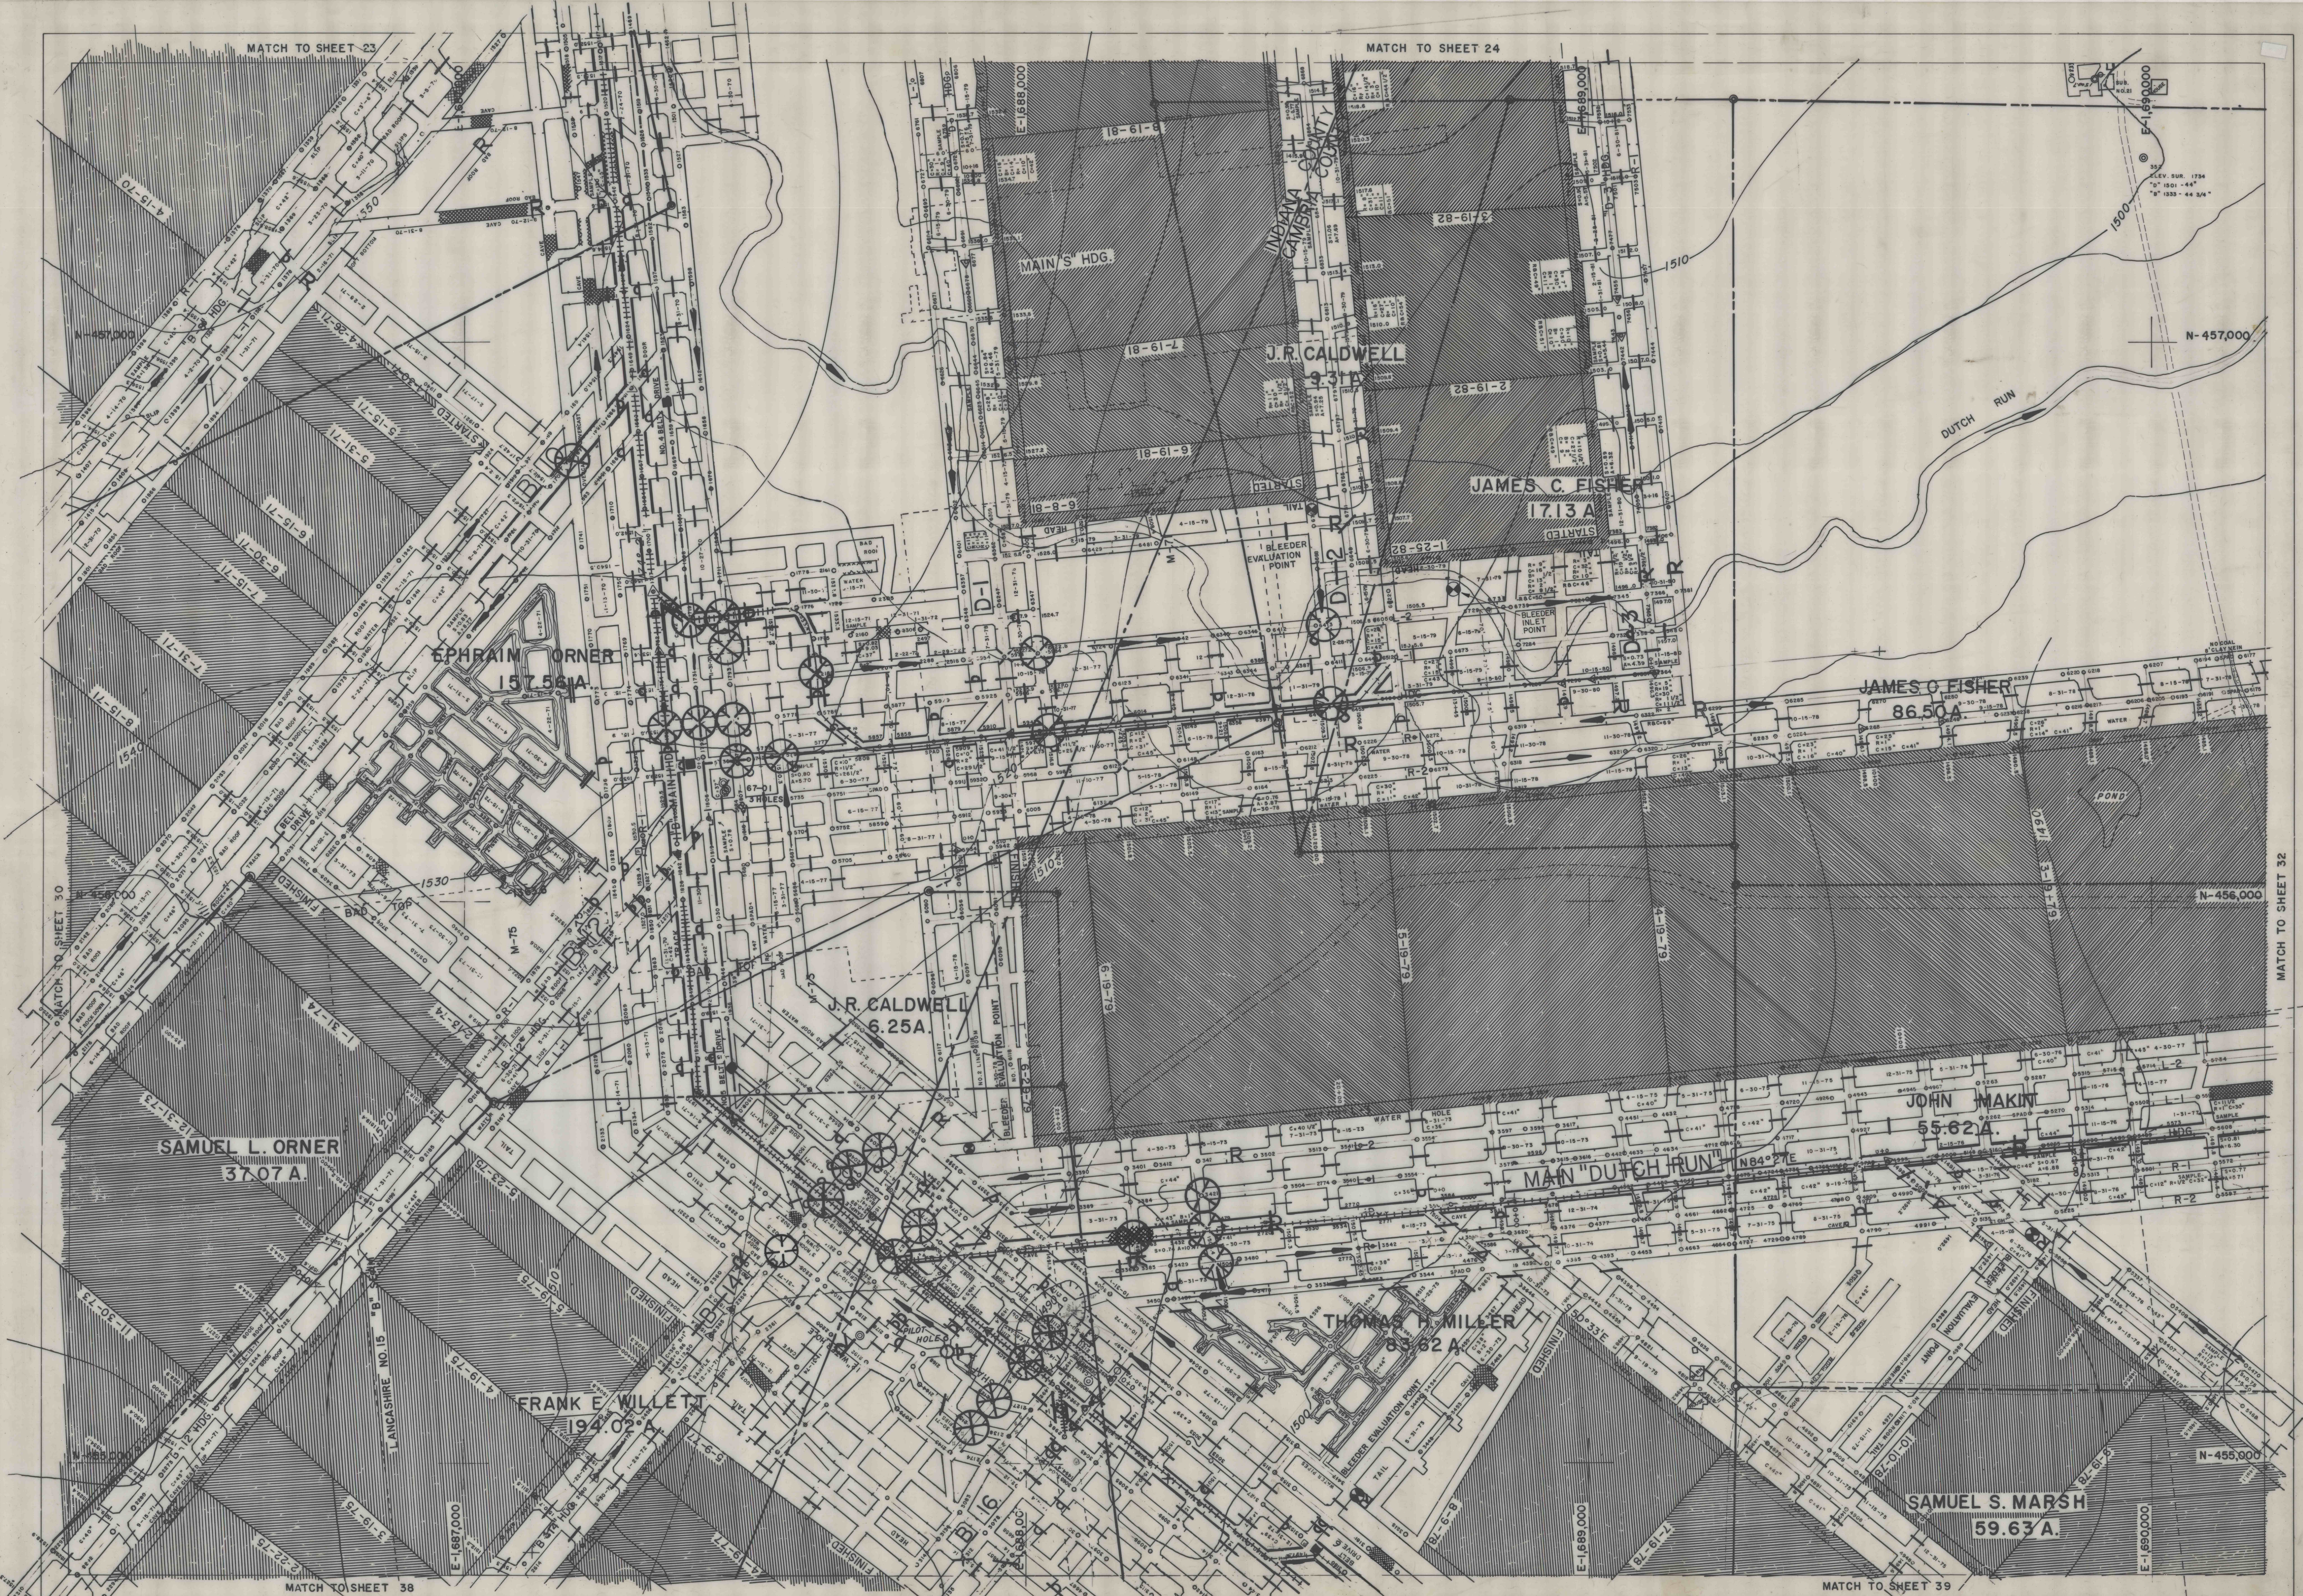

MATCH TO SHEET 30

MATCH TO SHEET 32

MATCH TO SHEET 38

MATCH TO SHEET 39

CLOSING DATE: 6-30-85

NO. 24 "D" SEAM