


MATCH TO 13

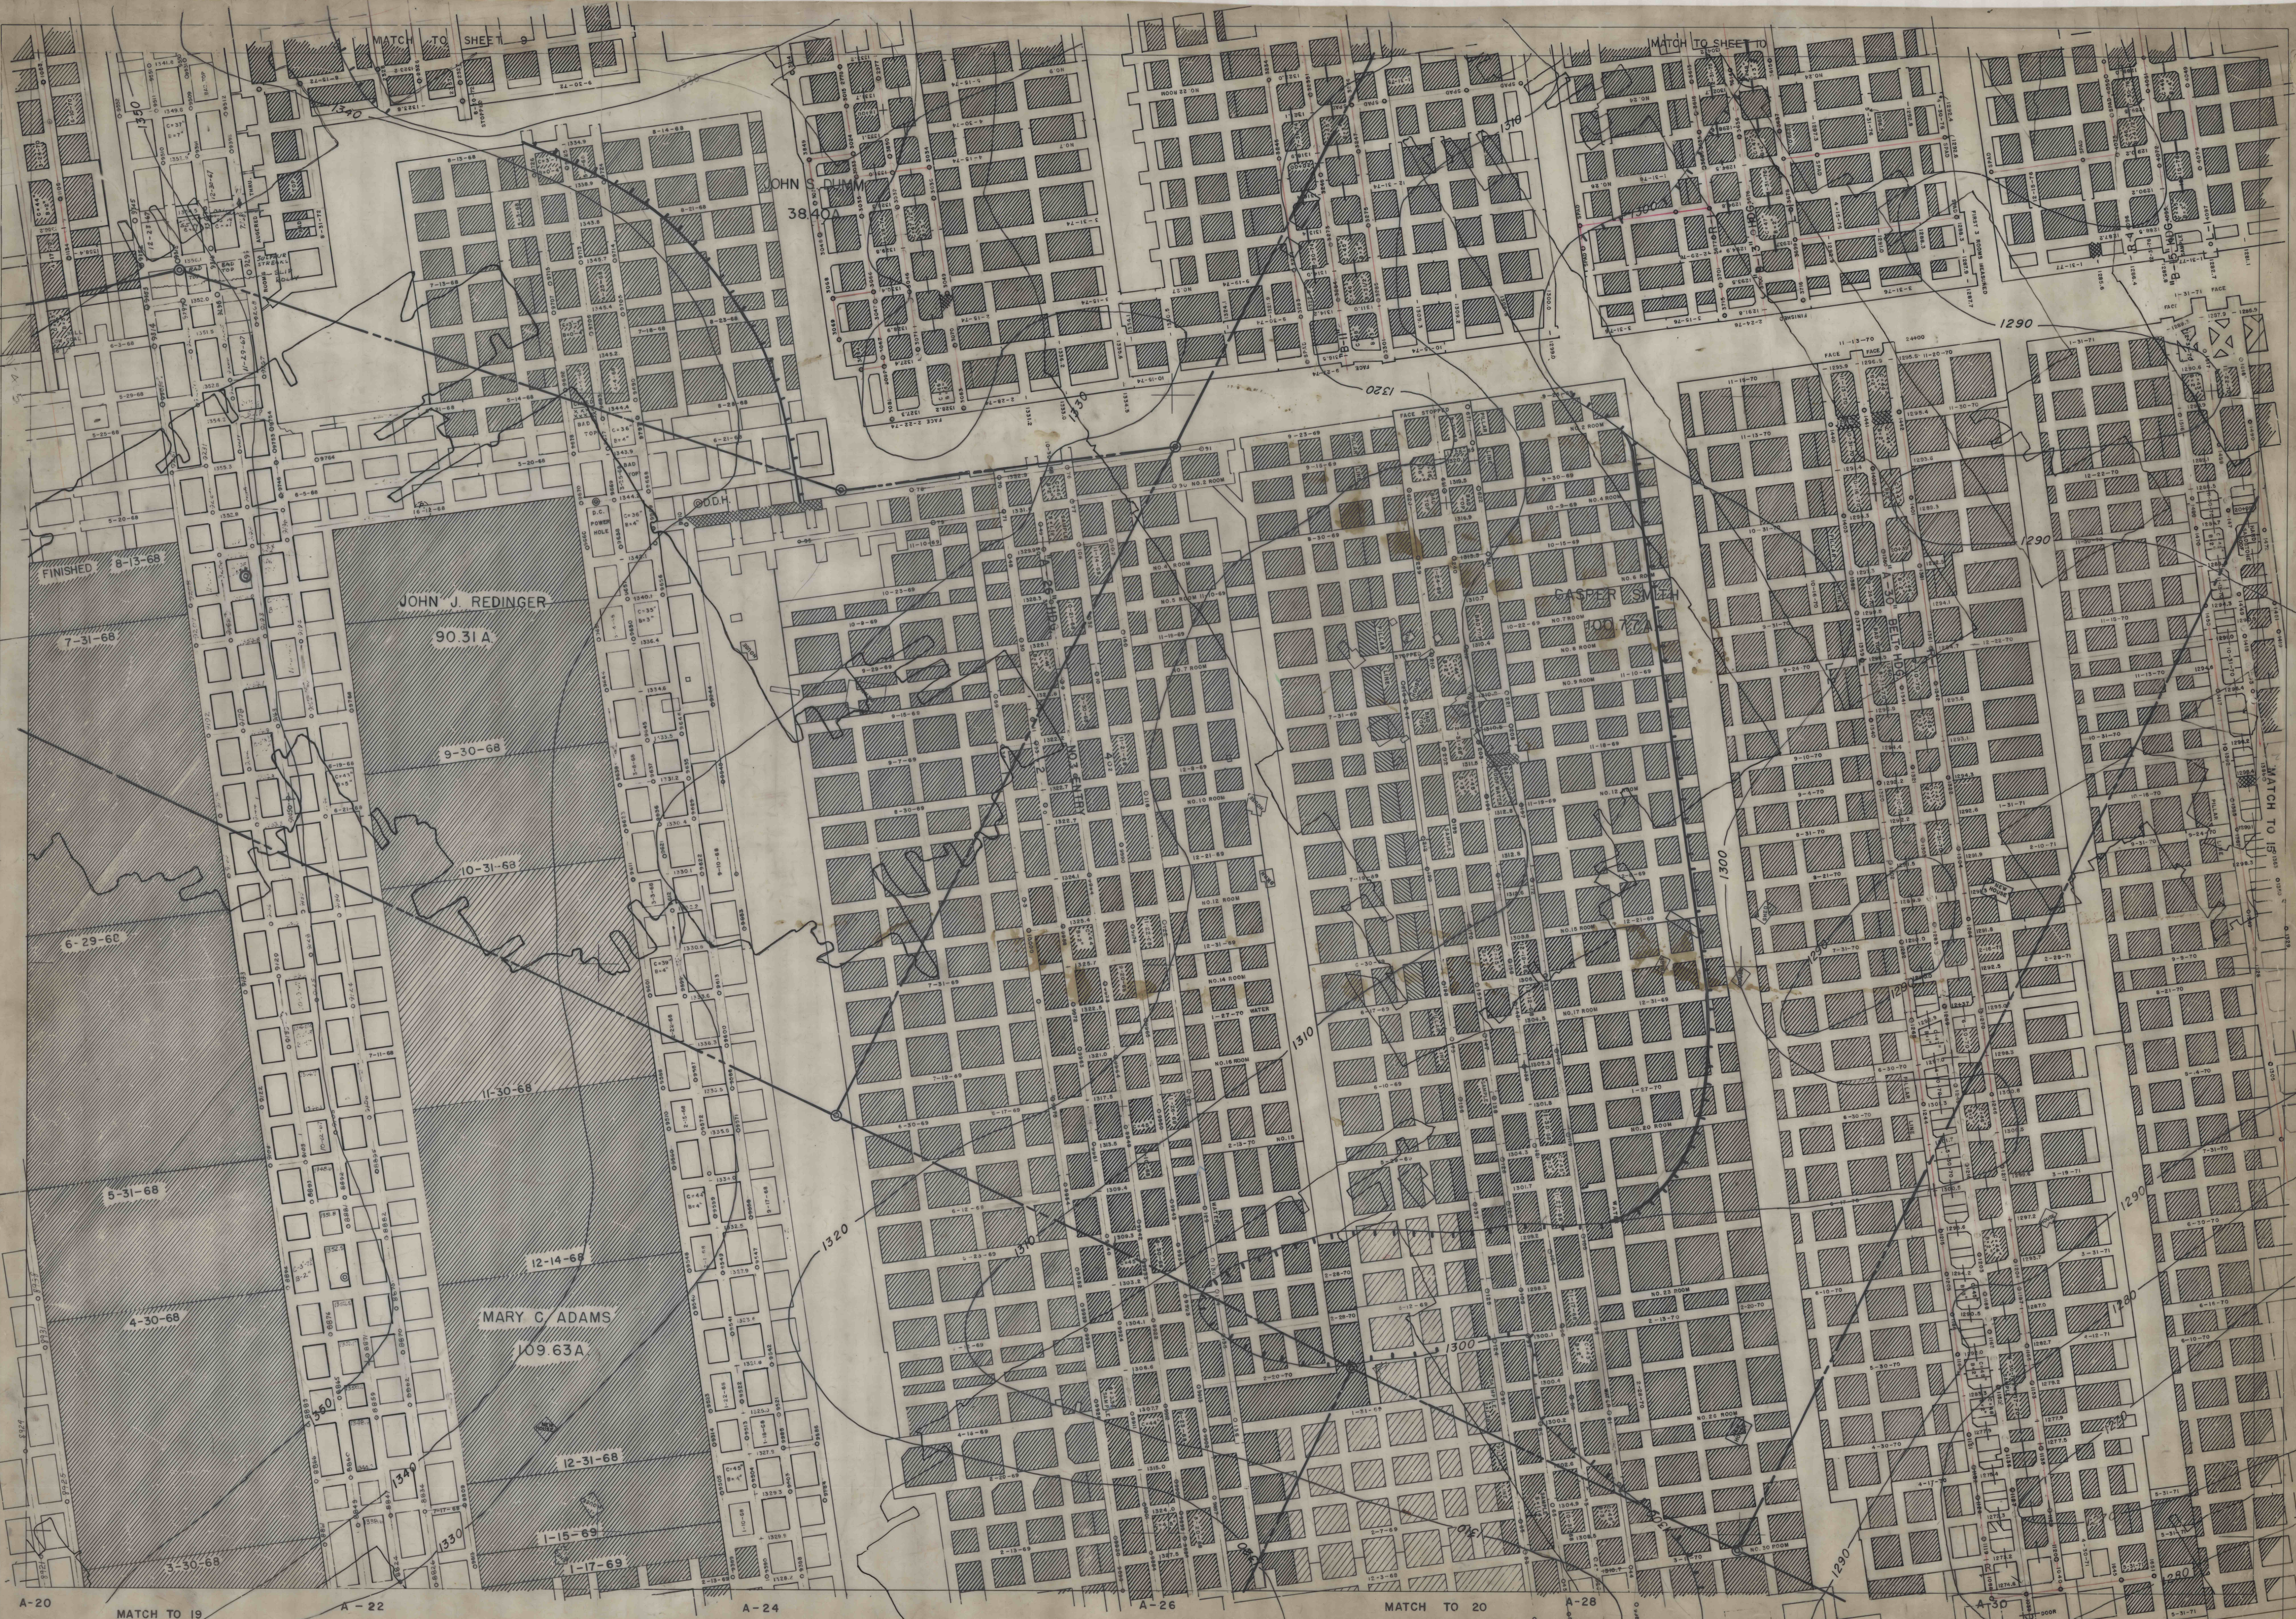

NO. 24 "B" SEAM
FINAL MAPPING DATE 4-11-86