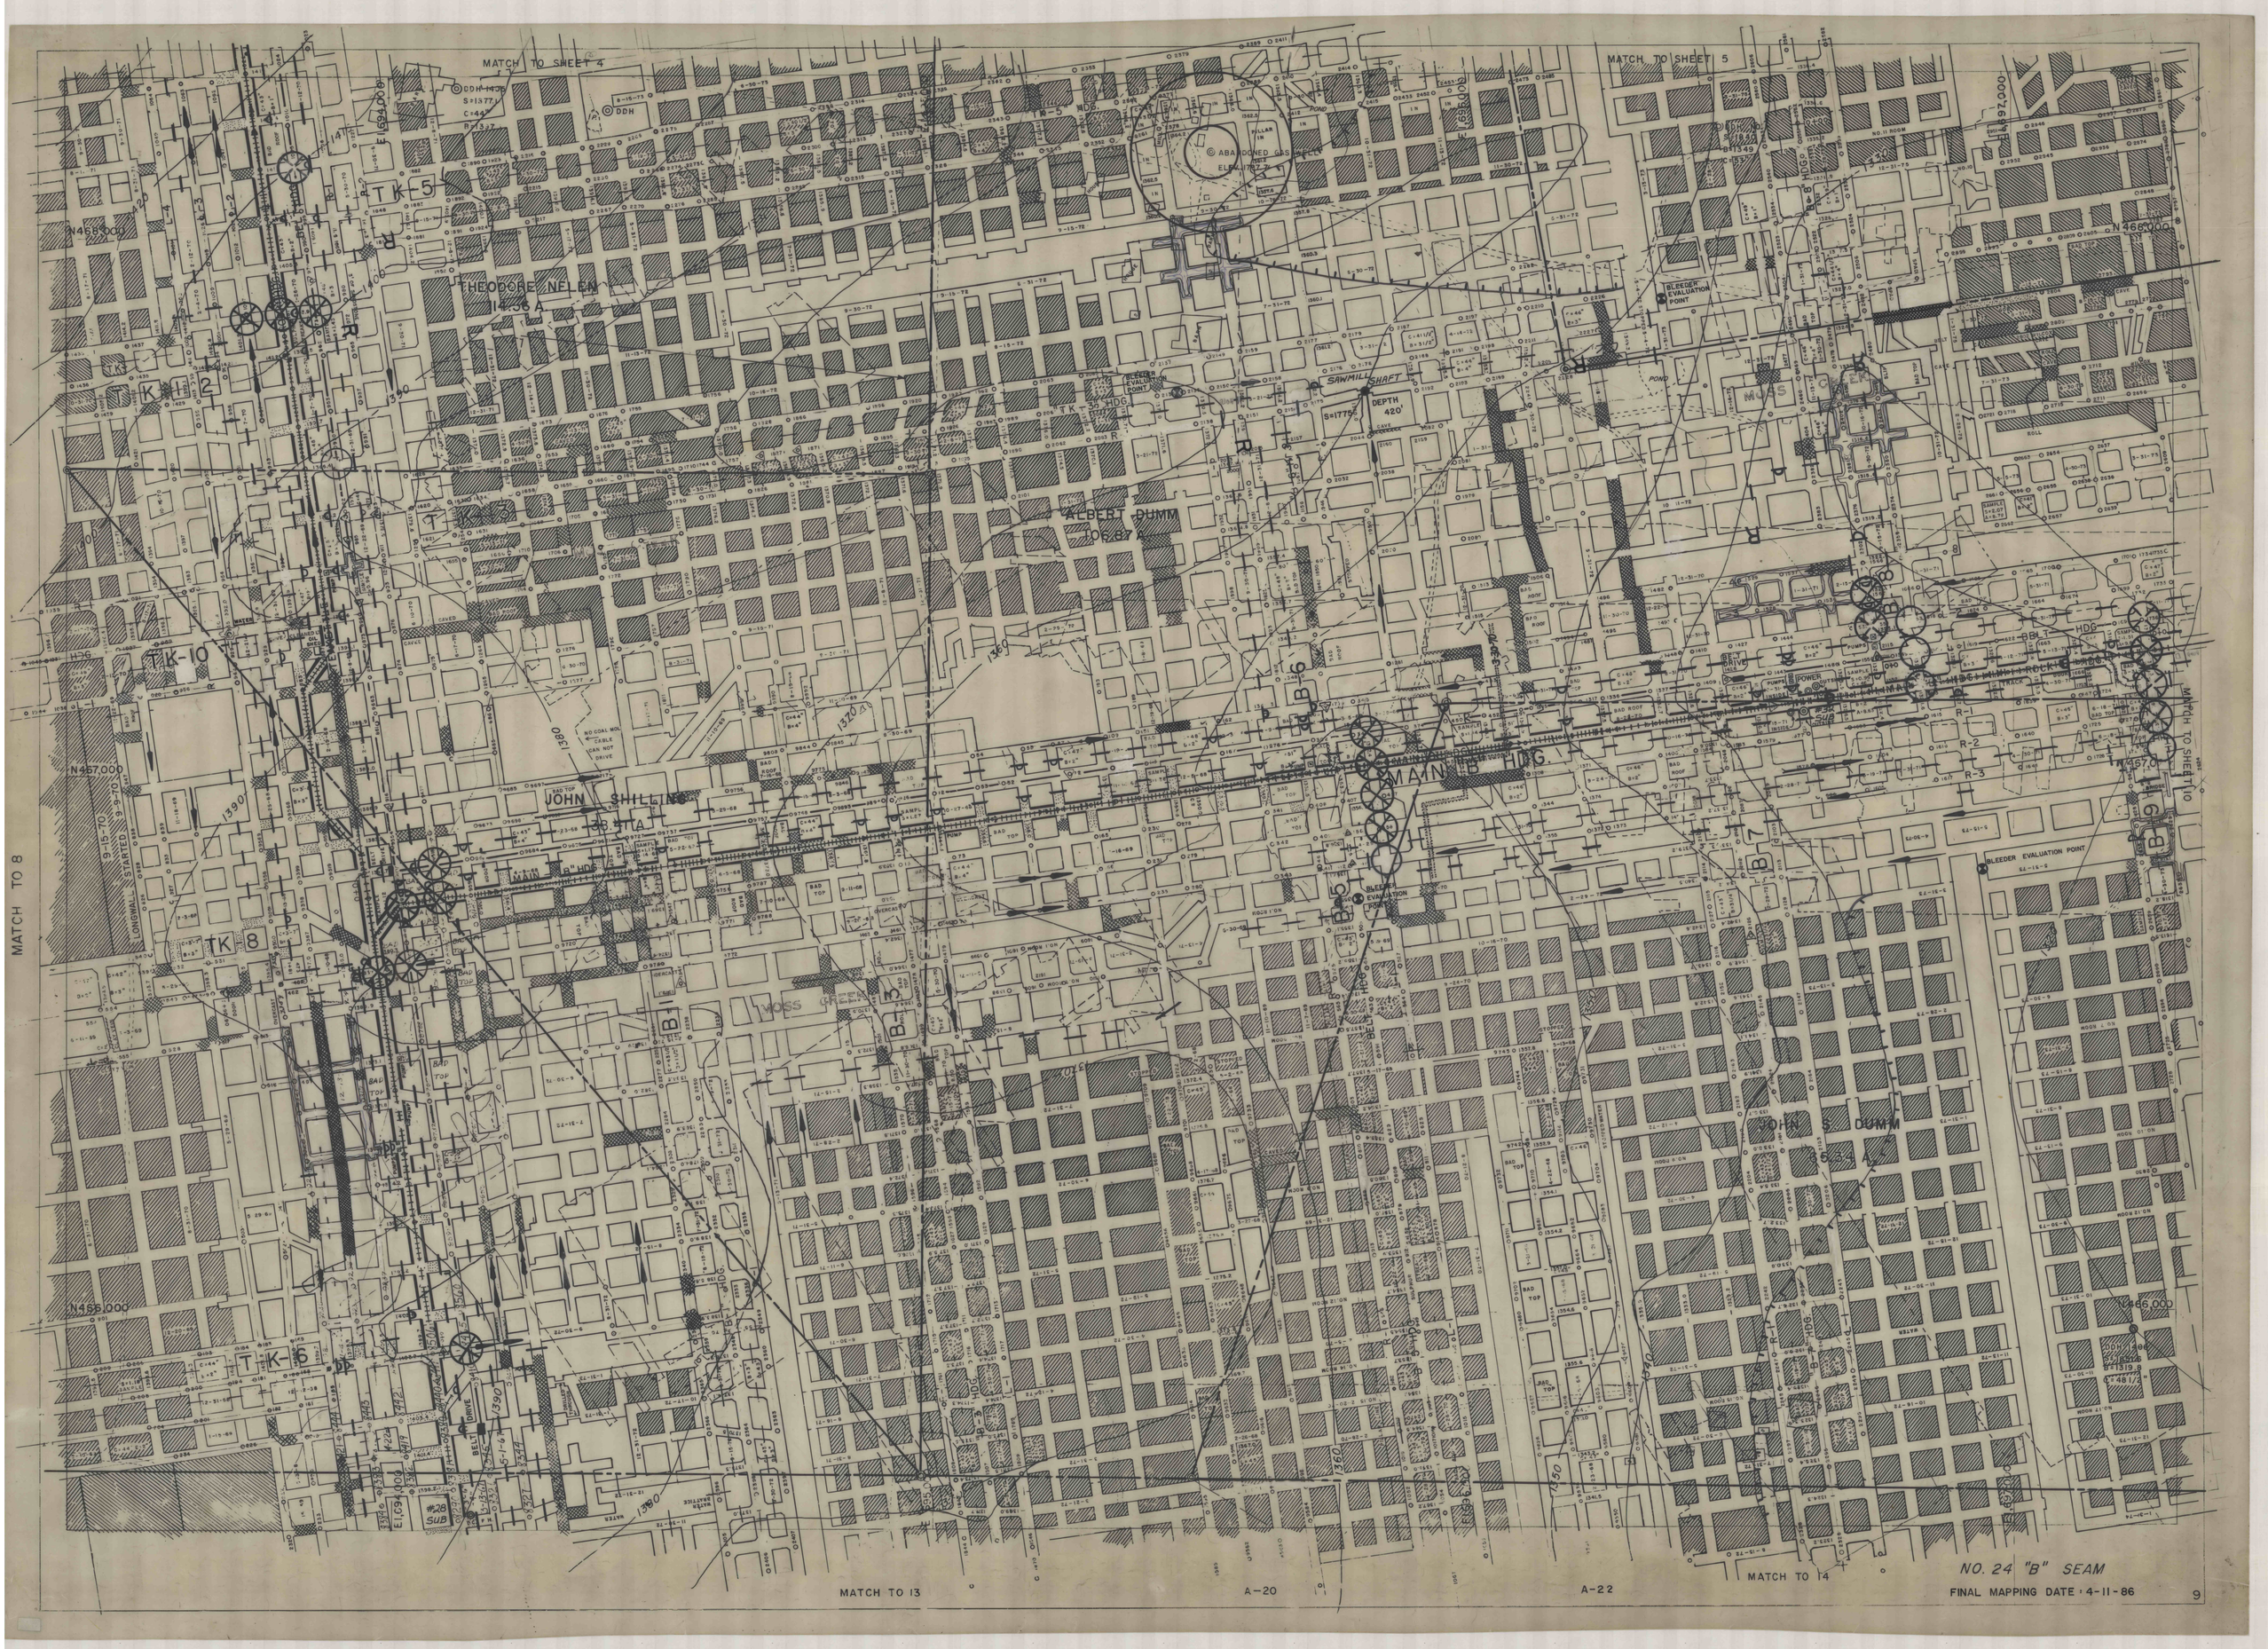
MATCH TO SHEET 4
MATCH TO SHEET 5
MATCH TO 8
MATCH TO 13
MATCH TO 14
MATCH TO SHEET 10
THEODORE NELEN
ALBERT DUMM
JOHN SHILLING
JOHN S. DUMM
SAWMILL SHAFT
DEPTH 420'
BLEEDER EVALUATION POINT
MAIN B HDG.
MOSS CREEK
TK-5
TK-10
TK-8
TK-6
N468,000
N467,000
N466,000
A-20
A-22
NO. 24 "B" SEAM
FINAL MAPPING DATE: 4-11-86
9