

E 1694,000

E 1695,000

E 1696,000

E 1697,000

N 473,000

N 473,000

N 472,000

N 472,000

MATCH TO SHEET 1

MATCH TO 2-A

INDIANA
CAMBRIA
COUNTY
COUNTY


R. D. WILLIAMS
102.67A.

⊙ NO. 215P
C=33 1/4"

⊙ D.D.H. 24-80-01
S=1871.3
C=46
D=445"
S=110'
A=4.97

D.D.H. NO.3
S=1855
B=1439
C=36 1/2"

SYLVESTER BYRNE 87.00

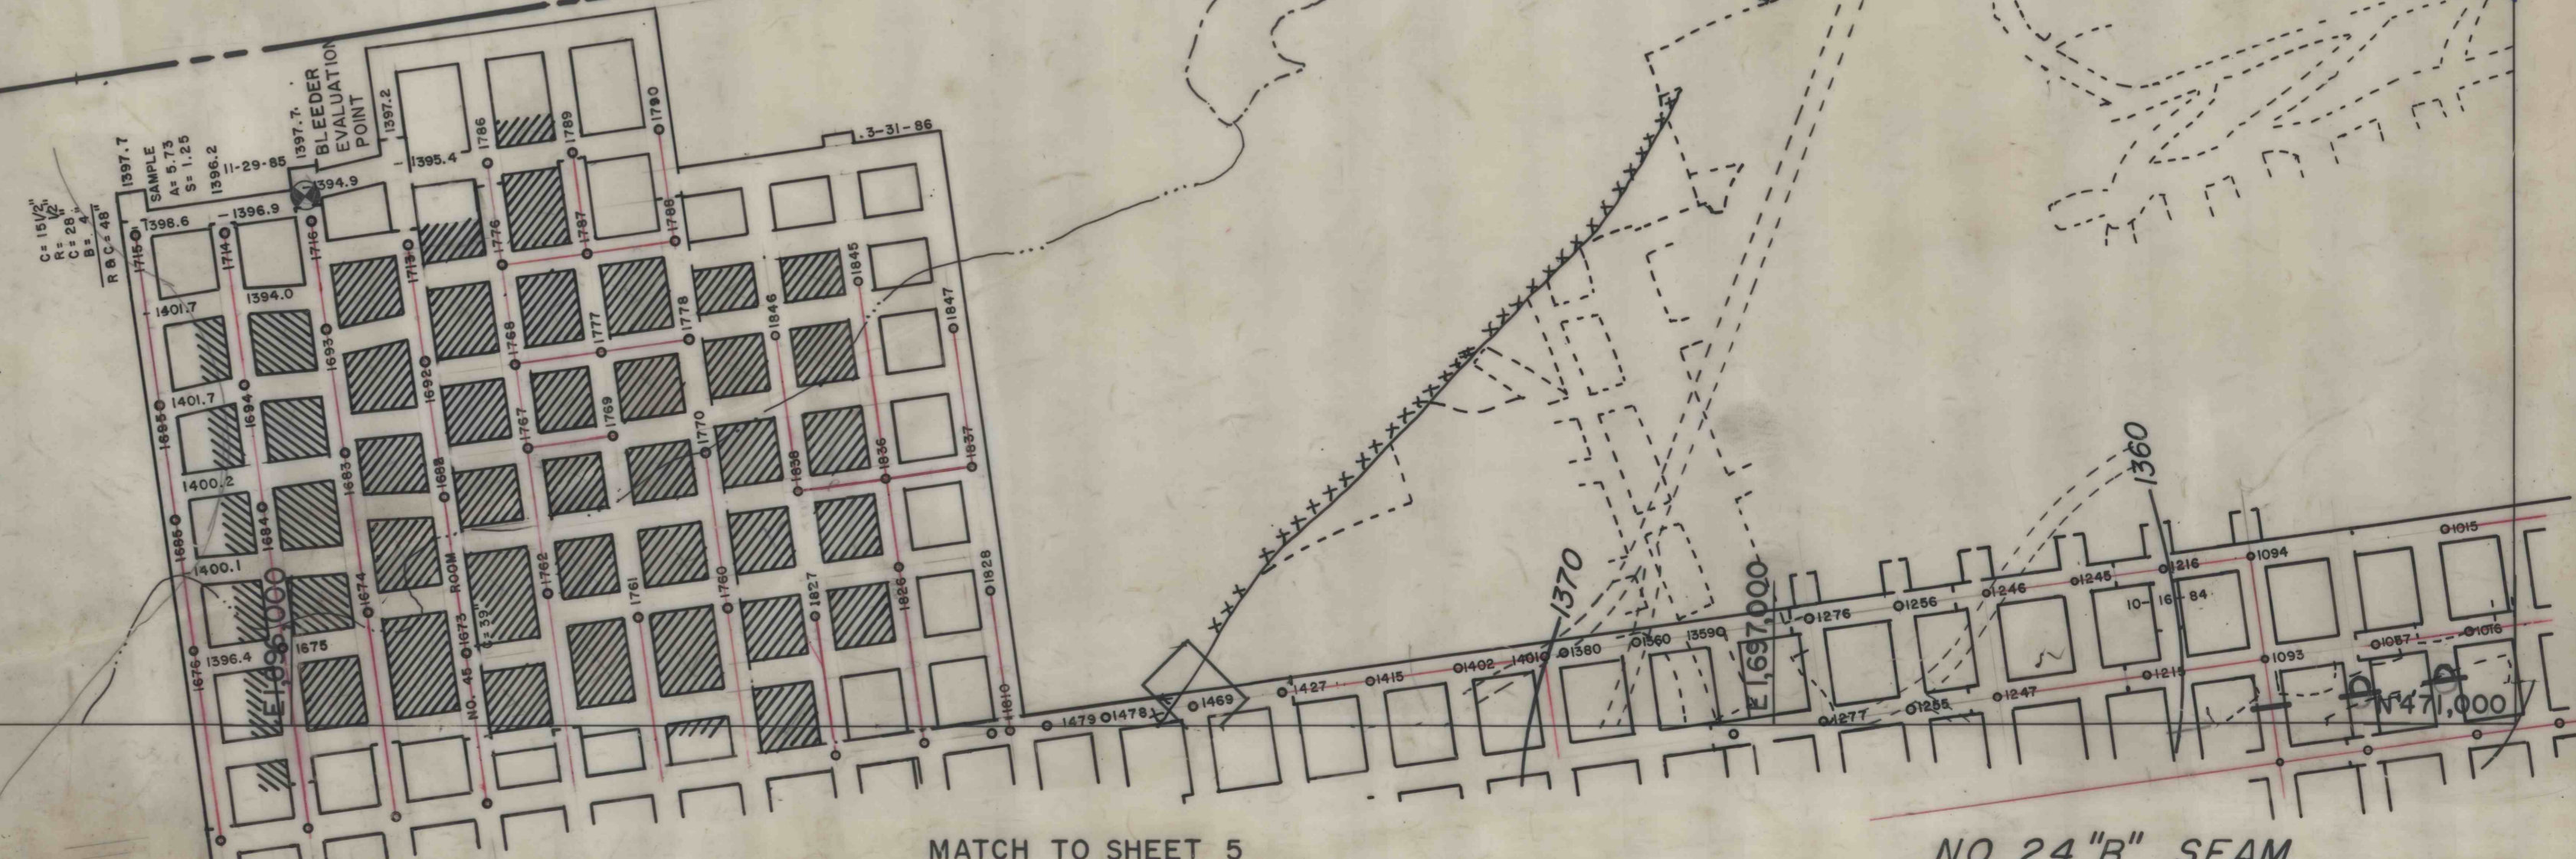

E 1693,800

E 1694,000

E 1695,000

N 471,000

N 471,000

MATCH TO SHEET 4

MATCH TO SHEET 5

NO. 24 "B" SEAM
FINAL MAPPING DATE: 4-11-86