

MATCH TO SHEET 1

MATCH TO 2-A

R. D. WILLIAMS
102.67A.


INDIANA
CAMBRIA
COUNTY COUNTY

SYLVESTER BYRNE 87.00 A

NO. 215P
C=32 1/4"

D.D.H. 24-80-01
S=1871.3
C=46"
D=443"
S=1.10
A=4.97

D.D.H. NO.3
S=1855
B=1439
C=36 1/2"

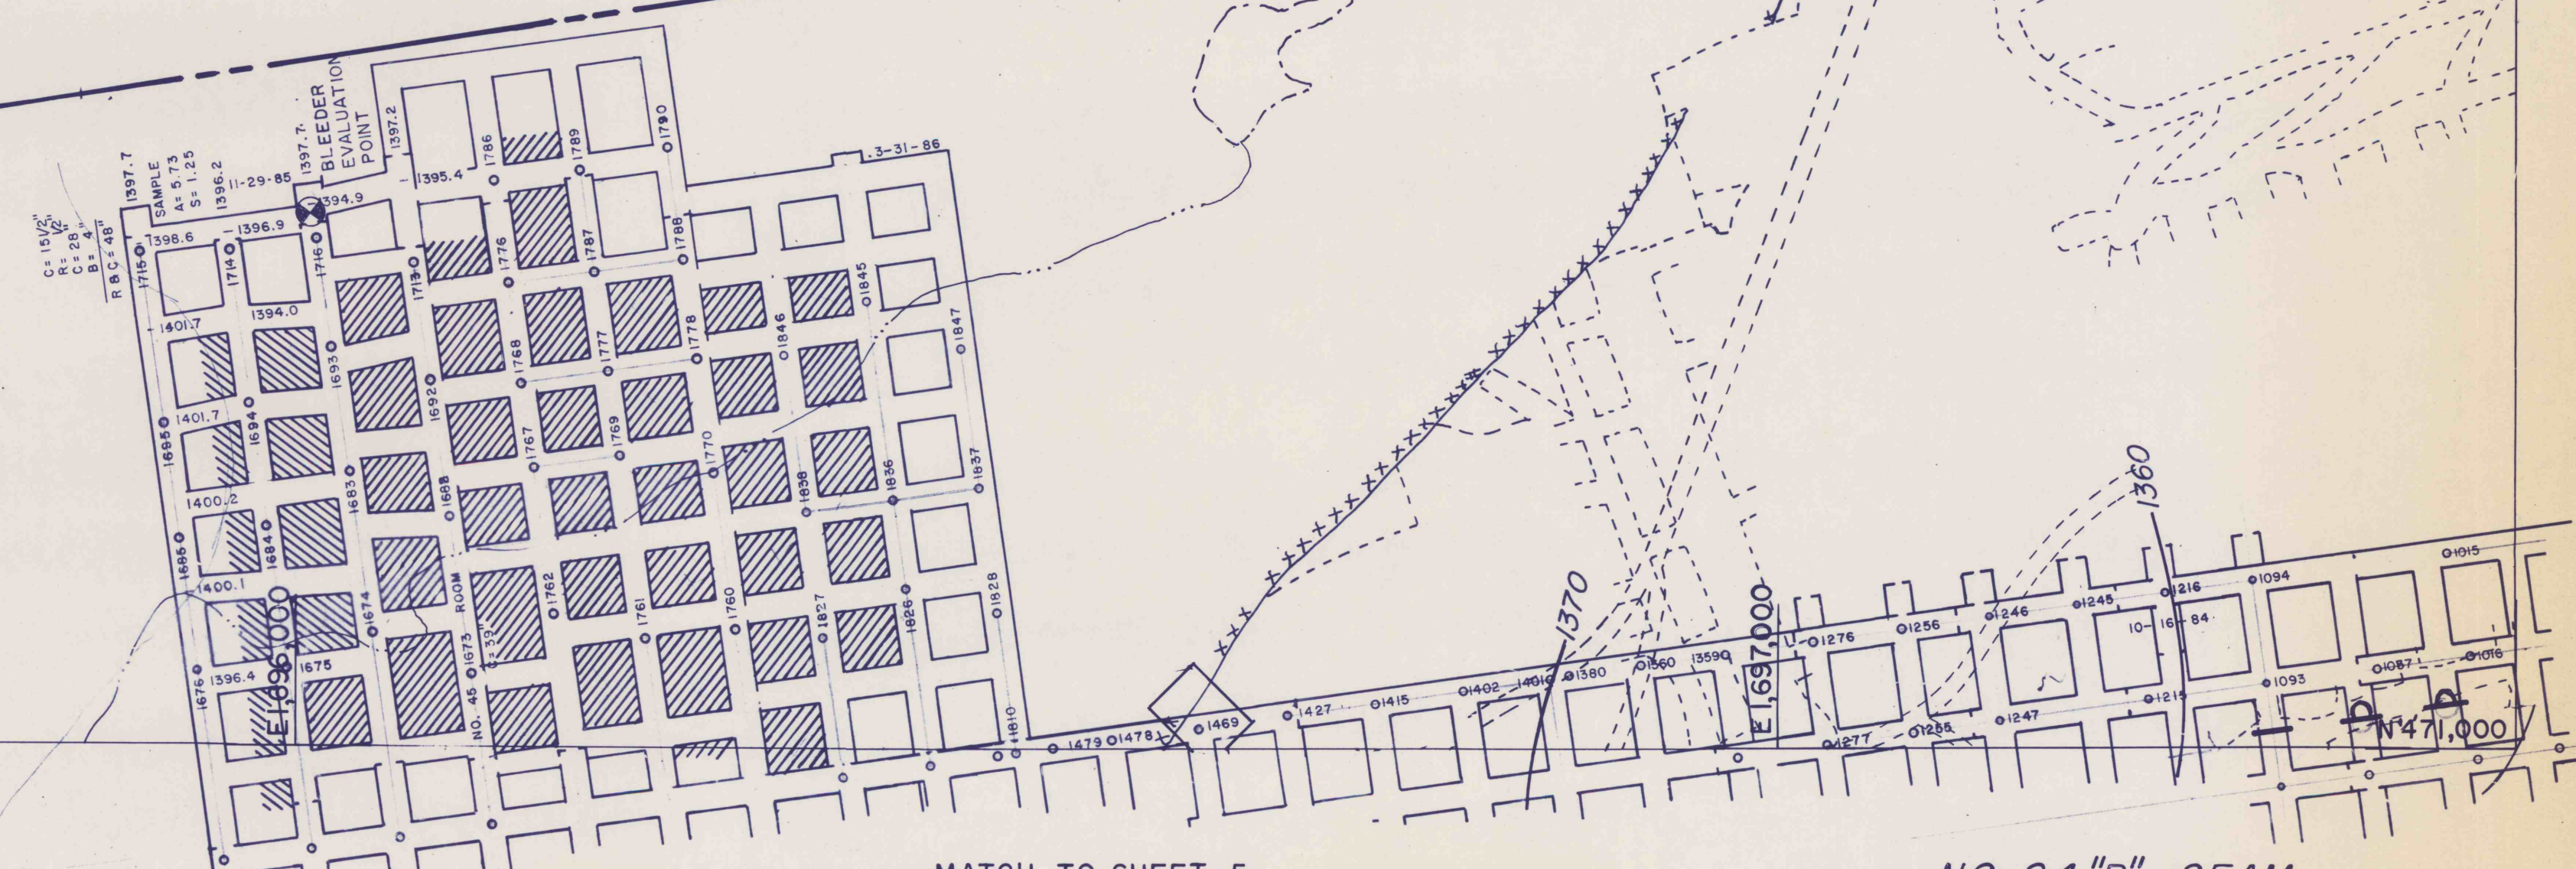

MATCH TO SHEET 4

MATCH TO SHEET 5

NO. 24 "B" SEAM
FINAL MAPPING DATE: 4-11-86