



MATCH TO SHEET 2-A

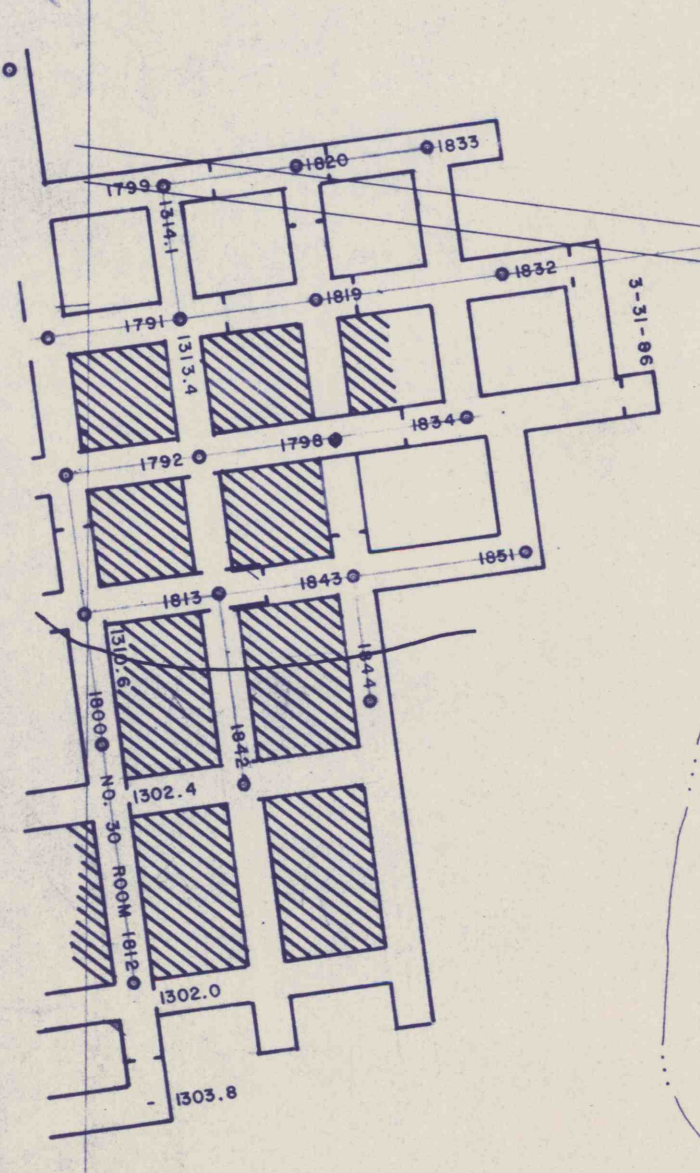

PA ROUTE 553



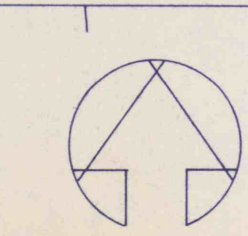

MATCH TO SHEET 6

MATCH TO SHEET 7

24-B

SCALE 1"=100'
FINAL MAPPING DATE: 4-11-86

2-B