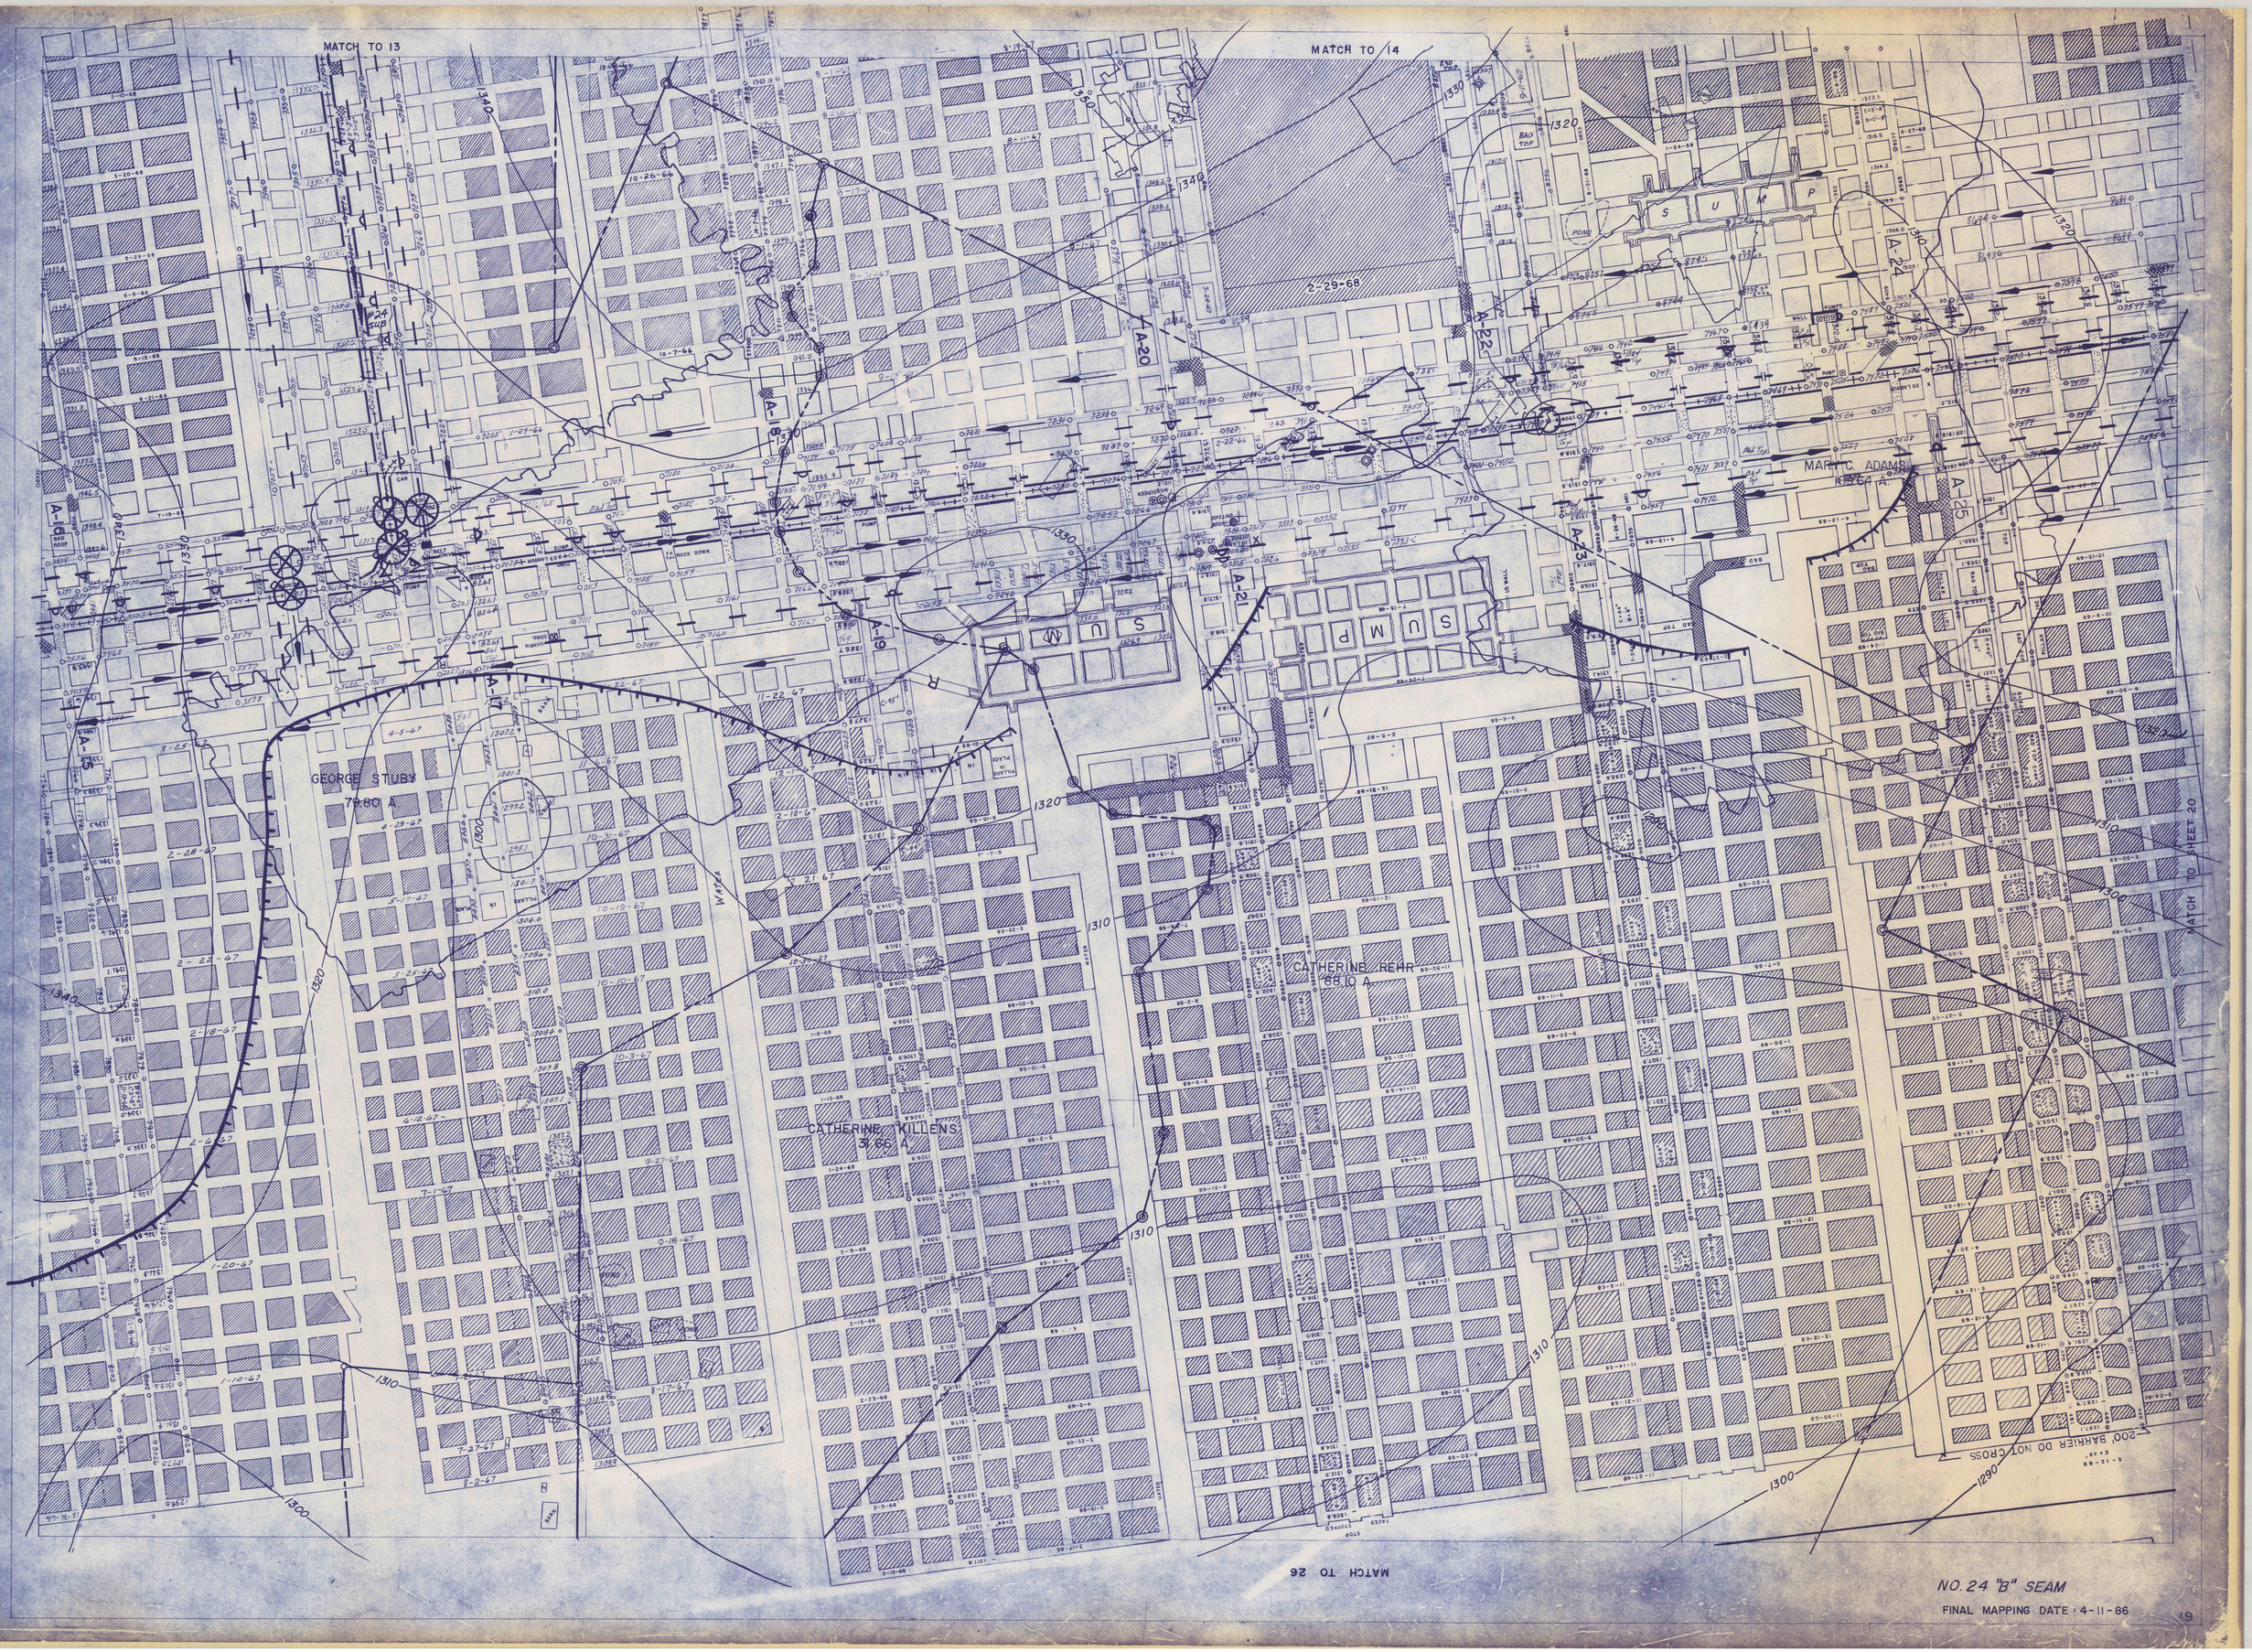
MATCH TO 13
MATCH TO 14
MATCH TO 18
MATCH TO 26
MATCH TO SHEET 20
GEORGE STUBY
79.80 A.
CATHERINE KILLENS
31.66 A.
CATHERINE REHR
88.10 A.
MARY C. ADAMS
109.64 A.
SUMP
200' BARRIER DO NOT CROSS
NO. 24 "B" SEAM
FINAL MAPPING DATE: 4-11-86