

WILLIAM SPRINGER  
50.00 A.


WILLIAM SPRINGER  
101.88 A.


MATCH TO SHEET 3F

WILLIAM SPRINGER  
35.95 A.

MATCH TO SHEET 3D

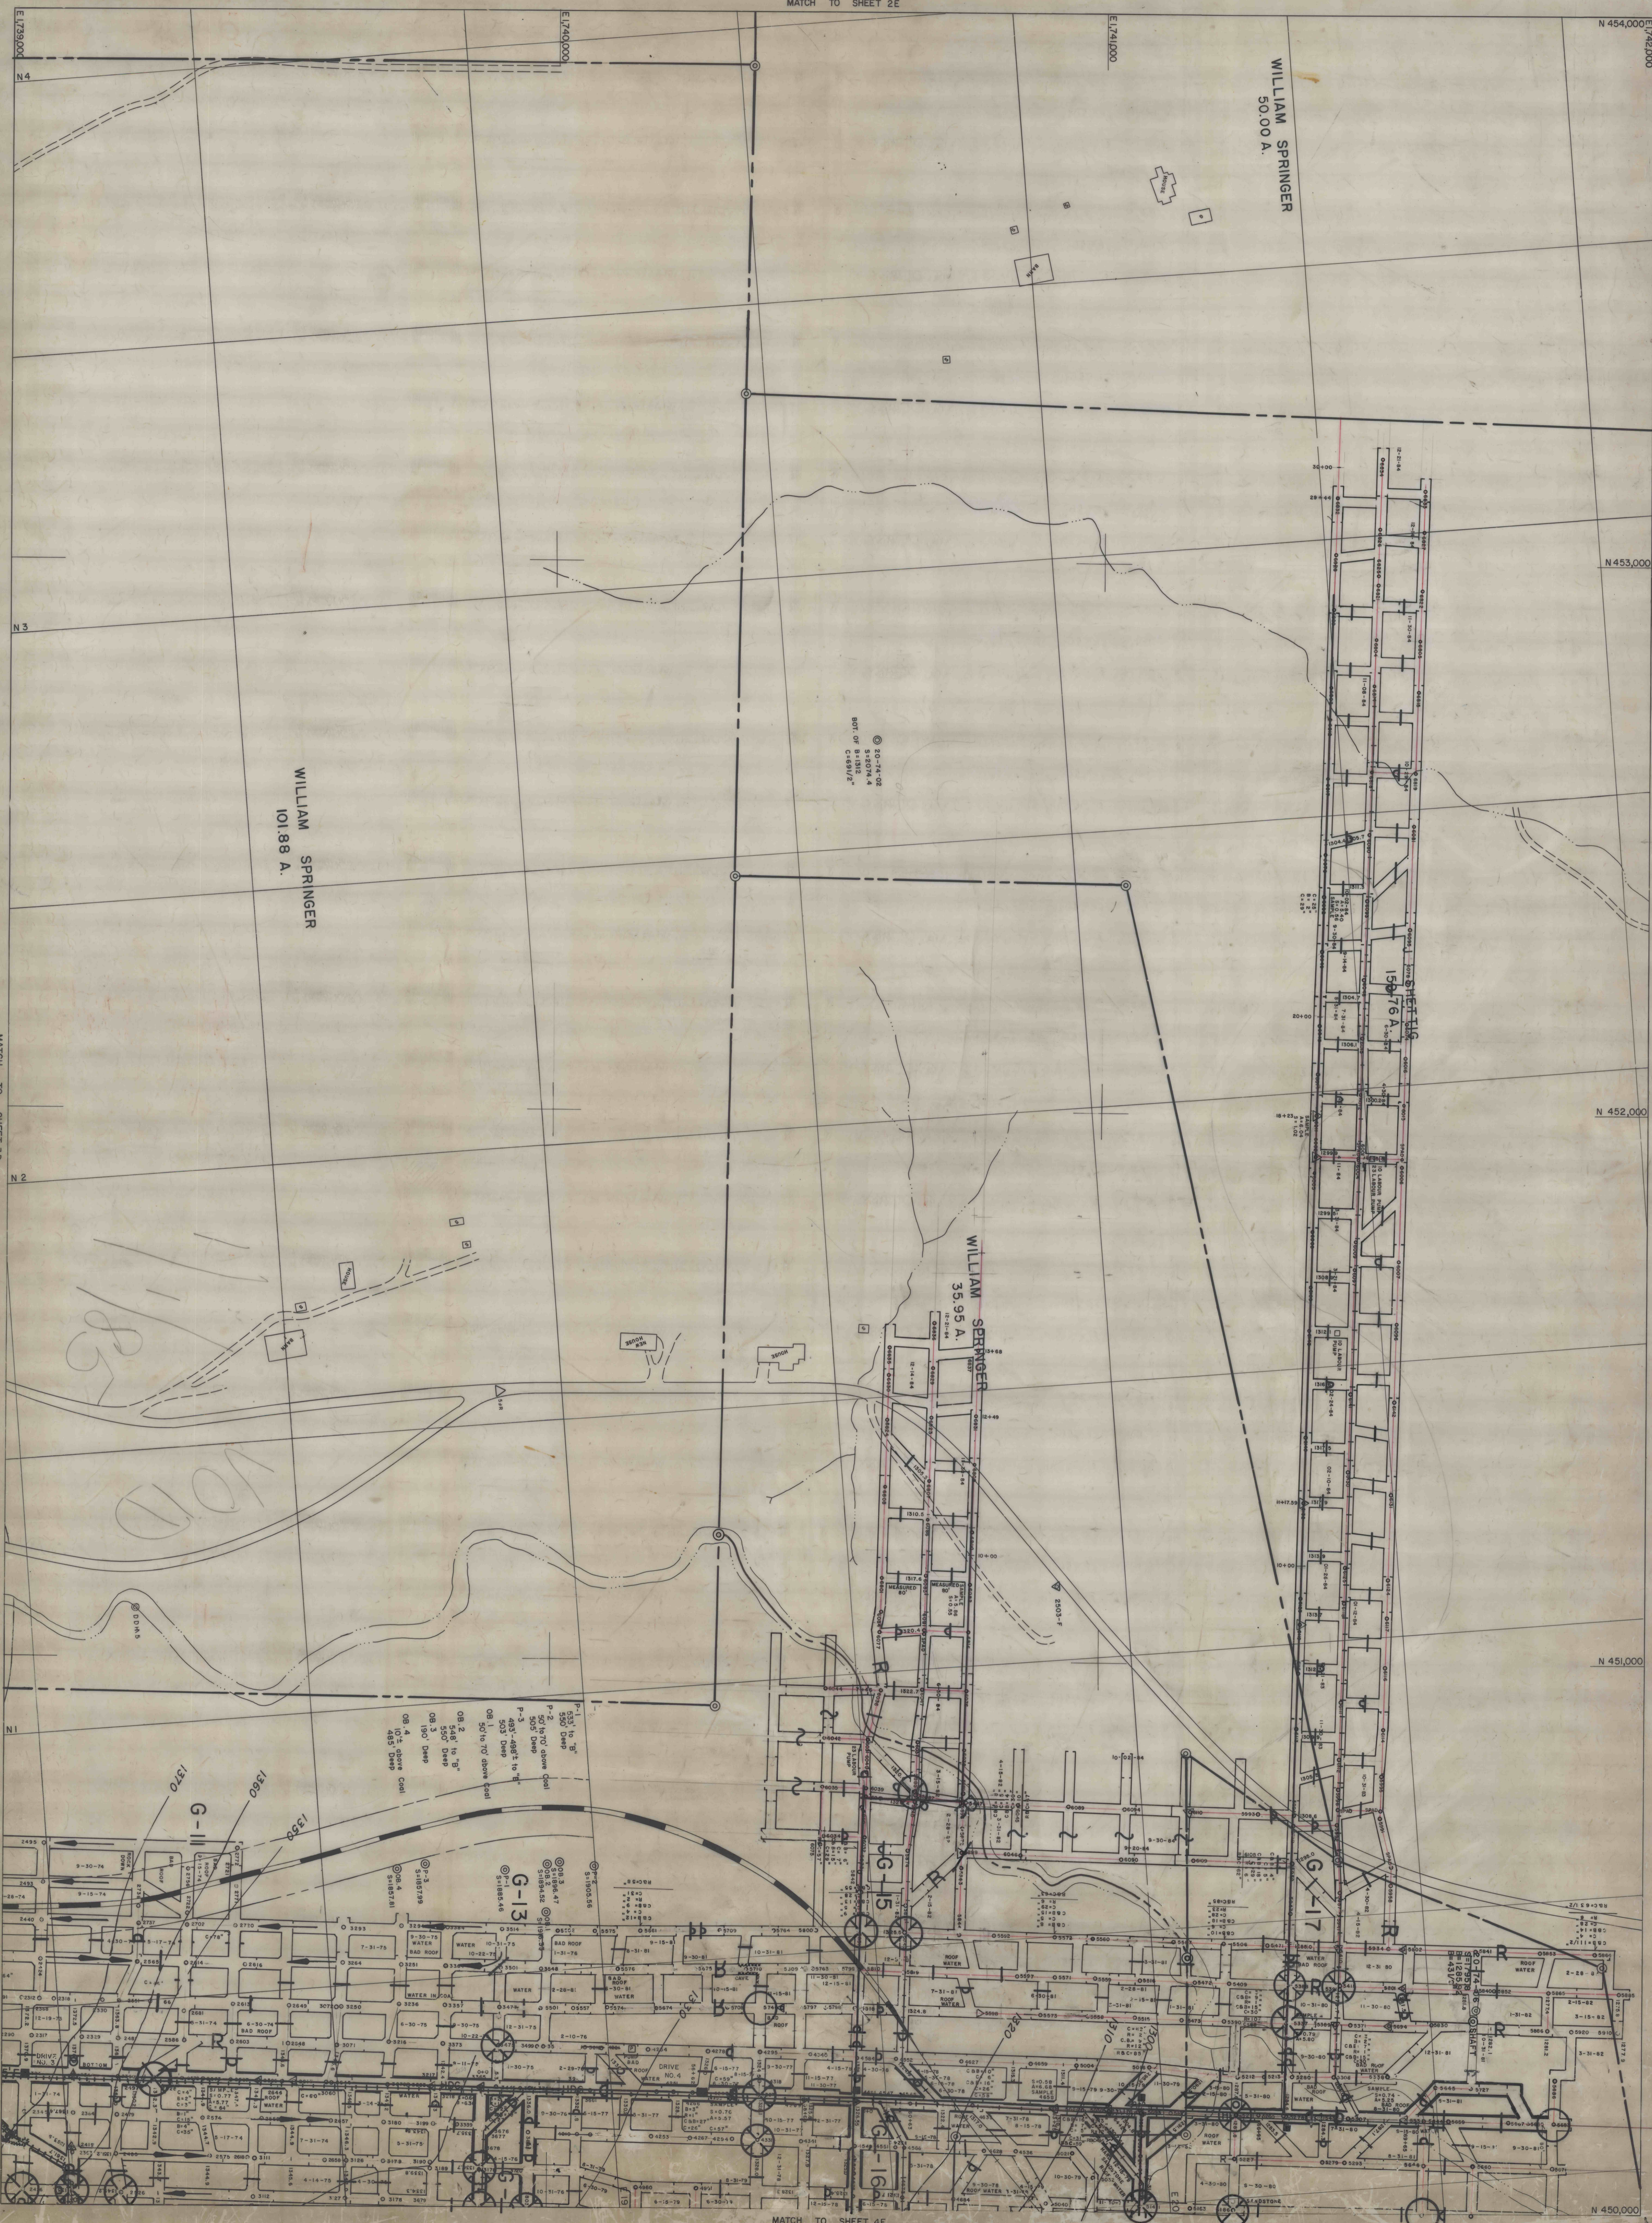

