

MATCH TO SHEET 3C

N 450,000



N 448,000

N 447,000

N 446,000

A.W. BASH
57 71 A

M.D. KITTELL
(ORIGINATOR)
69 96 A

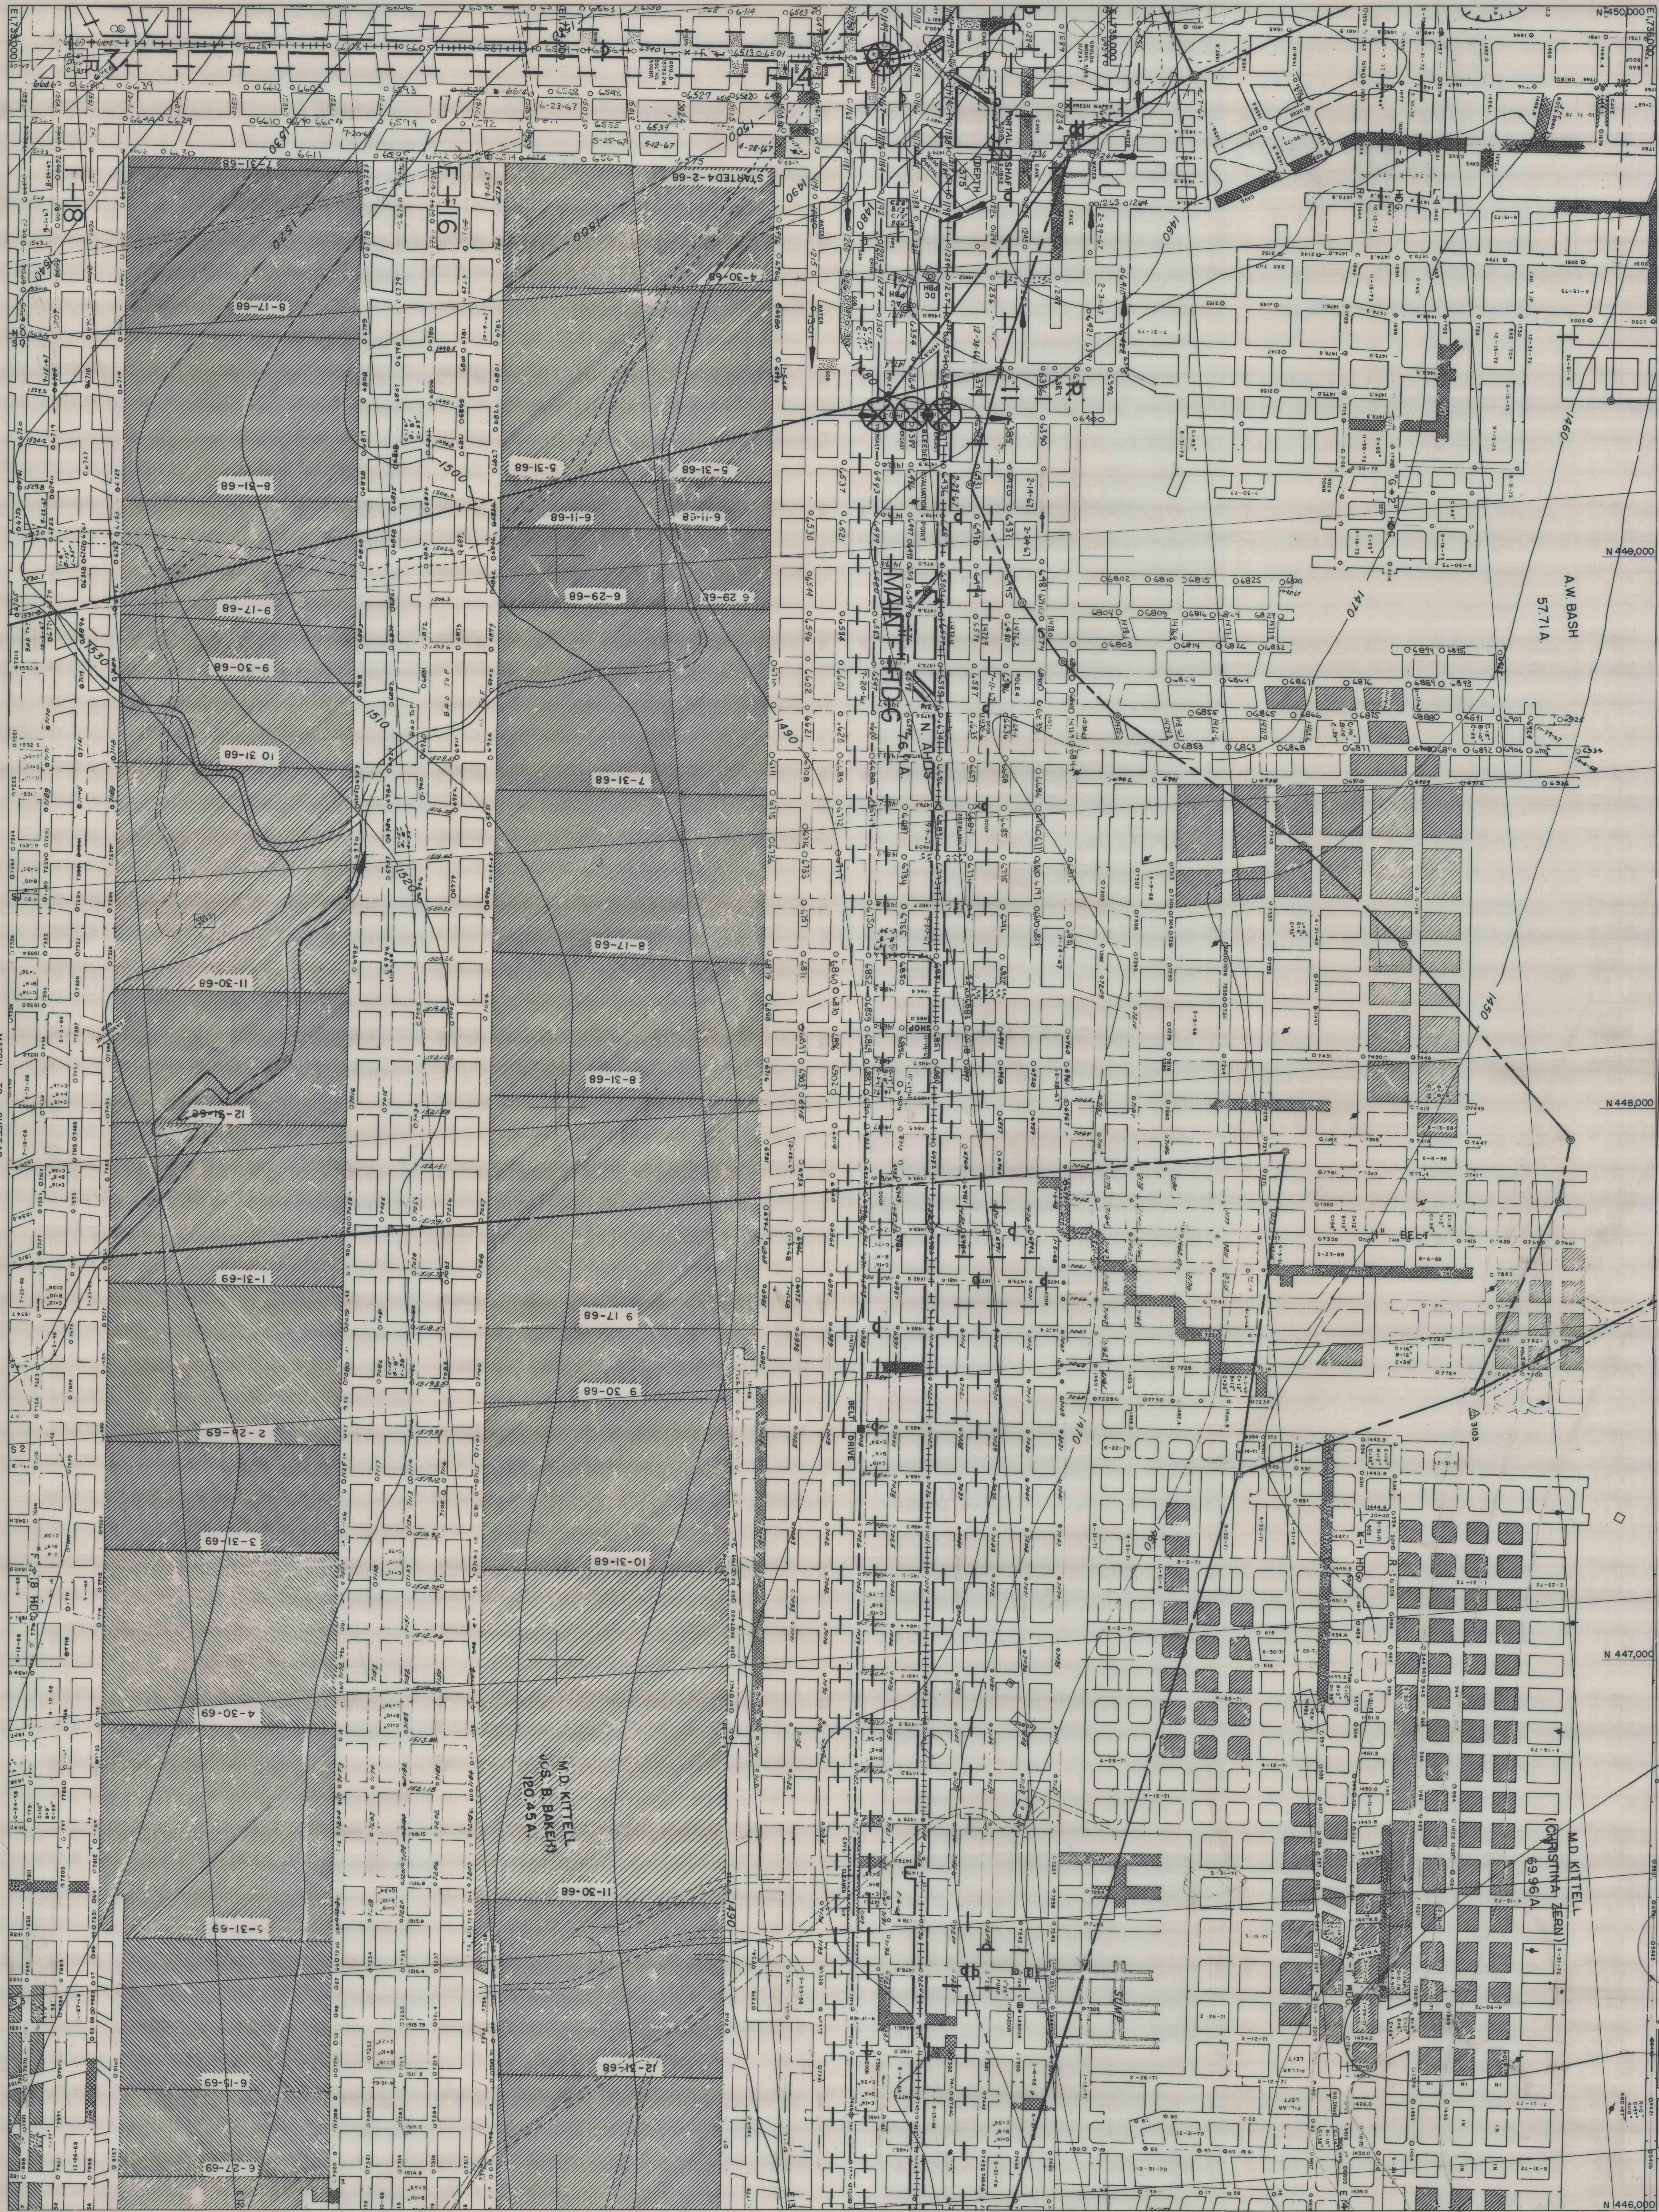

MATCH TO SHEET 5C

MATCH TO SHEET 4D

MATCH TO SHEET 8B



1010 BARNES & TUCKER COMPANY
 1010 LANCASHIRE NO. 20 MINE
 EAST CARROLL TOWNSHIP, CAMBRIA COUNTY, PENNSYLVANIA
 SCALE 1"=100'
 DATE JULY, 1976

