

MATCH TO SHEET 5D



N 442,000
E 1739,000

1344.72

N 441,000

N 439,000

MATCH TO SHEET 6E

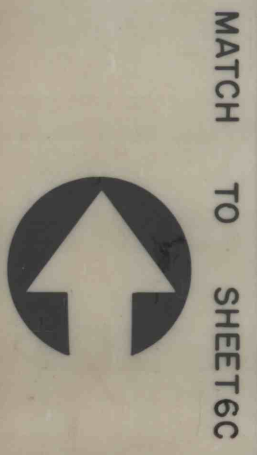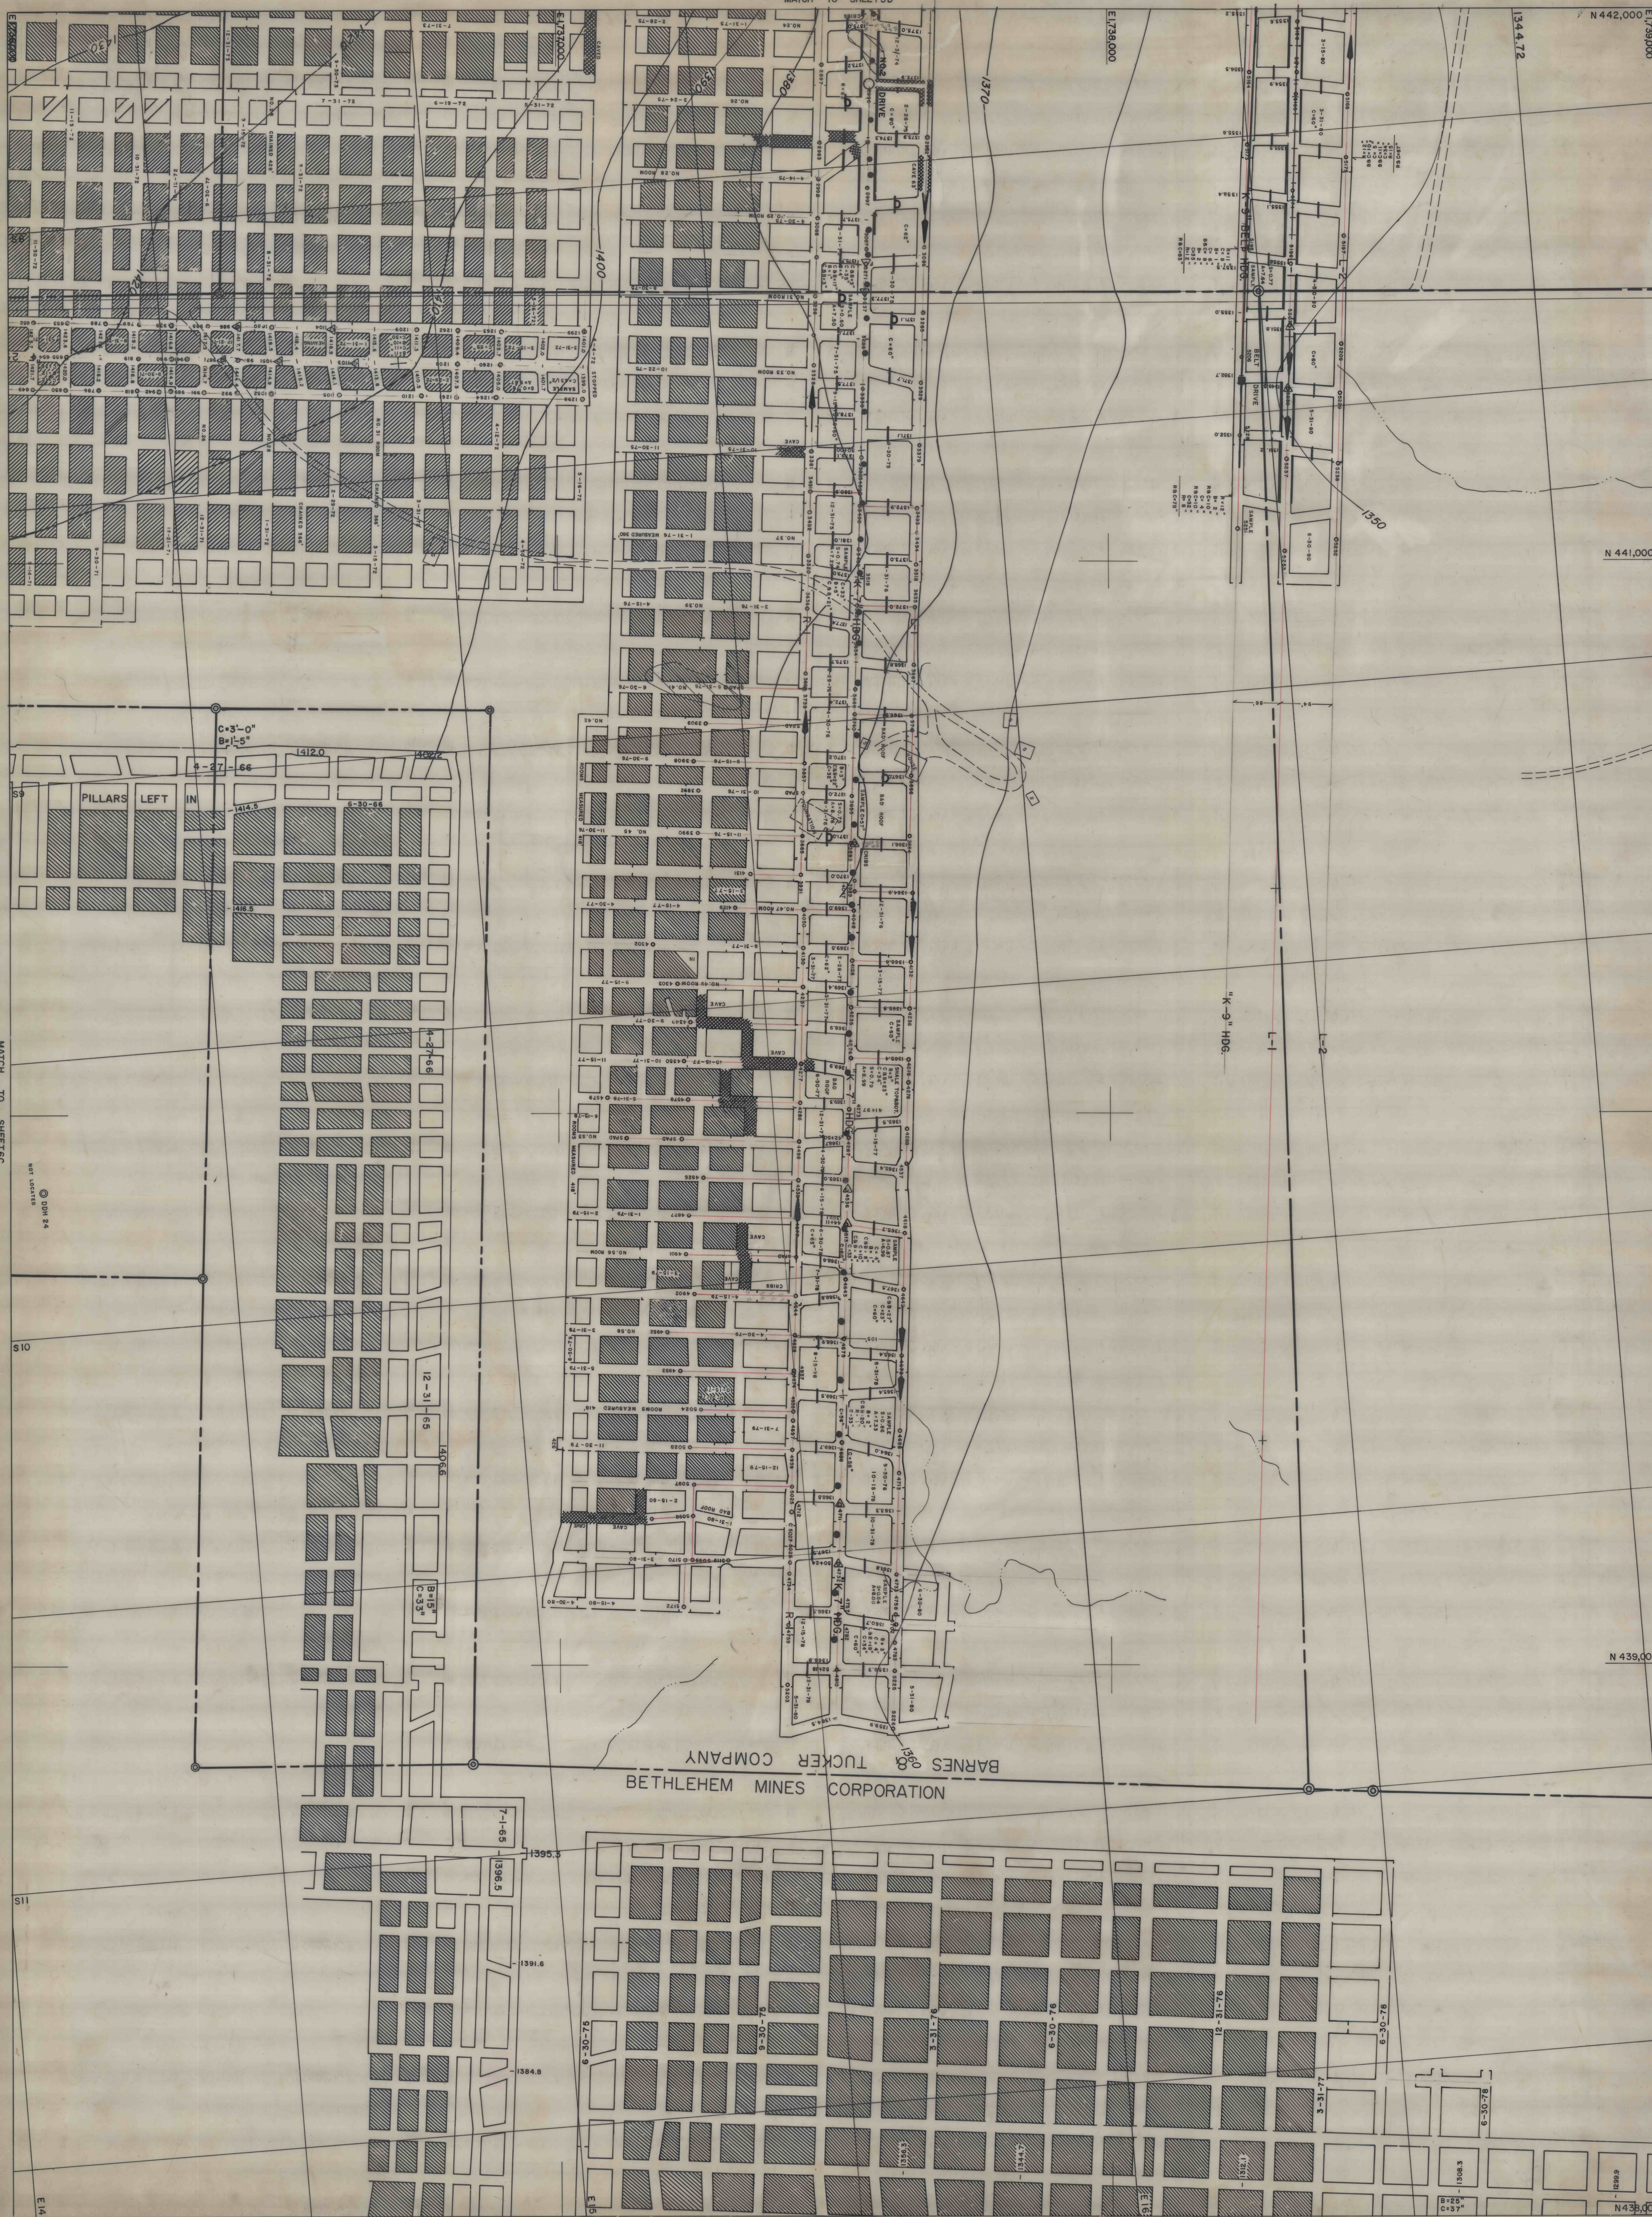

MATCH TO SHEET 6C

BARNES & TUCKER COMPANY
 LAMCASHIRE NO. 20 MINE
 EAST CARROLL TOWNSHIP, CAMBRIA COUNTY, PENNSYLVANIA
 SCALE: 1"=100'
 DATE: JULY, 1976