

N 446,000
E 1742,000

N 445,000

N 444,000

N 443,000

N 442,000

E 1741,000

E 1740,000

SIMON ILLIG
58.07 A.

AUGUSTINE STRITTMATTER
206.0 A.

JAMES PHALEN
126.52 A.

20-59-03
SURF 20230
90107-9-1335-658

RIDER COAL APPROX.
OF ABOV
COAL EBM

AUGUSTINE STRITTMATTER
206.0 A.

STRITTMATTER
1330

206.0 A.












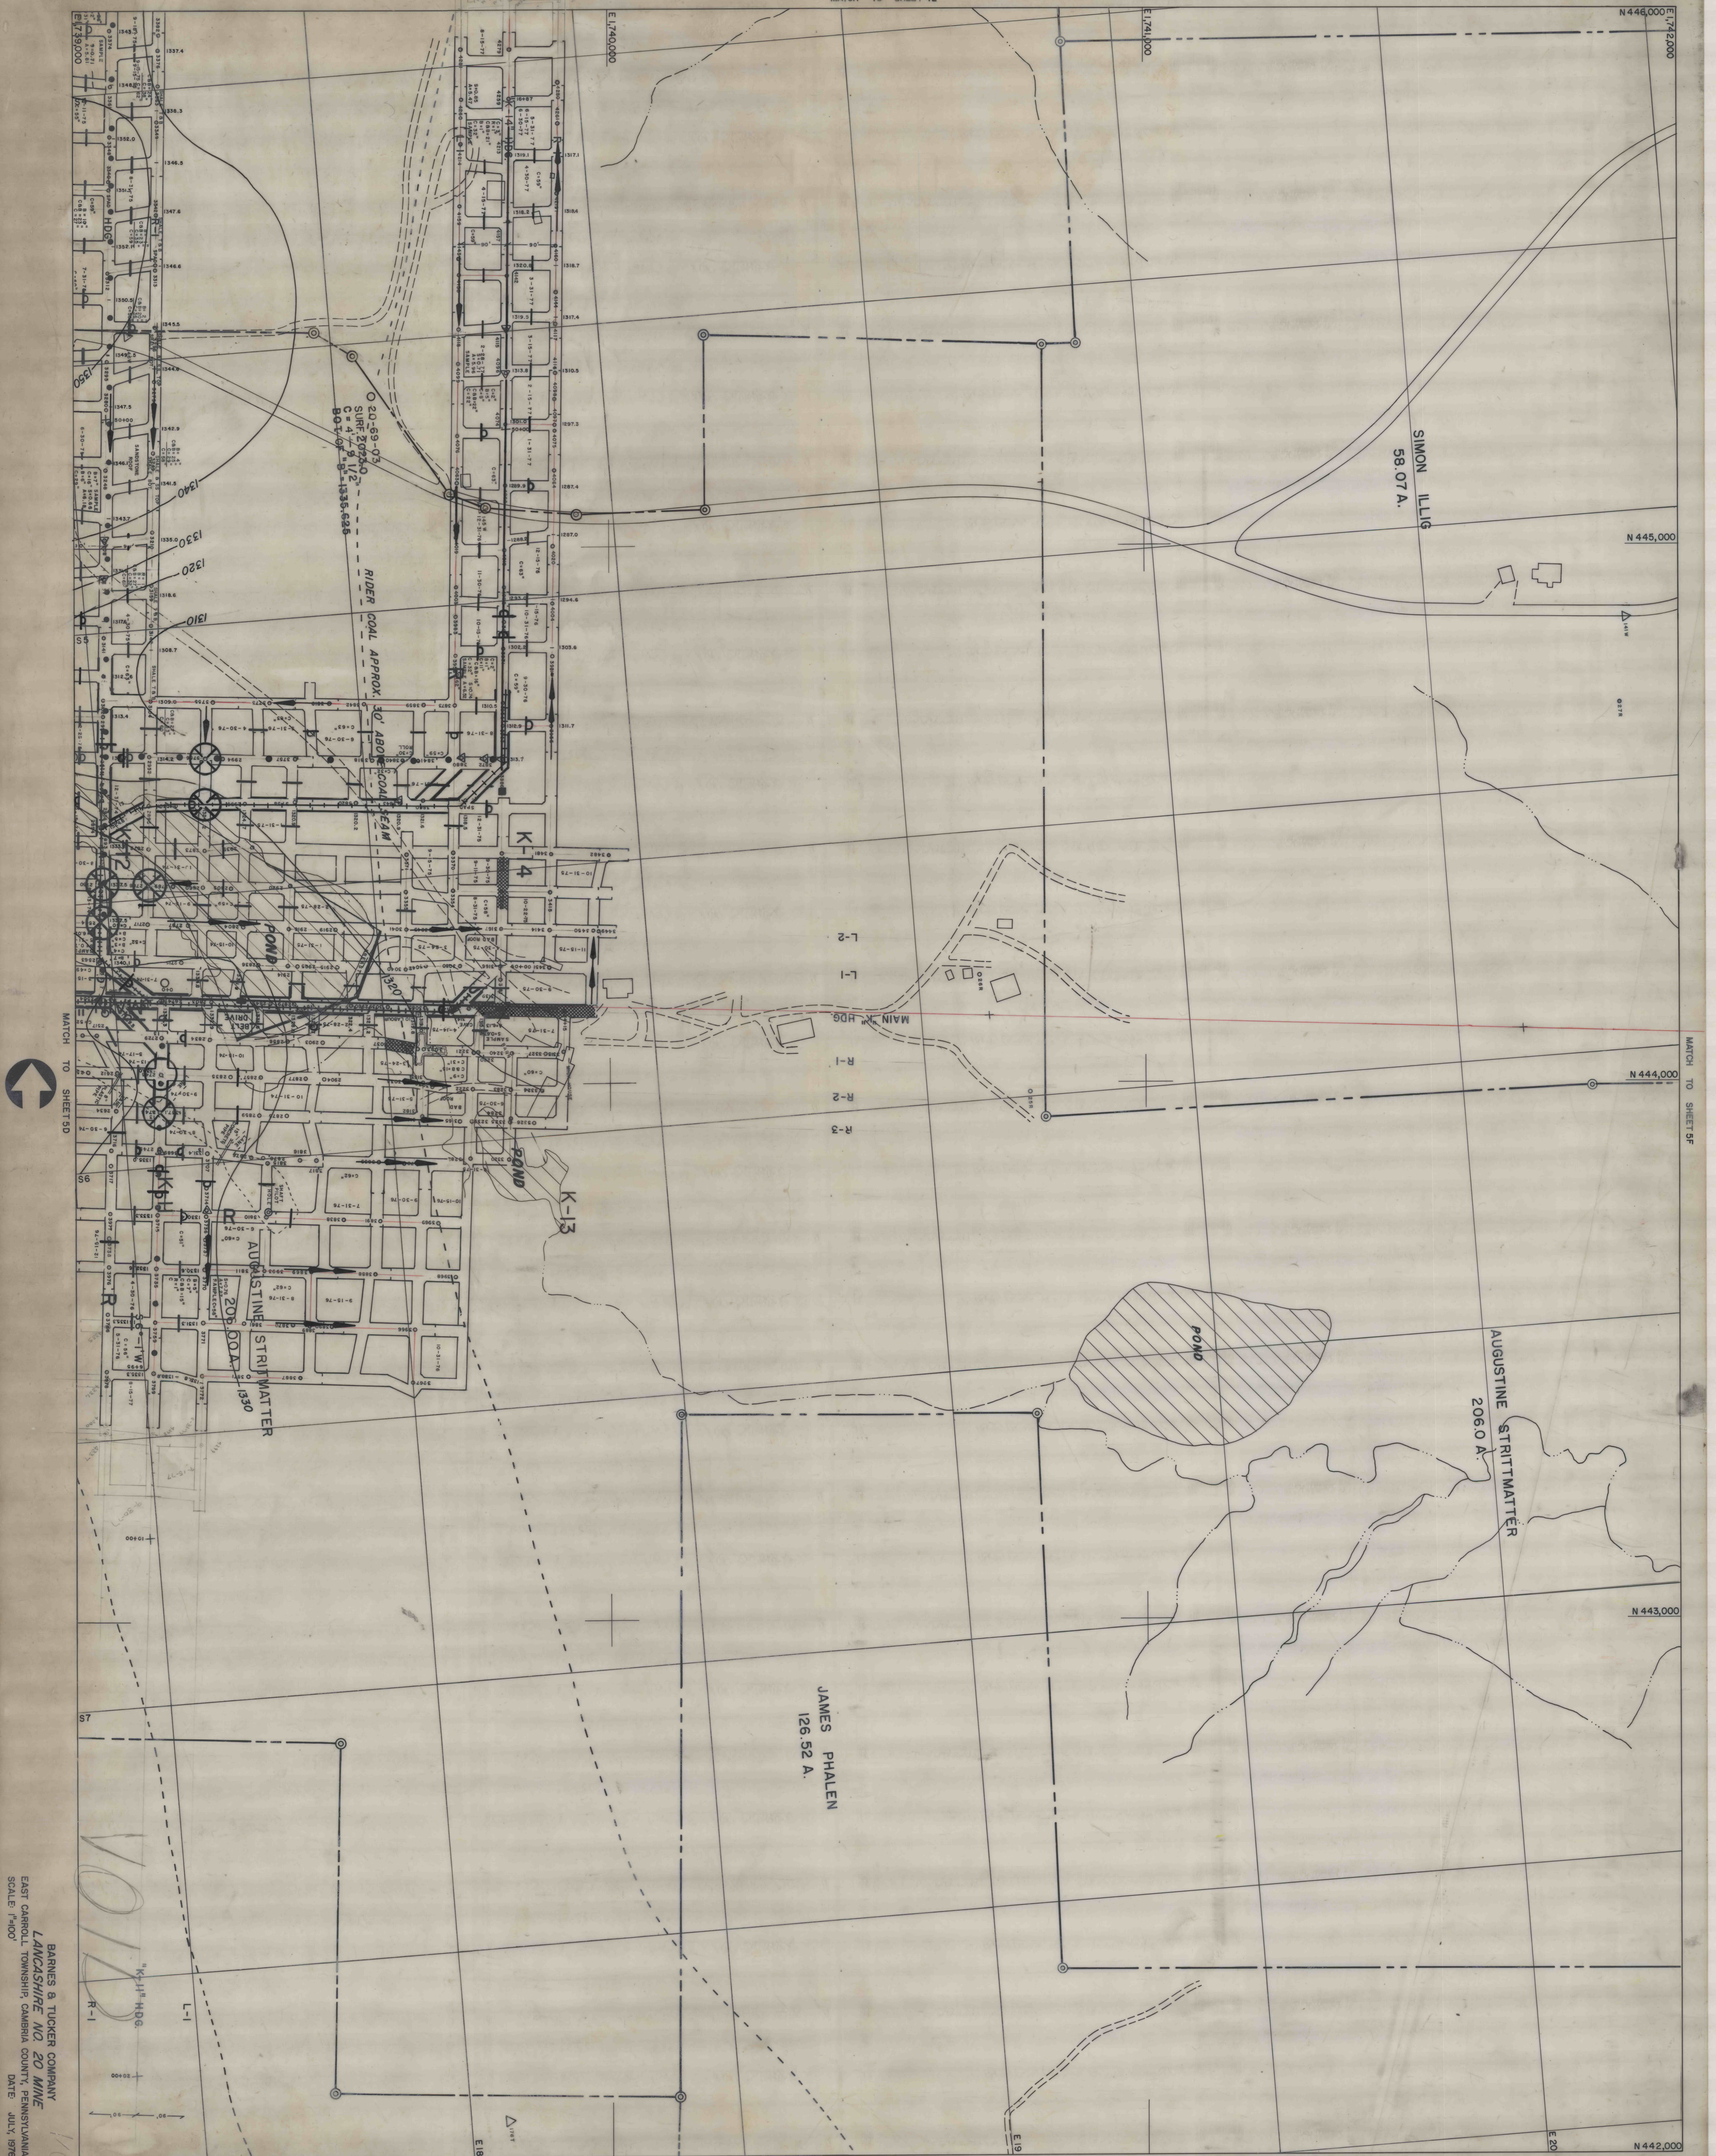

MATCH TO SHEET 5D

MATCH TO SHEET 5F

MATCH TO SHEET 6E

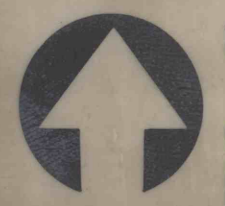

BARNES & TUCKER COMPANY
LANCASHIRE NO. 20 MINE
EAST CARROLL TOWNSHIP, CAMBERIA COUNTY, PENNSYLVANIA
SCALE: 1"=100'
DATE: JULY, 1976

