


MATCH TO SHEET 3B

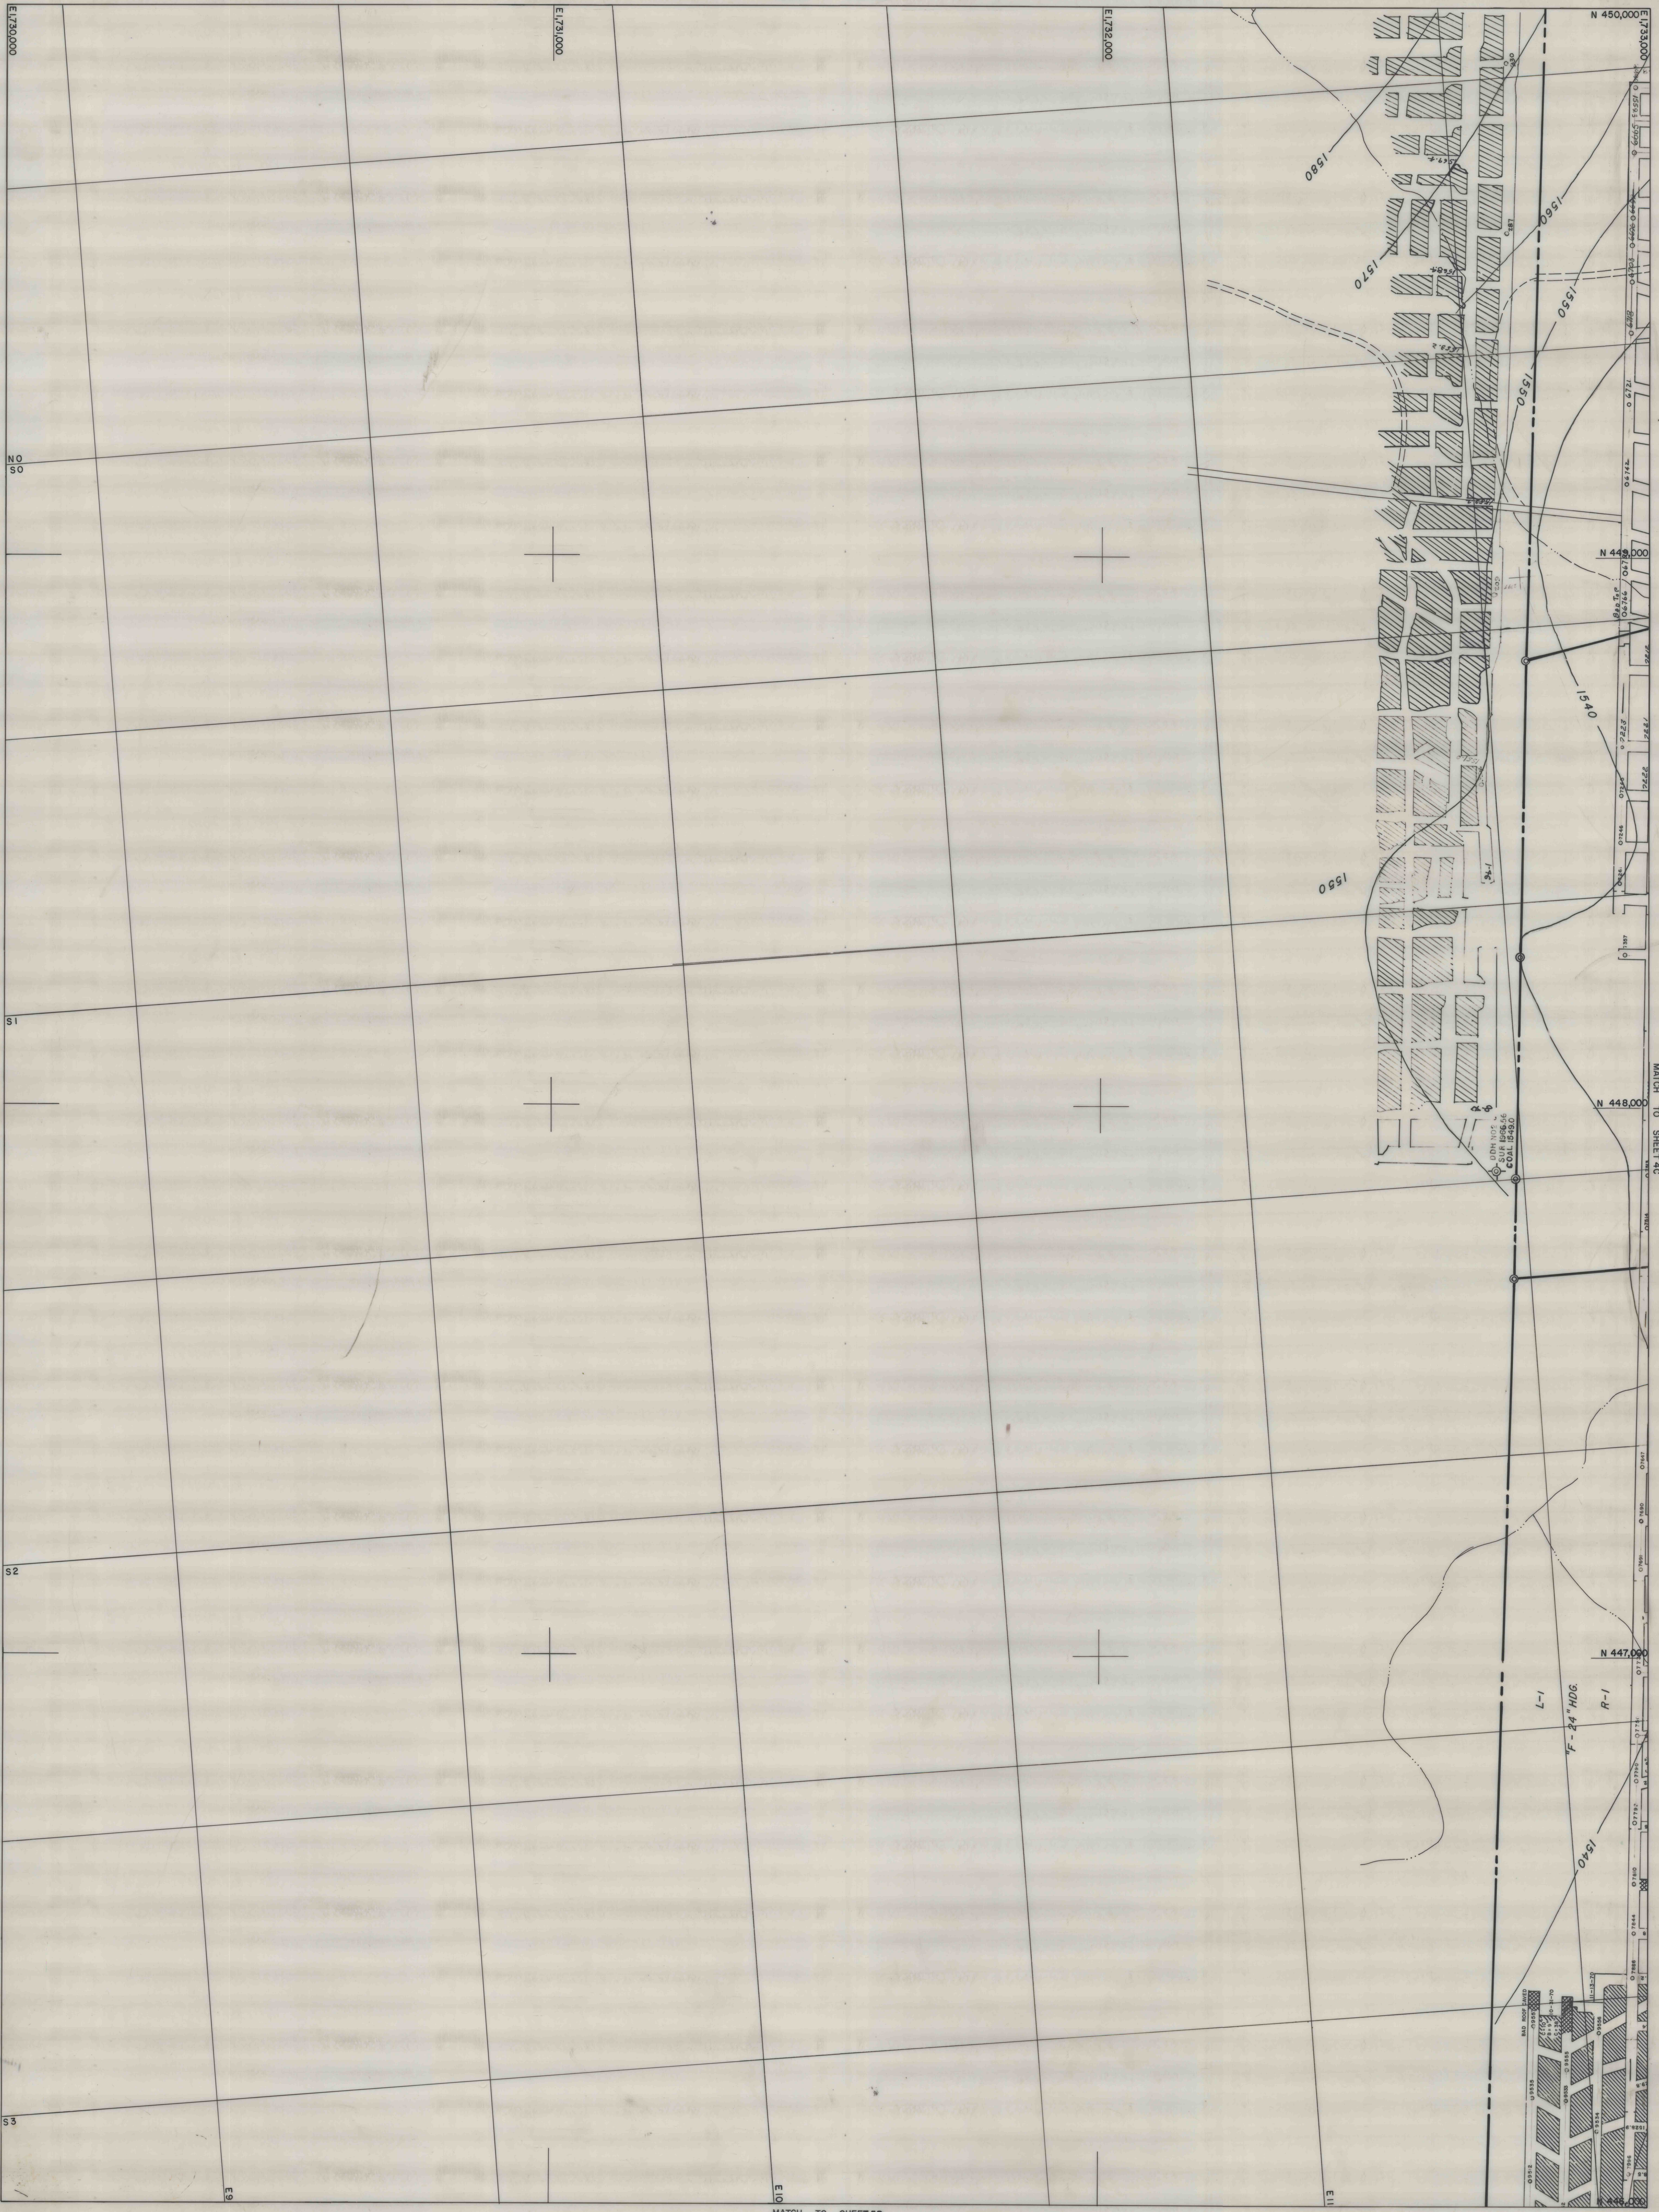

N 450,000

N 448,000

N 448,000

N 447,000

E 1730,000

E 1731,000

E 1732,000

N 0

S 1

S 2

S 3

MATCH TO SHEET 5B

MATCH TO SHEET 4C

FINAL MAPPING DATE: 01-29-86
4420

BARNES & TUCKER COMPANY
LANCASHIRE NO. 20 MINE
EAST CARROLL TOWNSHIP, CAMBRIA COUNTY, PENNSYLVANIA
SCALE: 1"=100'
DATE: JULY, 1976