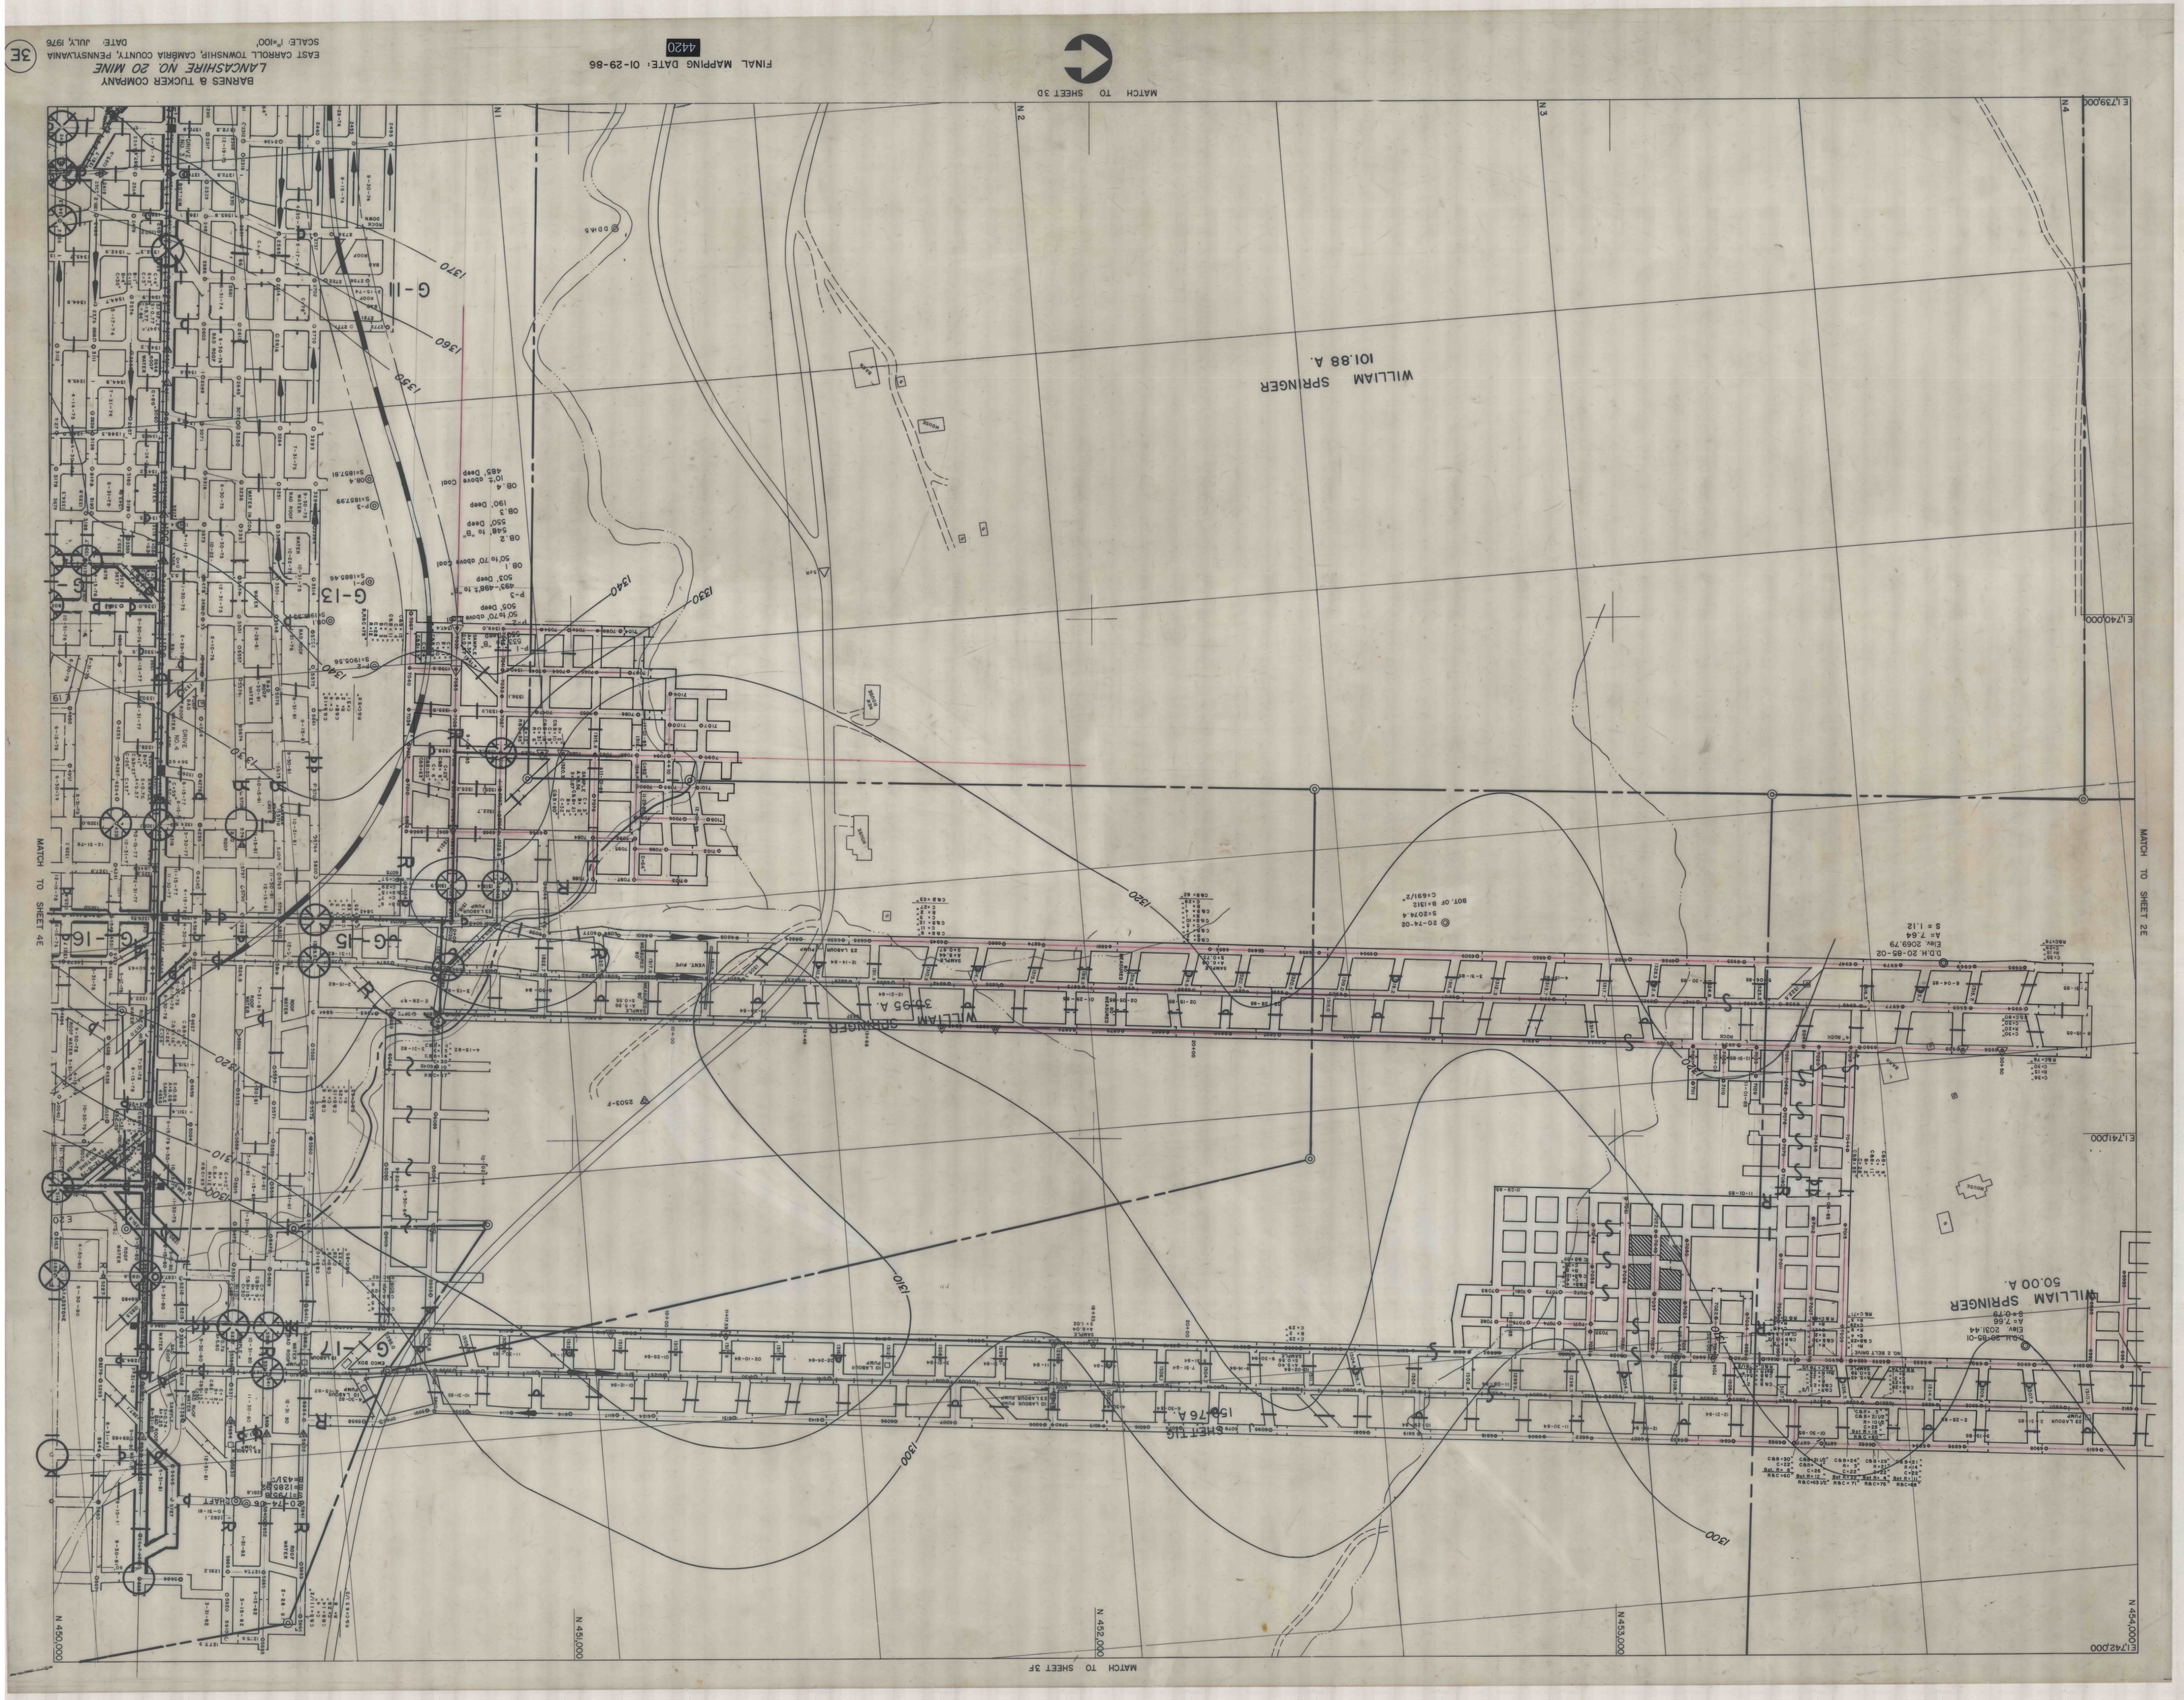

BARNES & TUCKER COMPANY
LANCASHIRE NO. 20 MINE
EAST CARROLL TOWNSHIP, CAMBRIA COUNTY, PENNSYLVANIA
SCALE: 1"=100'
DATE: JULY, 1976
3E
FINAL MAPPING DATE: 01-29-86
4420
MATCH TO SHEET 3D
MATCH TO SHEET 3F
MATCH TO SHEET 4E
MATCH TO SHEET 2E
WILLIAM SPRINGER
101.88 A.
WILLIAM SPRINGER
35.95 A.
WILLIAM SPRINGER
50.00 A.
SHEET 16
150.76 A.
G-11
G-13
G-15
G-16
G-17
N 450,000
N 451,000
N 452,000
N 453,000
N 454,000
E 1,739,000
E 1,740,000
E 1,741,000
E 1,742,000