


MATCH TO SHEET 4E

N 446,000
E 174,000

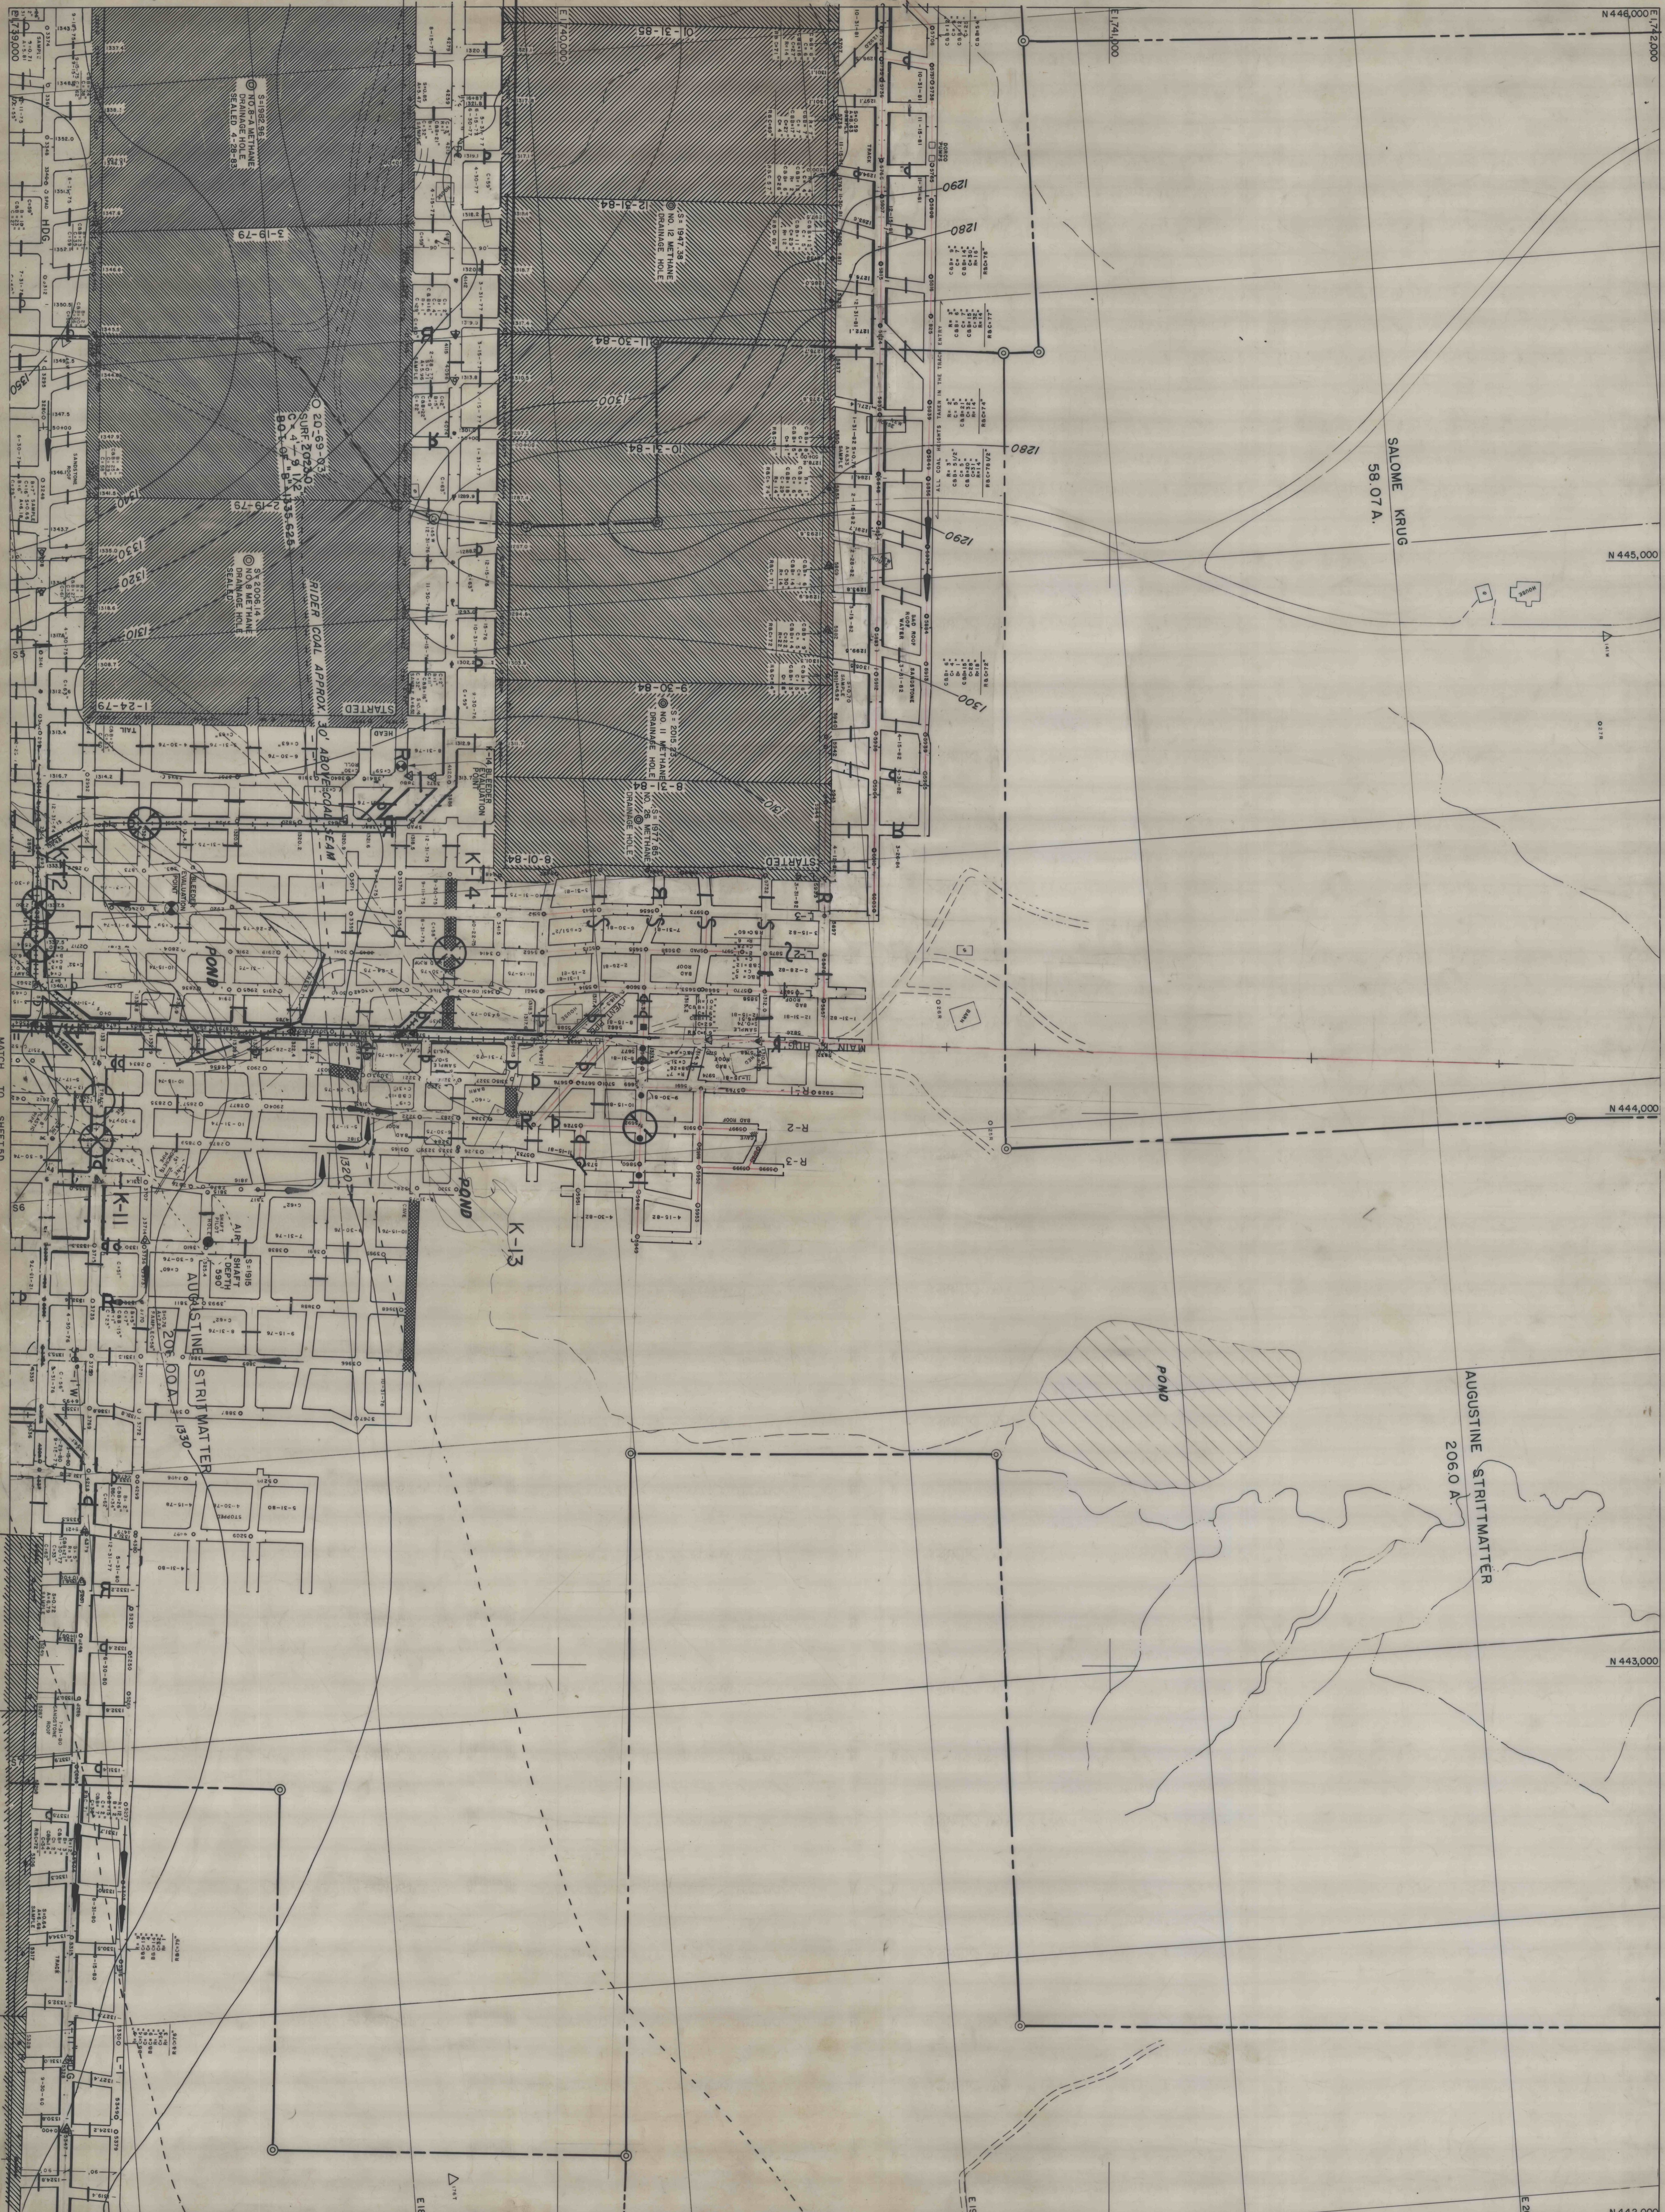

N 445,000

N 444,000

N 443,000

N 442,000

MATCH TO SHEET 9F

MARCH TO SHEET 6E



MATCH TO SHEET 5D

FINAL MAPPING DATE: 01-29-86

4420

BARNES & TUCKER COMPANY
 LANCASTER NO. 20 MINE
 EAST CARROLL TOWNSHIP, CAMBRIA COUNTY, PENNSYLVANIA
 SCALE: 1"=100'
 DATE: JULY, 1976

5E