

MATCH TO SHEET 46

E 1,748,000
N 446,000

E 1,747,000

E 1,746,000


E 1,745,000

N 445,000

N 444,000

N 443,000

N 442,000

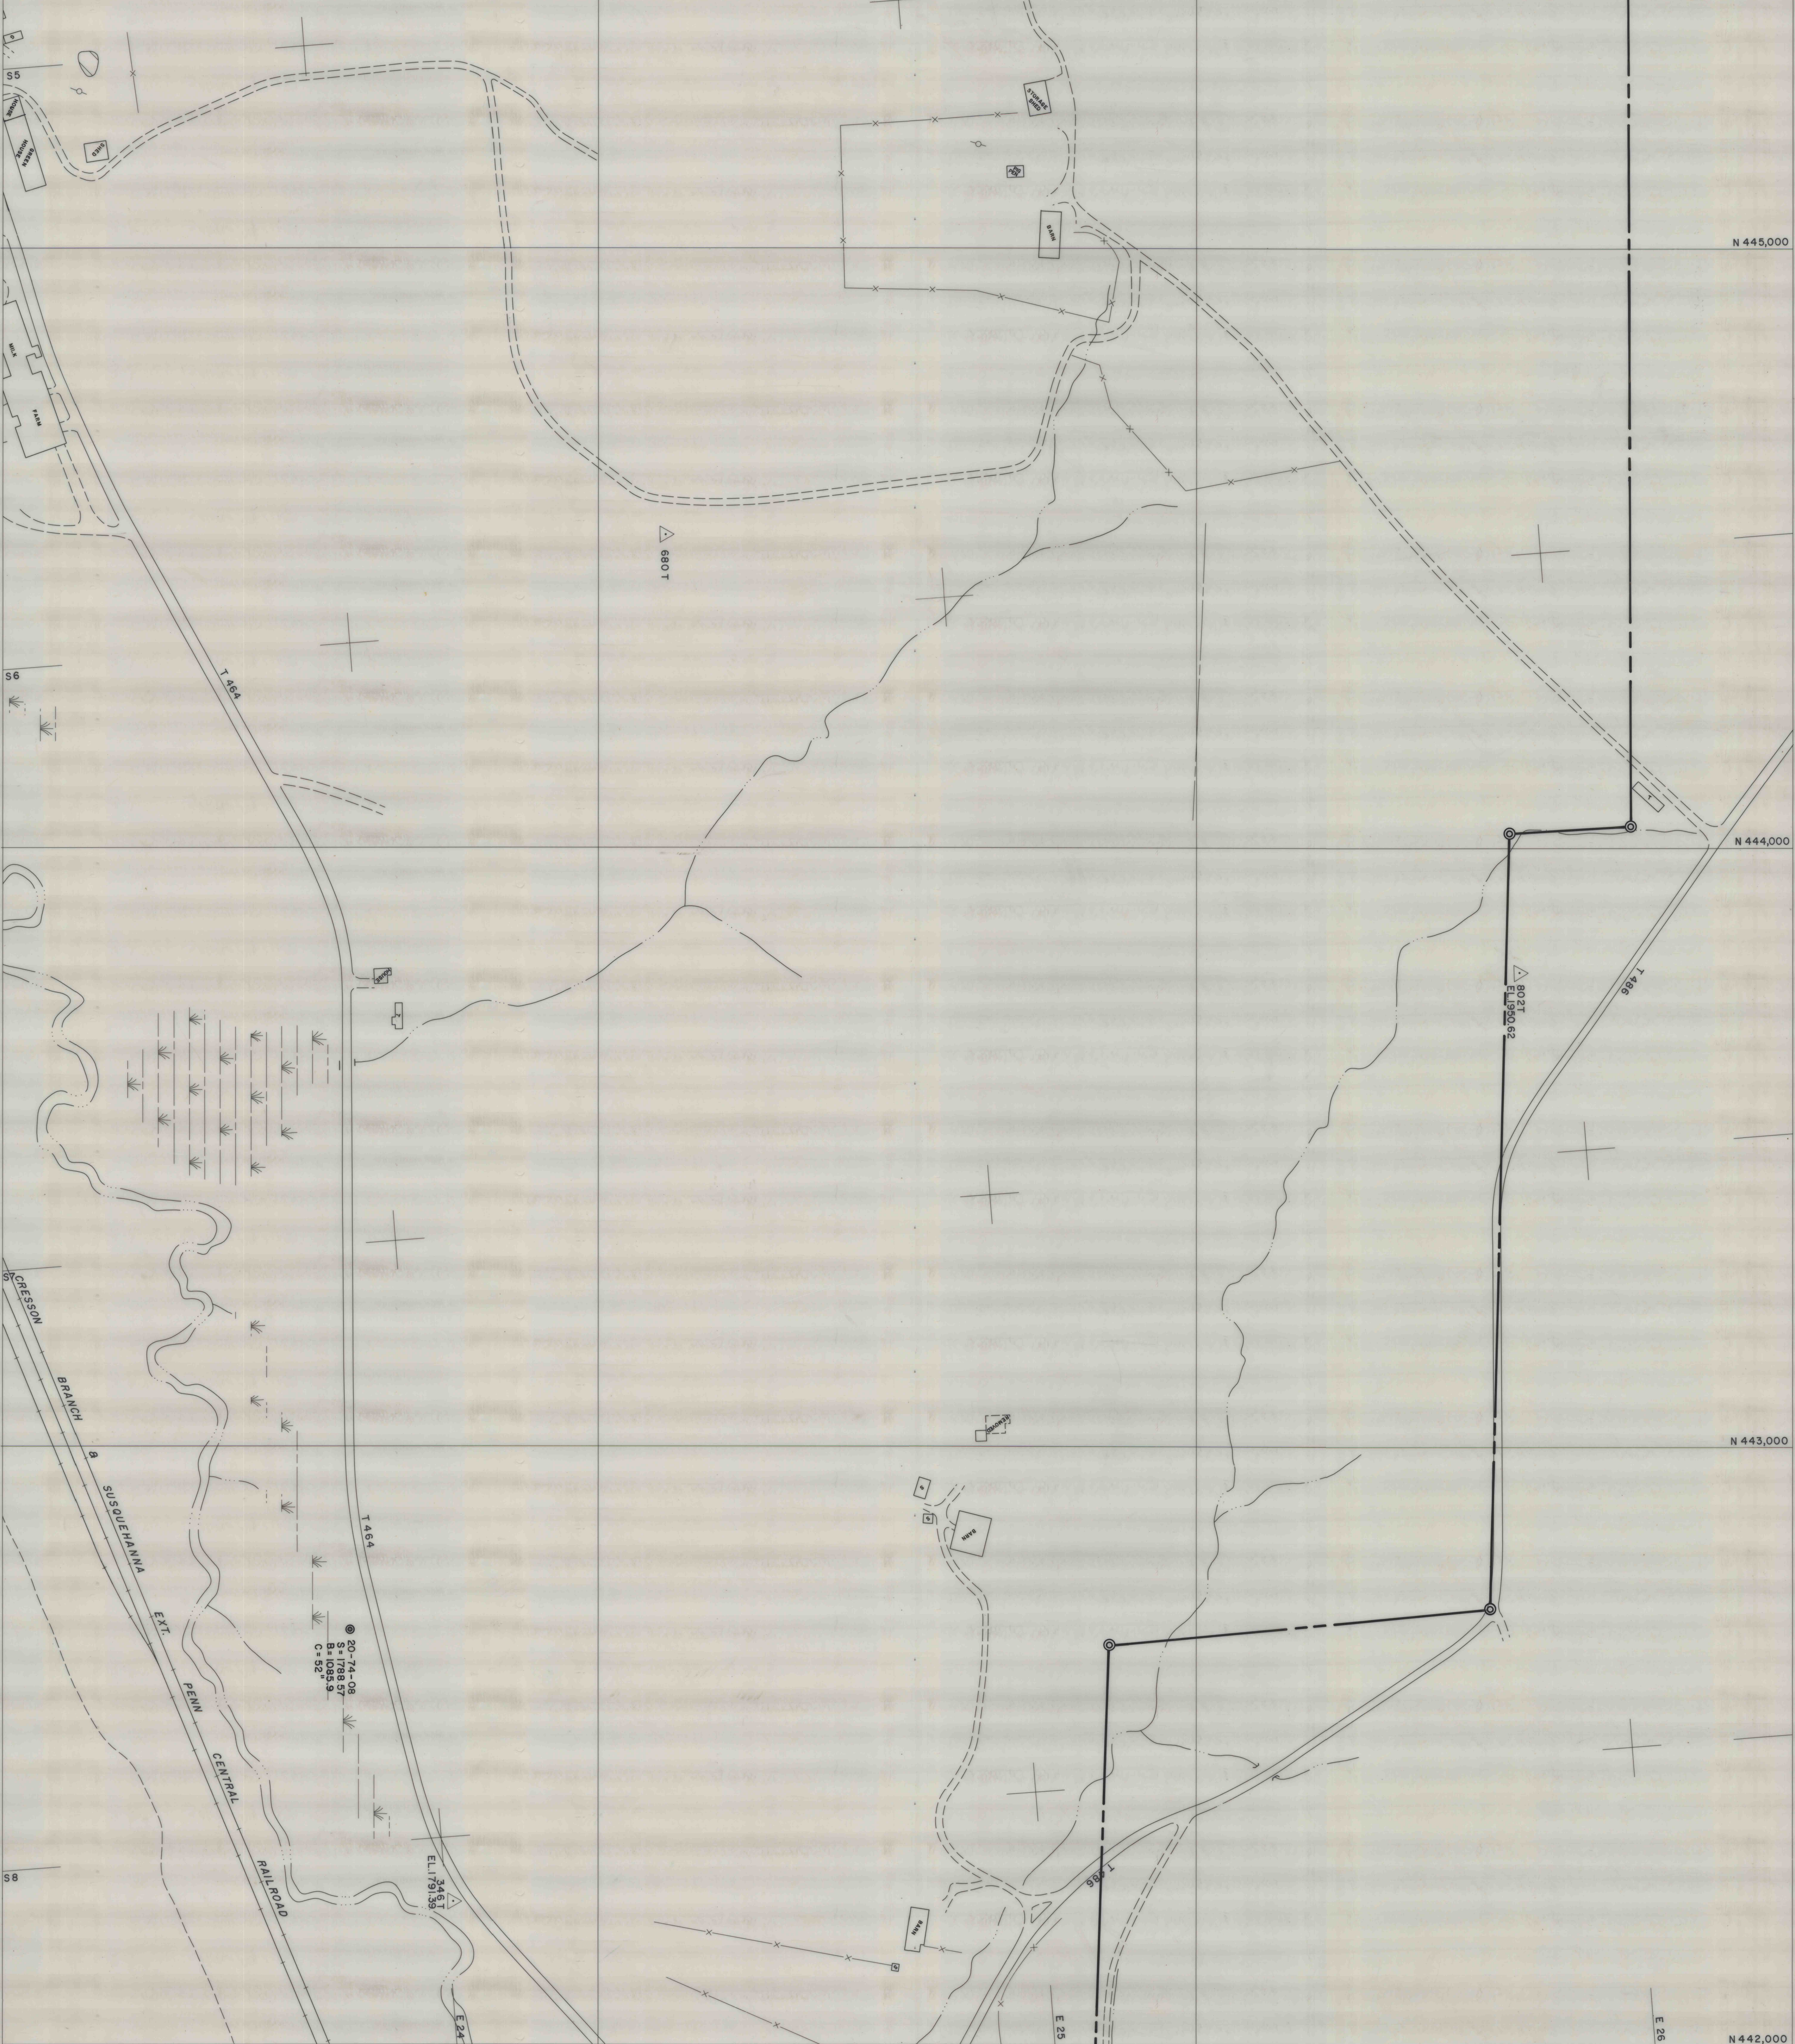

MATCH TO SHEET 5F



FINAL MAPPING DATE 01-29-86

4420

BARNES & TUCKER COMPANY
 LANCASTER NO. 20 MINE
 EAST CARROLL TOWNSHIP, CAMBRIA COUNTY, PENNSYLVANIA
 SCALE 1"=100'
 DATE JULY 1976

56

MATCH TO SHEET 66