


MATCH TO SHEET 36

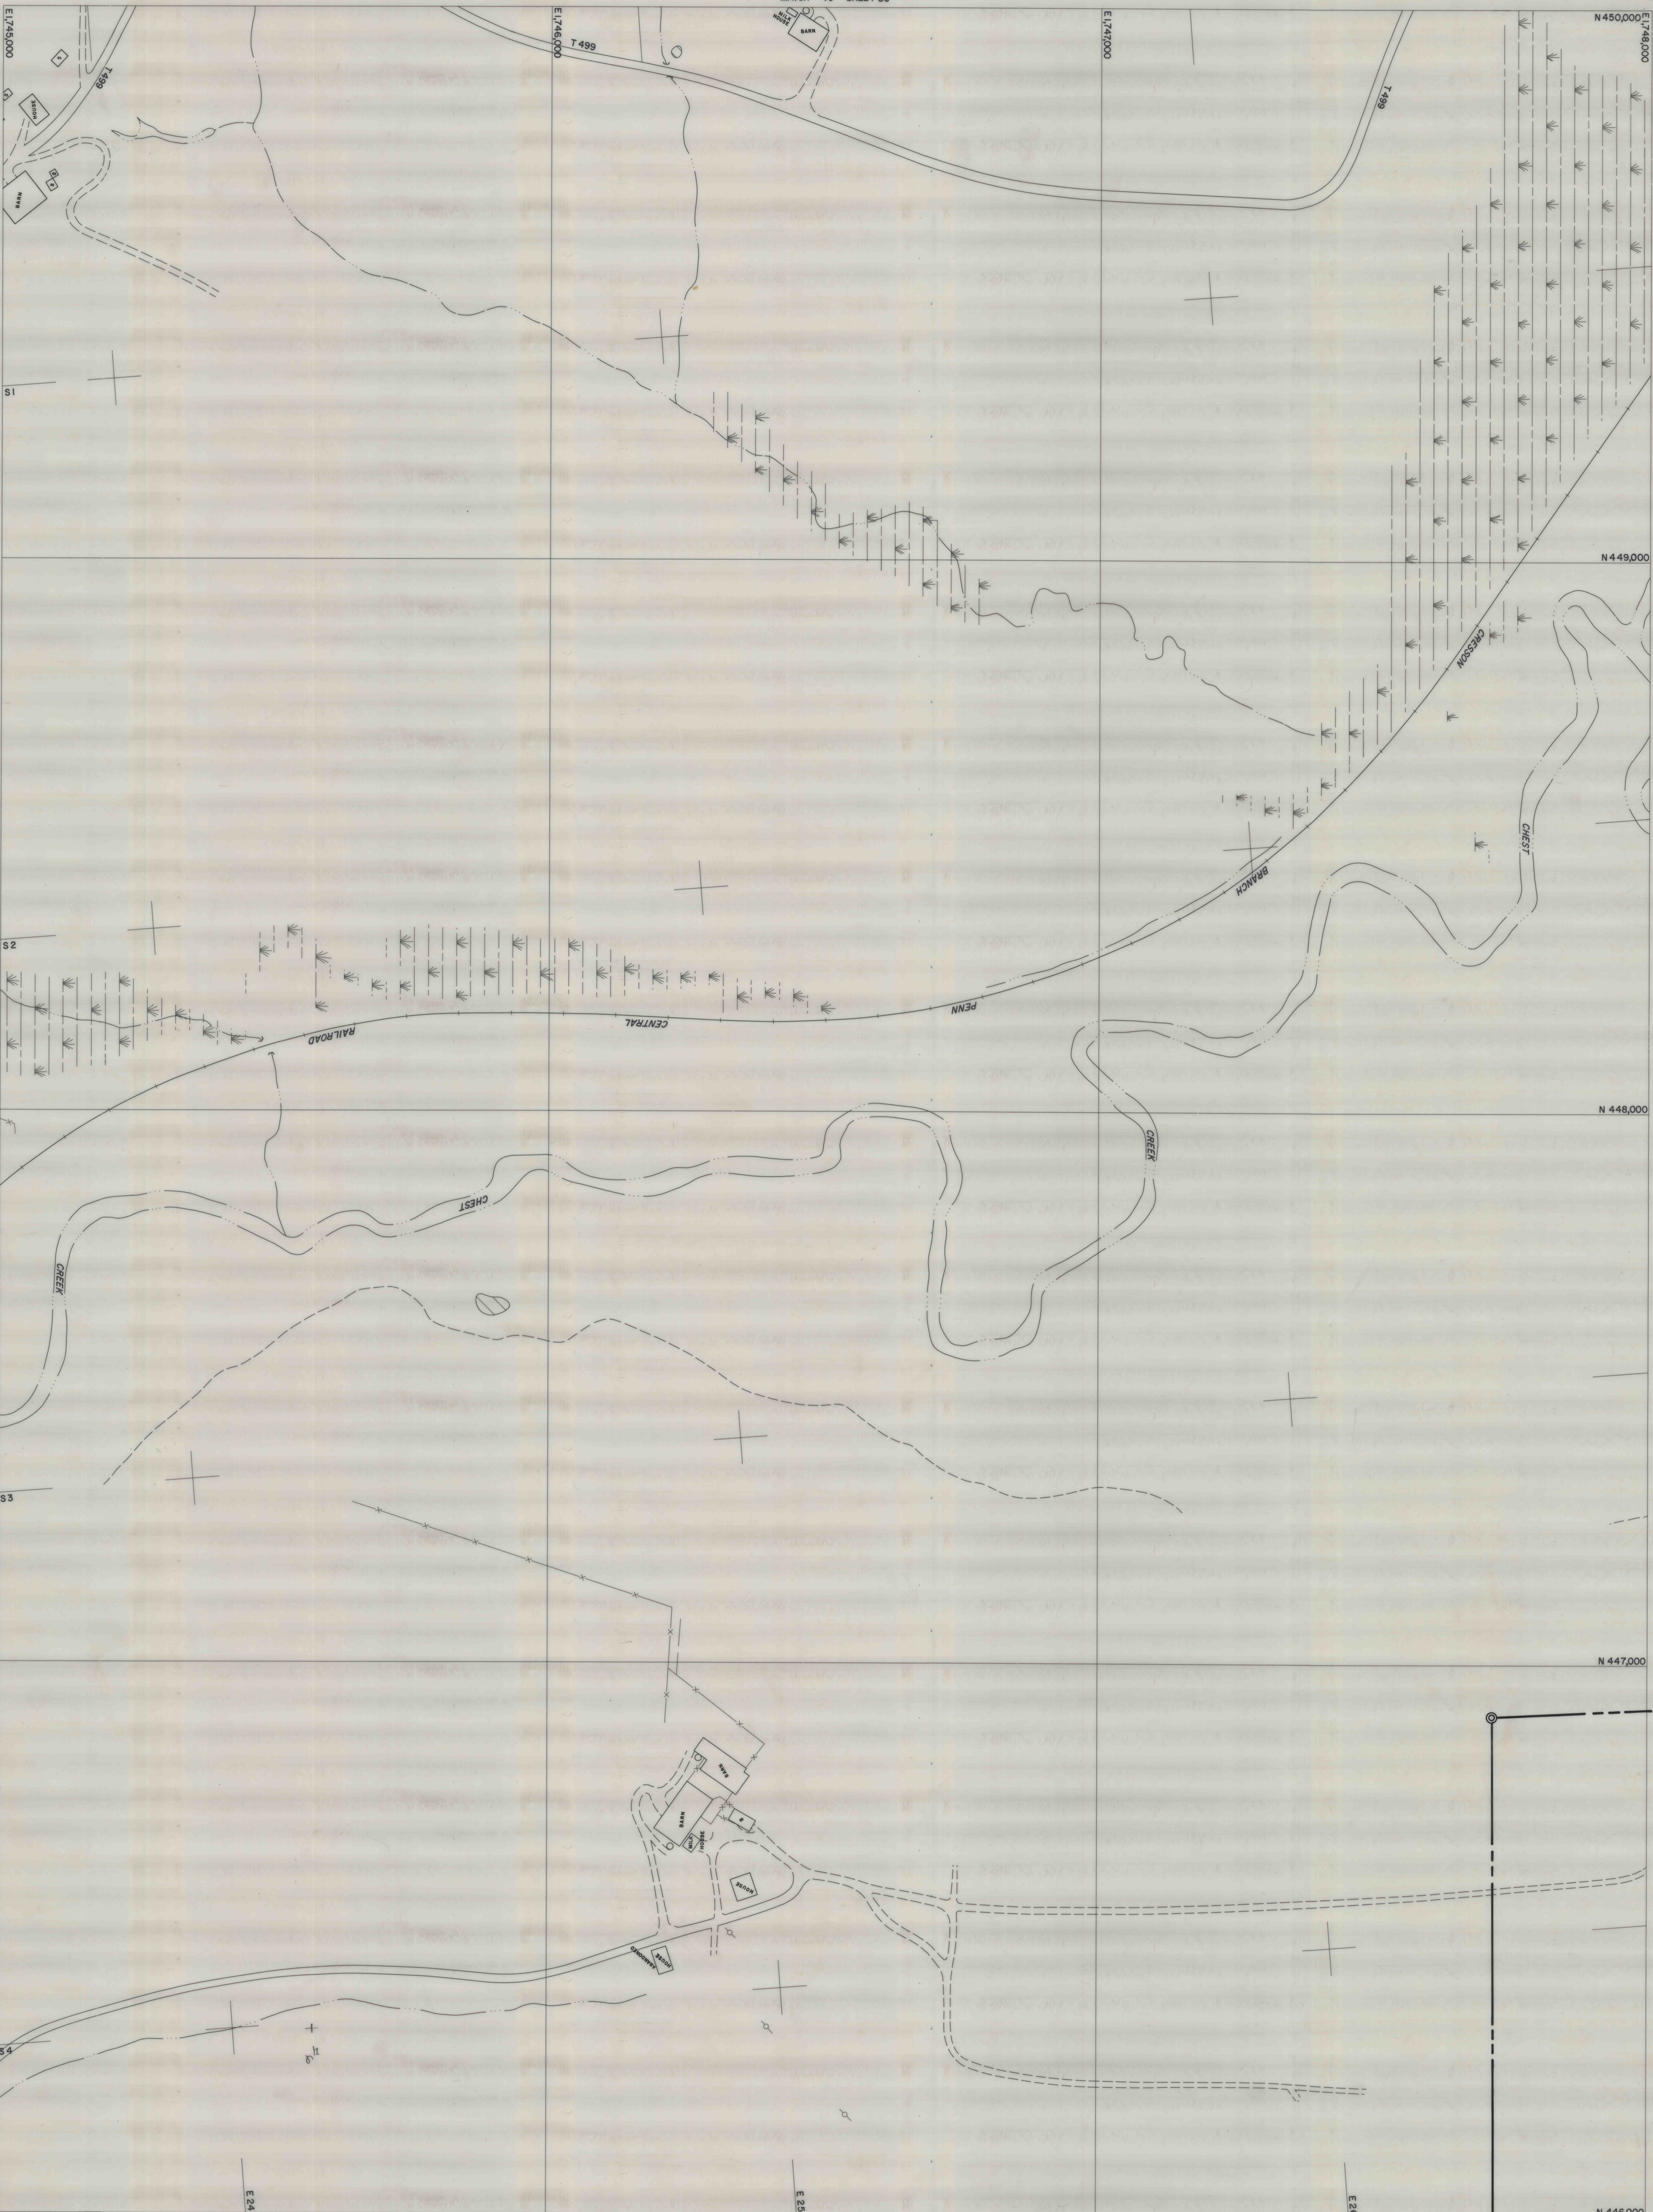

FINAL MAPPING DATE: 01-29-86
4420

BARNES & TUCKER COMPANY
LANCASTER NO. 20 MINE
EAST CARROLL TOWNSHIP, CAMBRIA COUNTY, PENNSYLVANIA
SCALE 1"=100'
DATE: JULY, 1976

MATCH TO SHEET 5G