

MATCH TO SHEET 3E

N 450,000

N 449,000


N 448,000

N 447,000

N 446,000

MATCH TO SHEET 4F

MATCH TO SHEET 5E

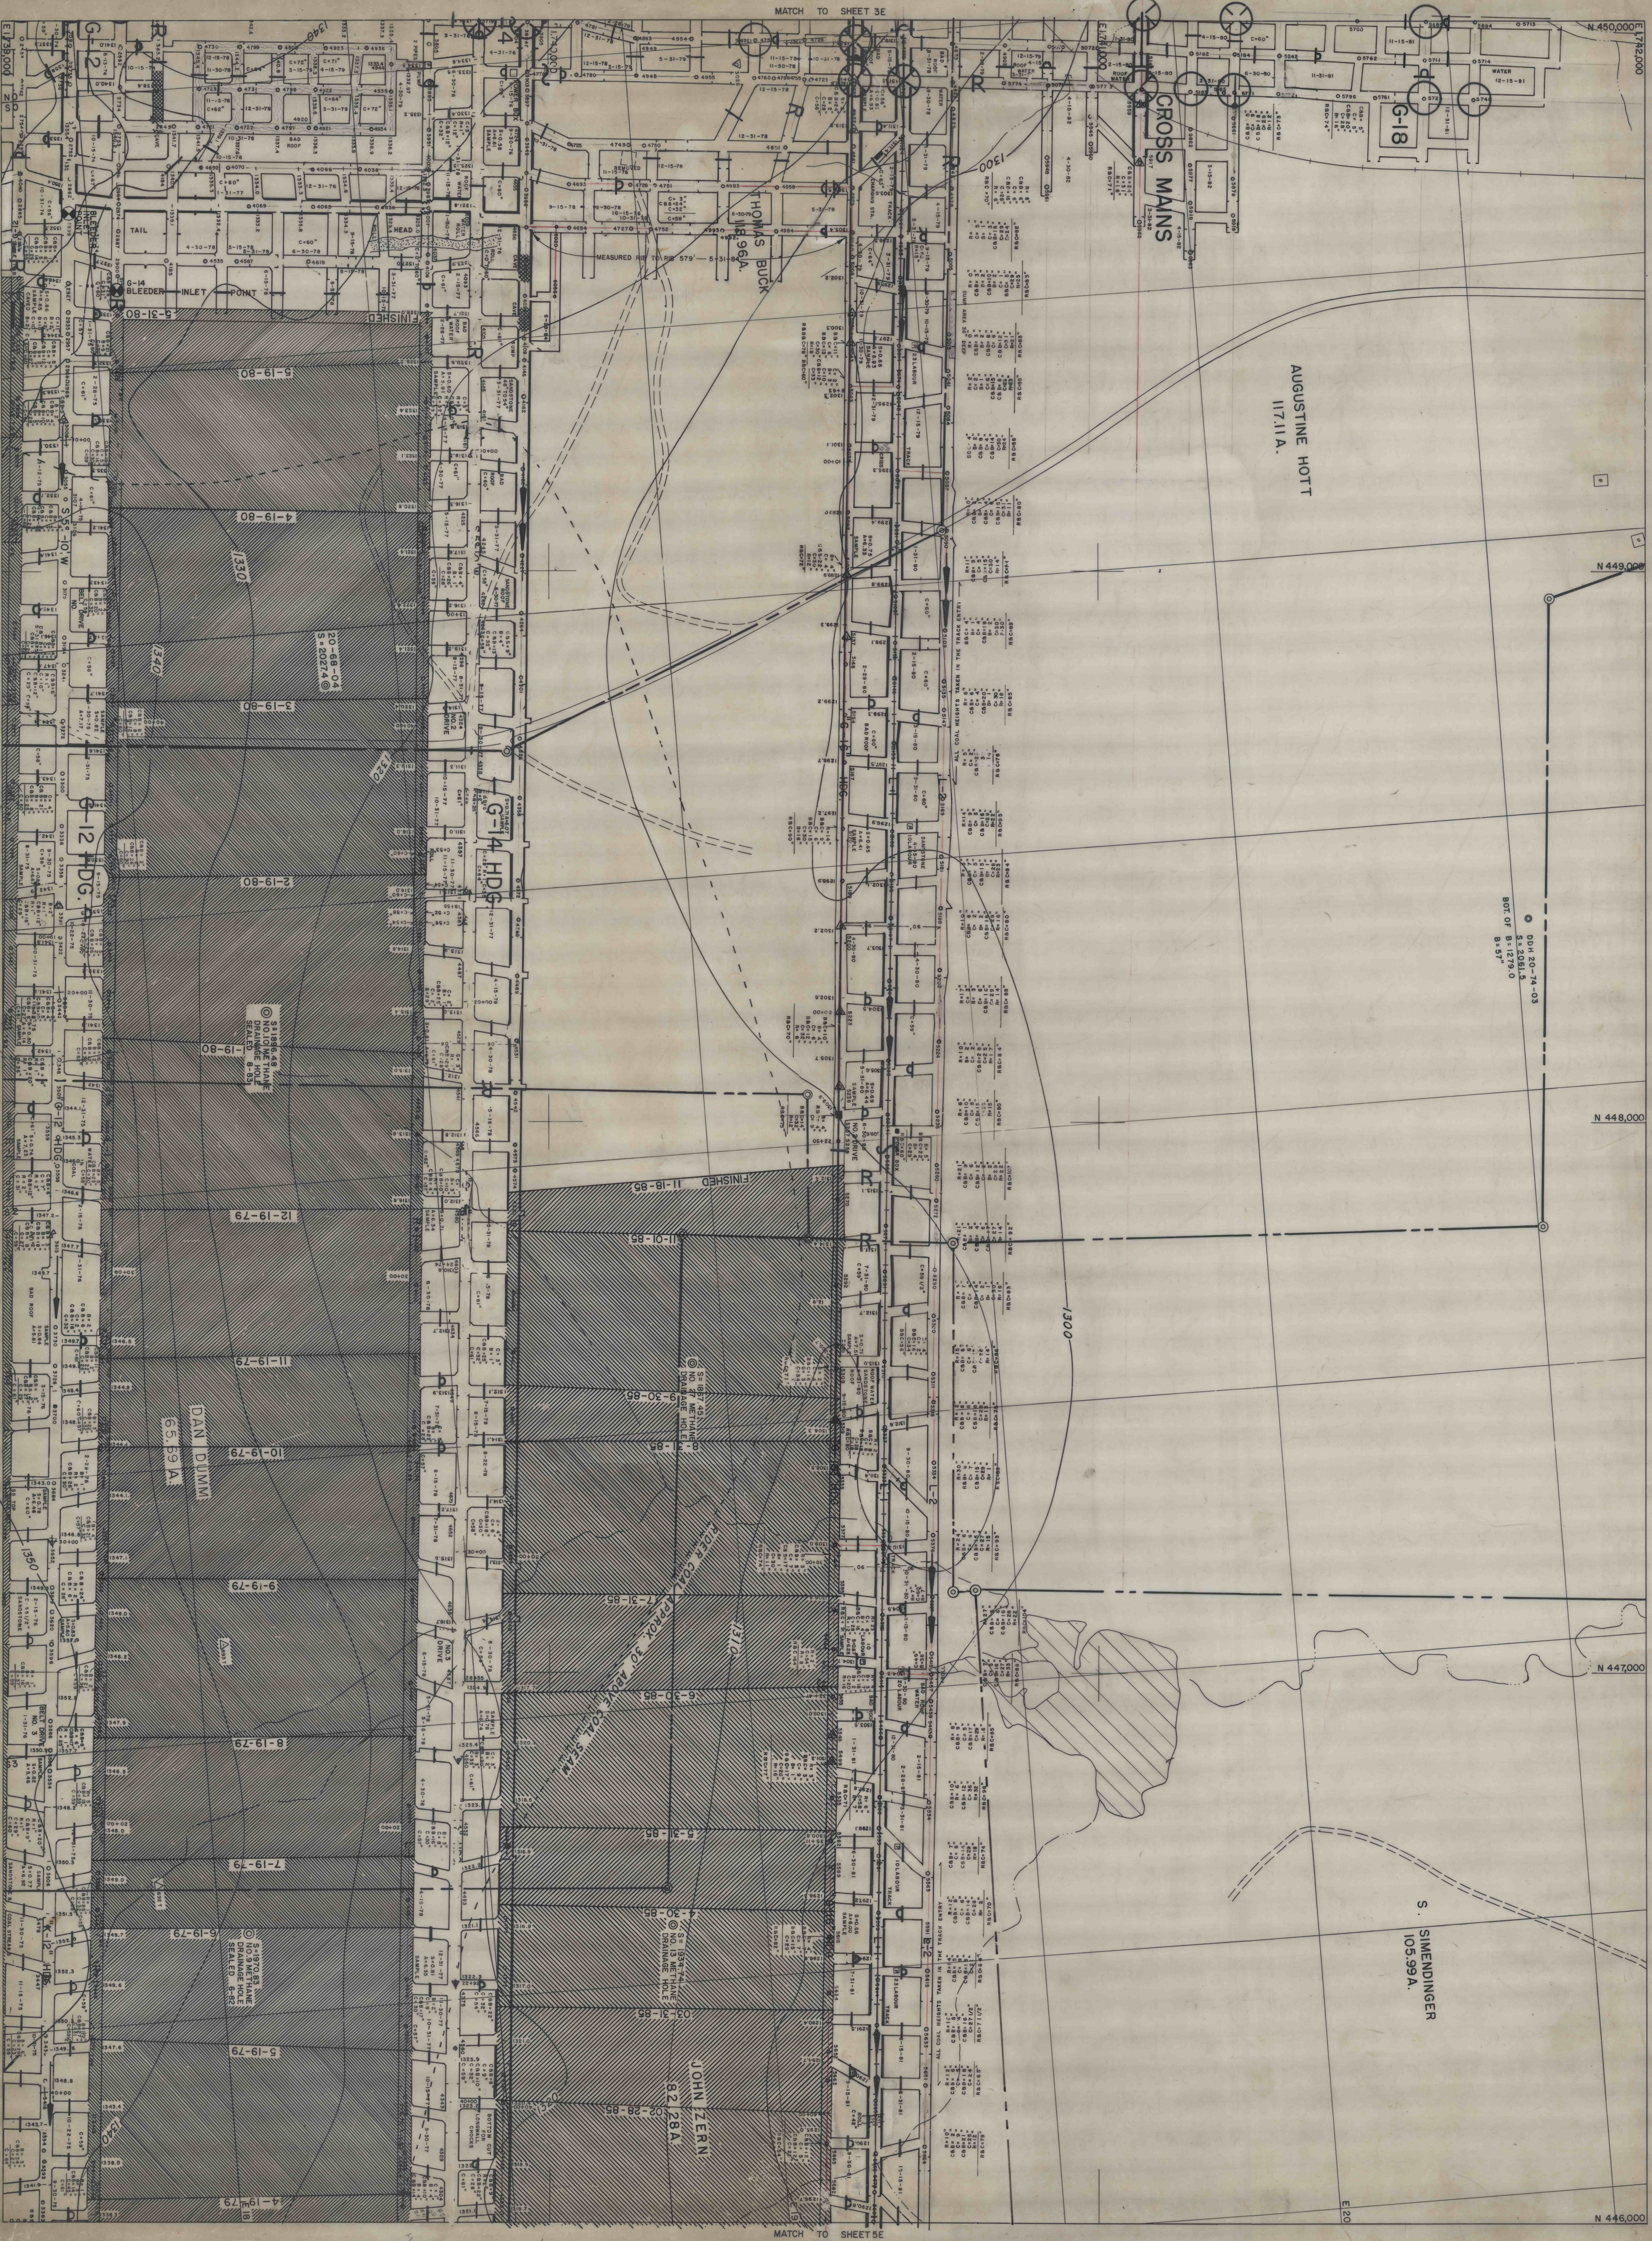

CROSS MAINS

AUGUSTINE HOTT
117.11 A.

G-18

THOMAS BUCK
118.99 A.

DDH 20-74-03
S 12061.3
BOT OF B: 1279.0
B-57

STIBBARD'S
DRAINAGE HOLE
NO. 1
SCALED 8-83

DAN DUMM
65.59 A.

NO. 27 METALINE
DRAINAGE HOLE
SCALED 8-83

JOHN ZERN
82.28 A.

S. SIMENDINGER
105.99 A.

NO. 28 METALINE
DRAINAGE HOLE
SCALED 8-83

MATCH TO SHEET 4D



FINAL MAPPING DATE: 01-23-86

4420

BARNES & TUCKER COMPANY
LAWCASHIRE NO. 20 MINE
EAST CARROLL TOWNSHIP CAMBERIA COUNTY, PENNSYLVANIA
SCALE: 1"=100'
DATE: JULY 1976

4E