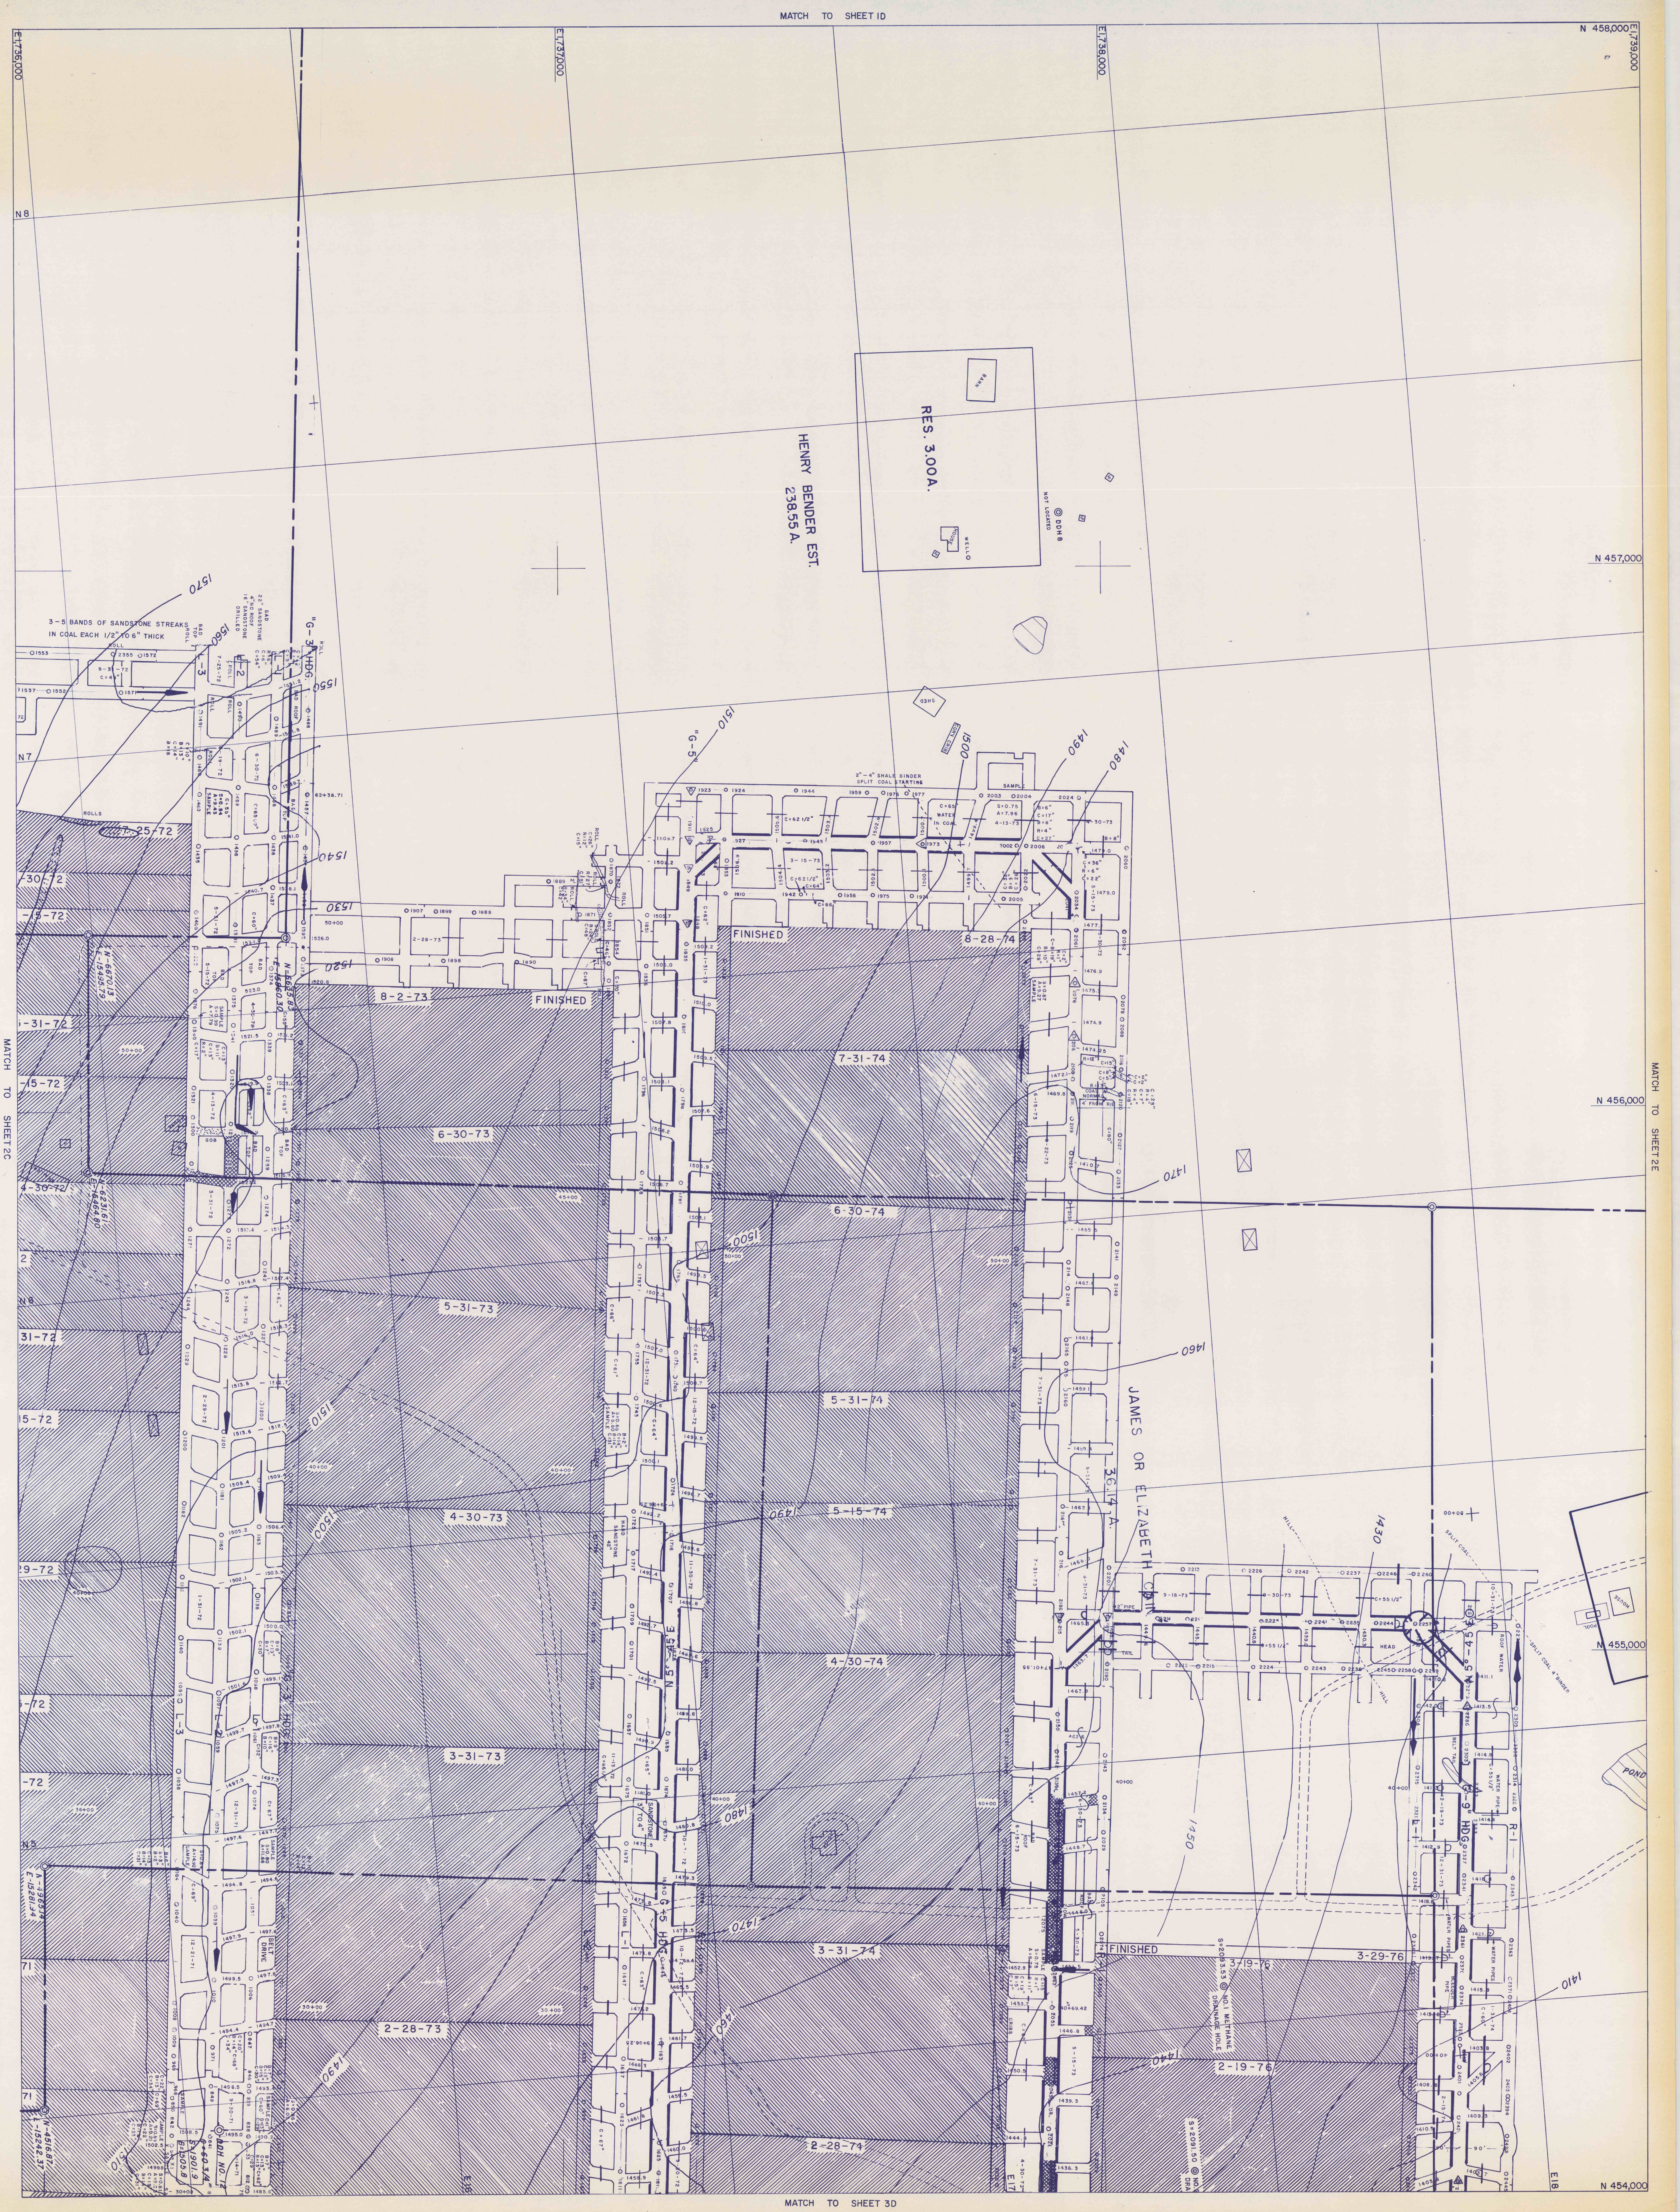

FINAL MAPPING DATE: 01-29-86

BARNES & TUCKER COMPANY
LANCASHIRE NO. 20 MINE
EAST CARROLL TOWNSHIP, CAMBRIA COUNTY, PENNSYLVANIA
SCALE: 1"=100'
DATE: JULY, 1976

2D