

MATCH TO SHEET 3B

N 450,000

N 448,000

N 447,000

N 446,000


E1732,000

E1731,000

E1730,000

MATCH TO SHEET 4C

MATCH TO SHEET 5B

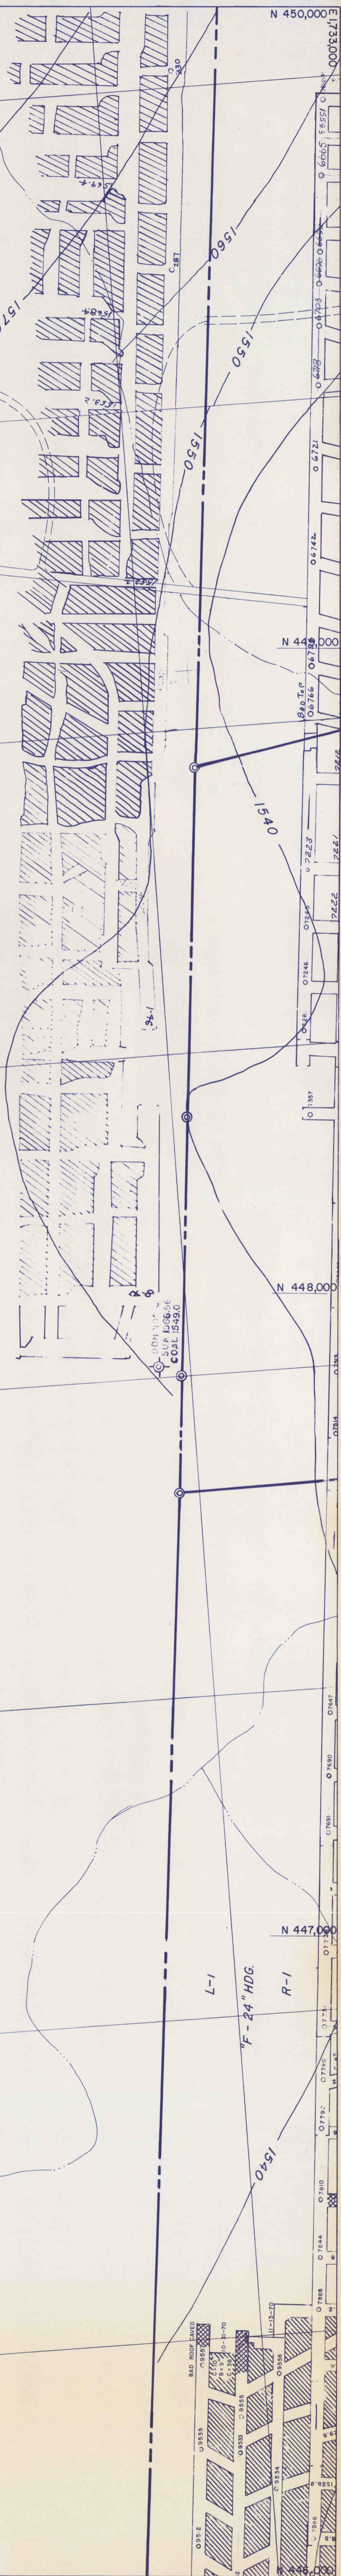

FINAL MAPPING DATE: 01-29-86

BARNES & TUCKER COMPANY
 LANCASTERSHIRE NO. 20 MINE
 EAST CARROLL TOWNSHIP, CAMBRIA COUNTY, PENNSYLVANIA
 SCALE: 1"=400'
 DATE: JULY, 1976

