MATCH TO SHEET 3D

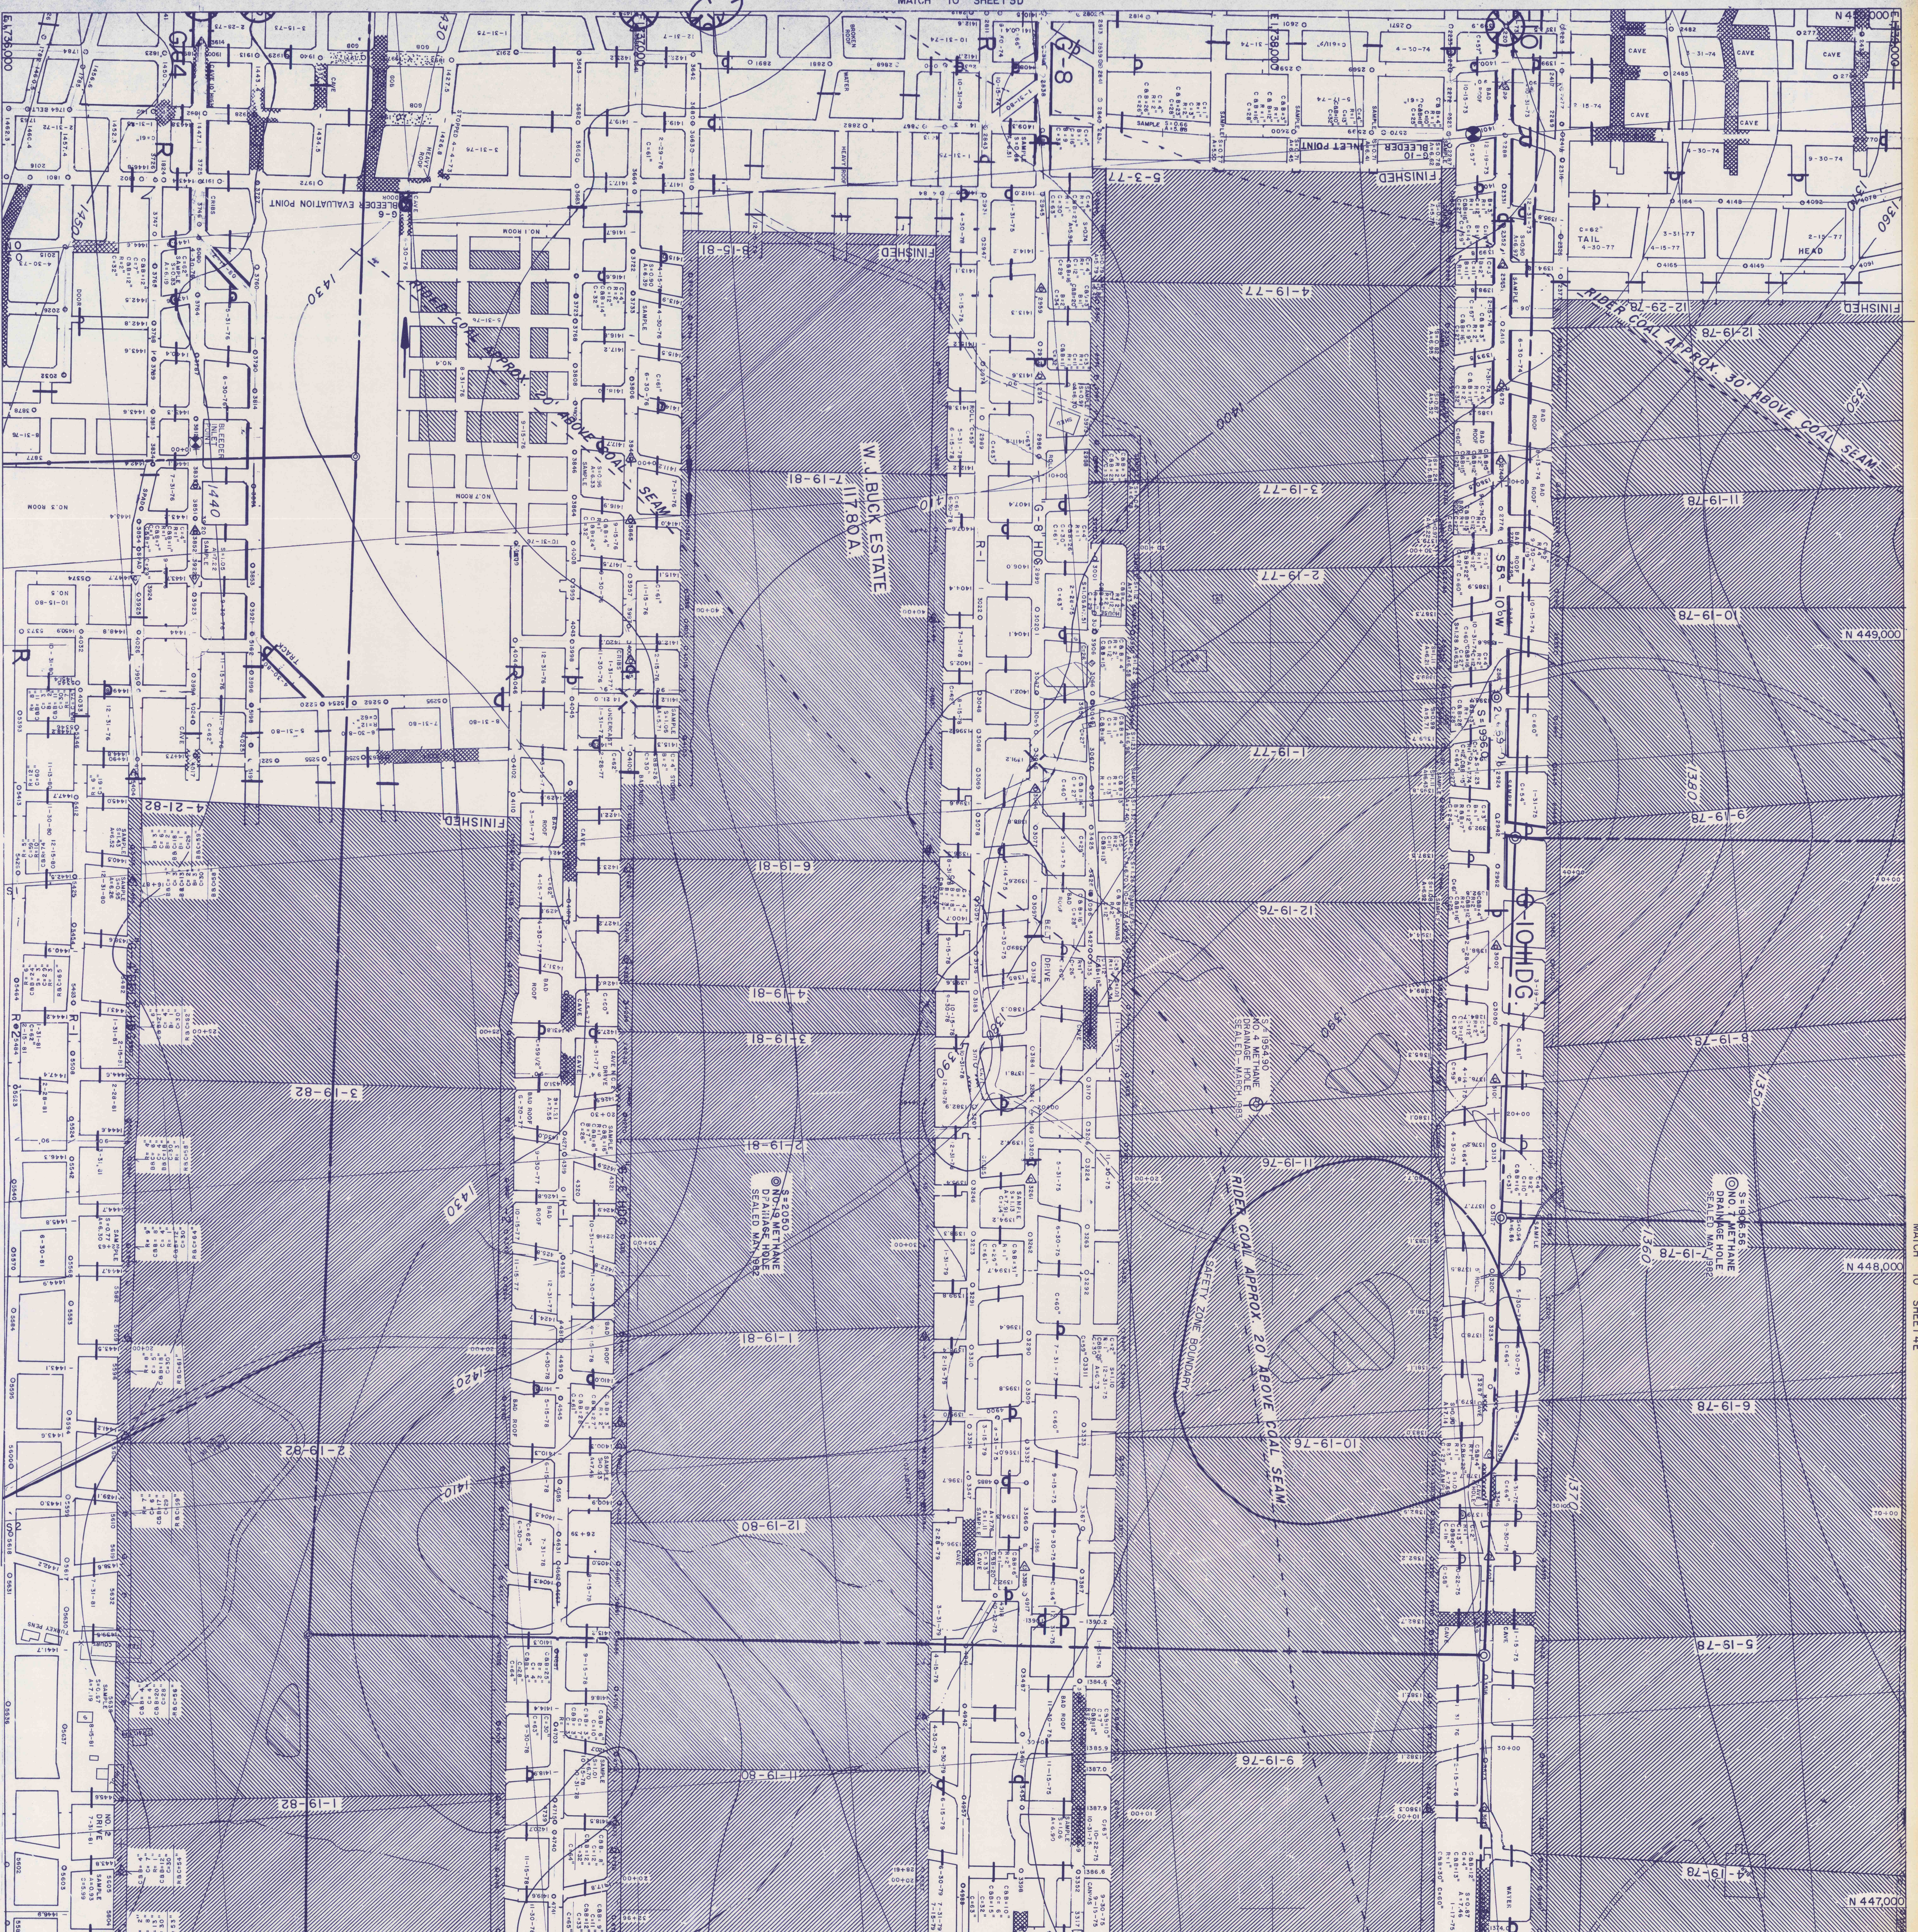
E 1,736,000
E 1,737,000
E 1,738,000
E 1,739,000
N 450,000
N 449,000
N 448,000
N 447,000
N 446,000
BLEEDER EVALUATION POINT
G-6
G-4
G-8
G-10 BLEEDER INLET POINT
BLEEDER INLET POINT
NO. 1 ROOM
NO. 3 ROOM
NO. 4
NO. 5
NO. 7 ROOM
RIDER COAL APPROX. 20' ABOVE COAL SEAM
RIDER COAL APPROX. 30' ABOVE COAL SEAM
W. J. BUCK ESTATE 117.80 A.
JOHN C. BRADLEY 83.03 A.
G-8" HDG.
10 HDG.
6 HDG
S 5° - 10' W
FINISHED
STARTED
HEAD
TAIL
CAVE
BAD ROOF
CRIBS
SAMPLE
TRACK
TURKEY PENS
NO. 2 DRIVE
NO. 3 DRIVE
SAFETY ZONE BOUNDARY
S=1954.90 NO. 4 METHANE DRAINAGE HOLE SEALED - MARCH 1983
S=2050 NO. 19 METHANE DRAINAGE HOLE SEALED MAY 1982
S=1906.56 NO. 7 METHANE DRAINAGE HOLE SEALED MAY 1982
S=2067 NO. 18 METHANE DRAINAGE HOLE SEALED 4-28-83
S=2124.8 NO. 15 METHANE DRAINAGE HOLE
S=2108.60 NO. 3 METHANE DRAINAGE HOLE SEALED
S=2065.63 NO. 6 METHANE DRAINAGE HOLE SEALED 8-79
4-21-82
3-19-82
2-19-82
1-19-82
12-19-81
11-19-81
10-19-81
8-15-81
7-19-81
6-19-81
4-19-81
3-19-81
2-19-81
1-19-81
12-19-80
11-19-80
10-19-80
9-19-80
5-3-77
4-19-77
3-19-77
2-19-77
1-19-77
12-19-76
11-19-76
10-19-76
9-19-76
8-19-76
7-19-76
6-19-76
5-19-76
4-27-76
12-29-78
12-19-78
11-19-78
10-19-78
9-19-78
8-19-78
7-19-78
6-19-78
5-19-78
4-19-78
12-19-77
11-19-77
10-19-77
1450
1440
1430
1420
1410
1400
1390
1380
1370
1360
1350

MATCH TO SHEET 4C

MATCH TO SHEET 4E

MATCH TO SHEET 5D

FINAL MAPPING DATE: 01-29-86

BARNES & TUCKER COMPANY
LANCASHIRE NO. 20 MINE
EAST CARROLL TOWNSHIP, CAMBRIA COUNTY, PENNSYLVANIA
SCALE: 1"=100'
DATE: JULY, 1976

4D