


MATCH TO SHEET 48

E1732000

E1731000

E1730000

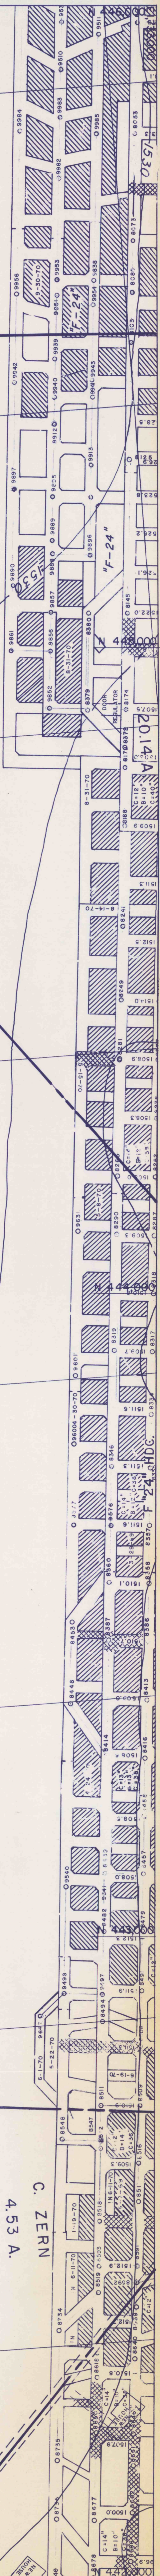

MATCH TO SHEET 5C

MATCH TO SHEET 5D

C. ZERN
4.53 A.

SANSTONE ROOF
C-2-1-B

SANSTONE
12-19-56

FINAL MAPPING DATE: 01-29-86

BARNES & TUCKER COMPANY
LANCASHIRE NO. 20 MINE
EAST CARROLL TOWNSHIP, CAMBRIA COUNTY, PENNSYLVANIA
SCALE: 1"=100'
DATE: JULY, 1976

58

MATCH TO SHEET 66