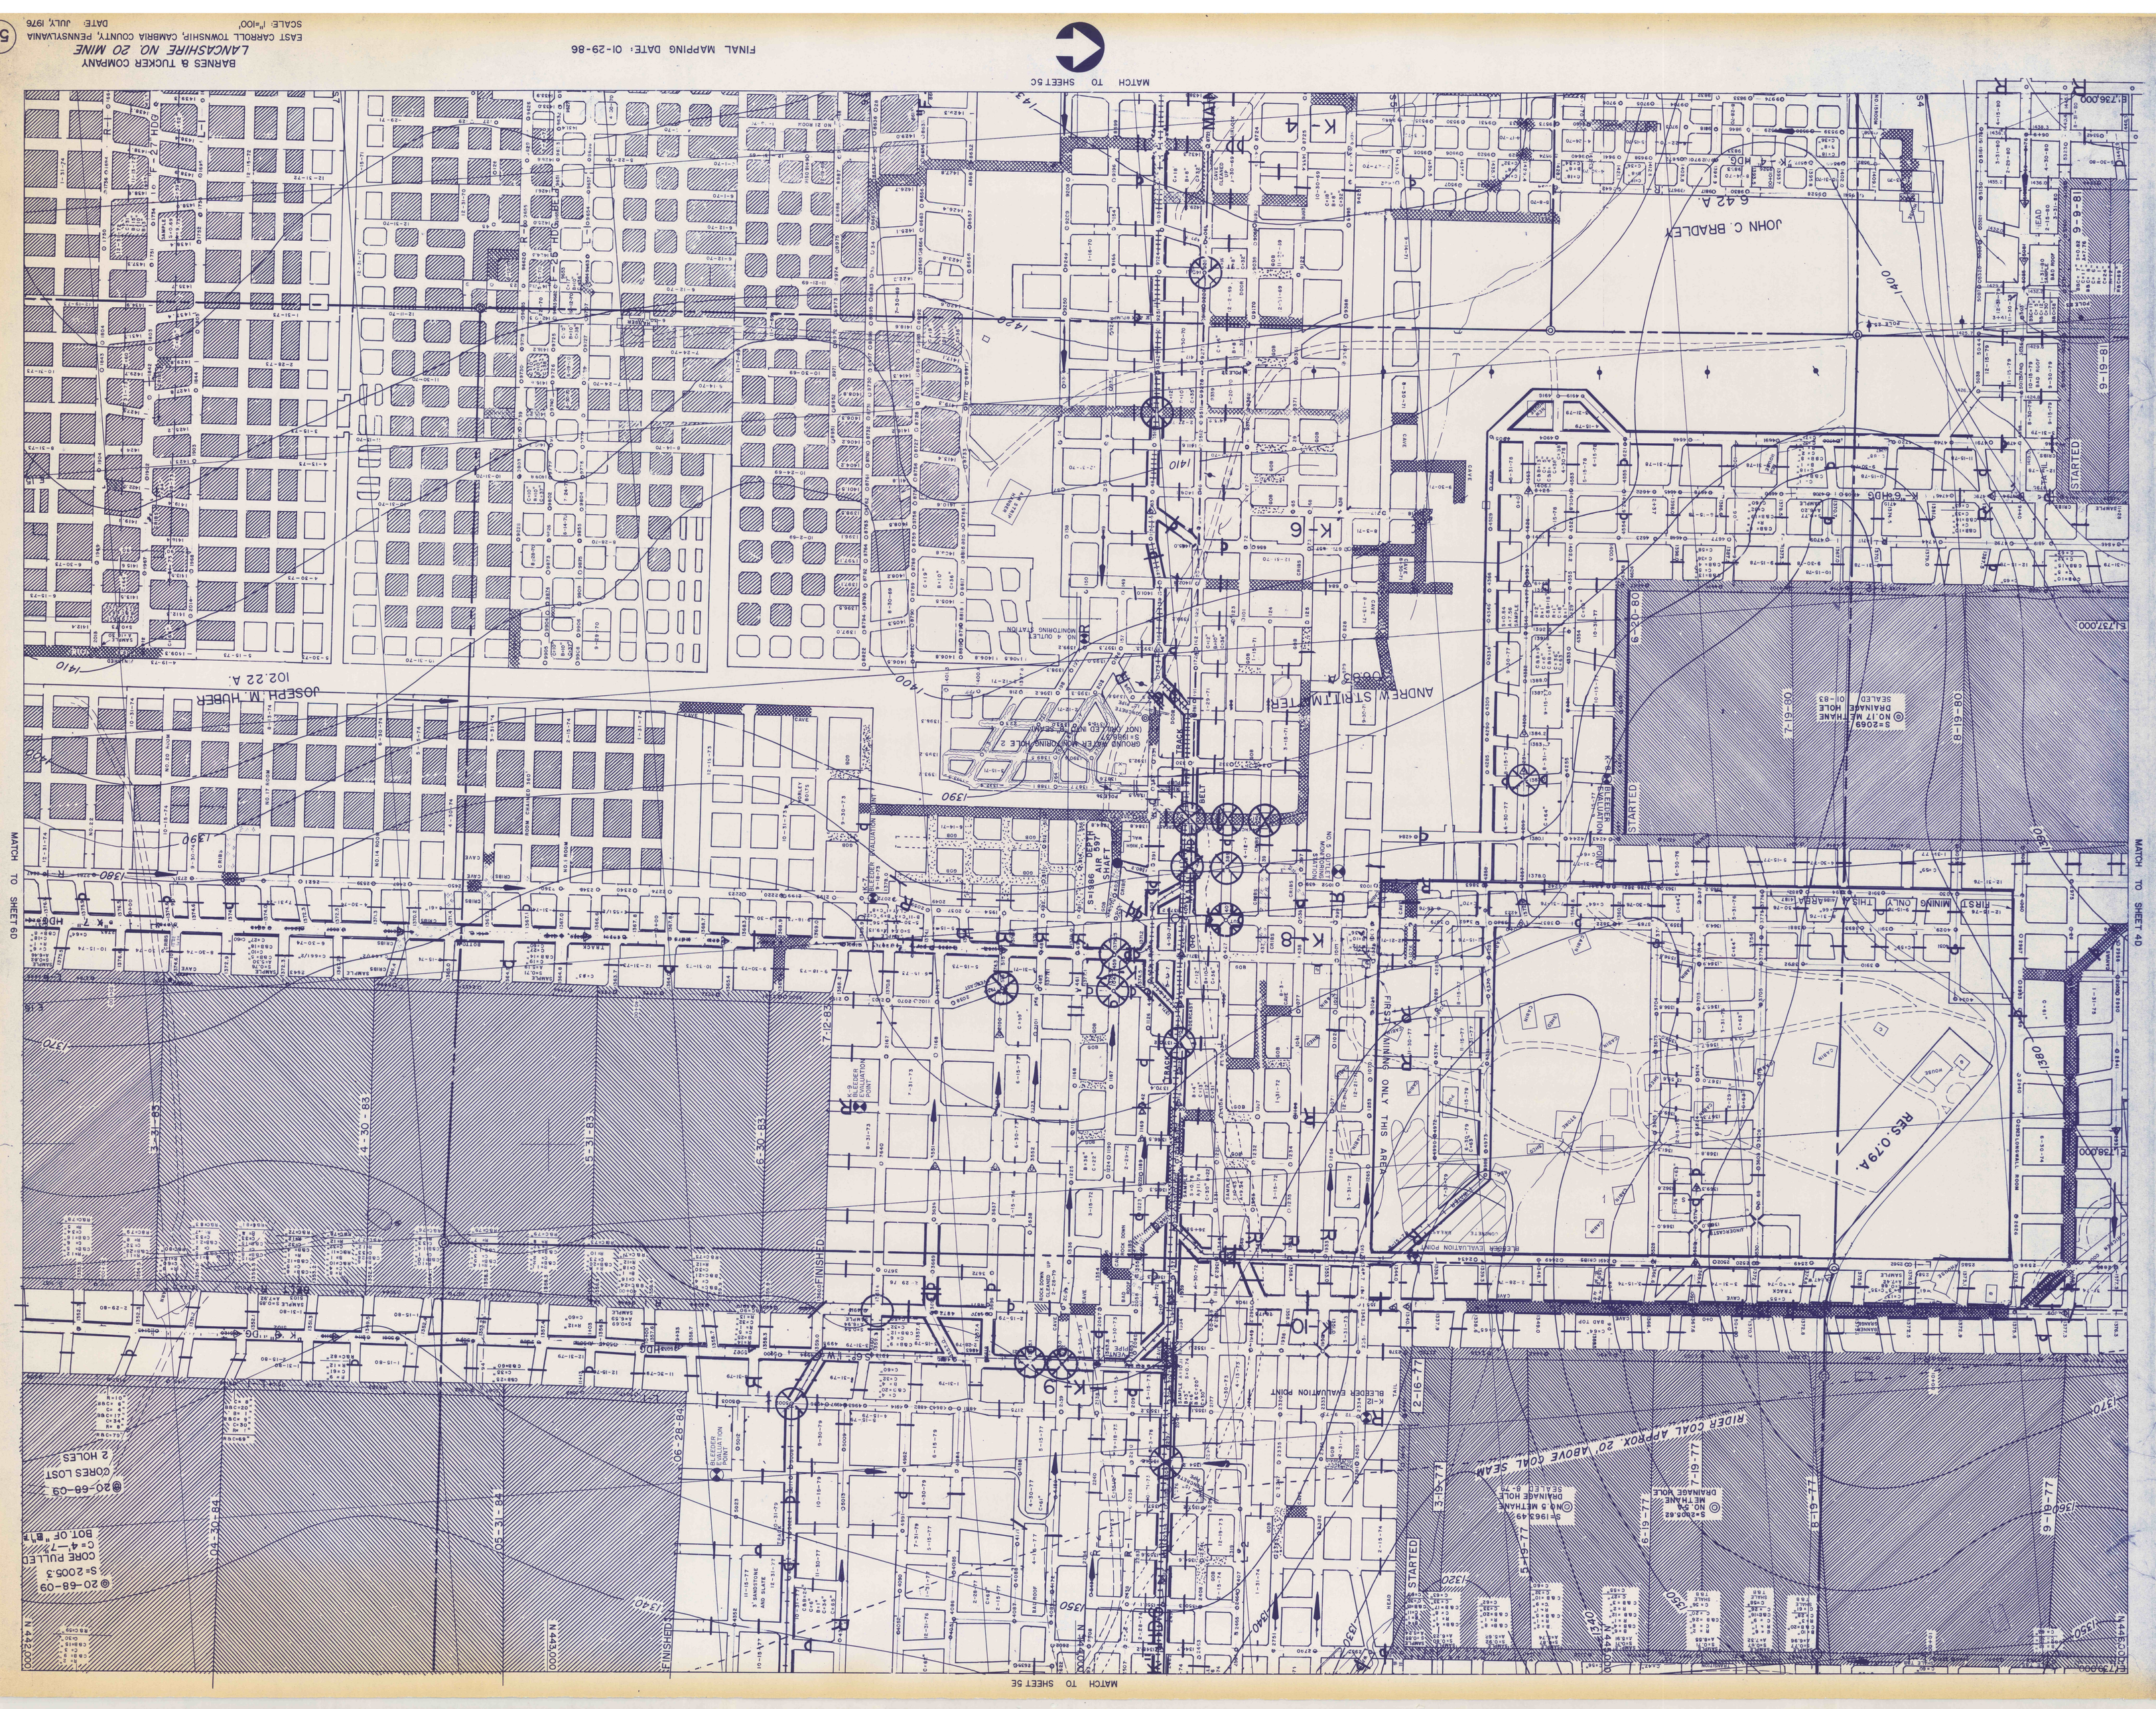

BARNES & TUCKER COMPANY
LANCASHIRE NO. 20 MINE
EAST CARROLL TOWNSHIP, CAMBRIA COUNTY, PENNSYLVANIA
SCALE: 1"=100'
DATE: JULY, 1976
5D
FINAL MAPPING DATE: 01-29-86
MATCH TO SHEET 5C
MATCH TO SHEET 6D
MATCH TO SHEET 4D
MATCH TO SHEET 5E
JOSEPH M. HUBER
102.22 A.
JOHN C. BRADLEY
642 A.
ANDREW STRITTMATTER
RES. 0.79A.
FIRST MINING ONLY THIS AREA
RIDER COAL APPROX. 20' ABOVE COAL SEAM
STARTED
FINISHED