

N 442,000  
N 441,000  
N 440,000  
N 439,000  
N 438,000

MATCH TO SHEET 5E

E 1741,000

E 1740,000


JAMES PHALEN  
126.52 A.

T. J. ILLIG  
59.96 A.

JOHN J. TIERNNEY  
22.04 A.


MICHAEL NOON  
110.54 A.

DOH 4  
NOT LOCATED

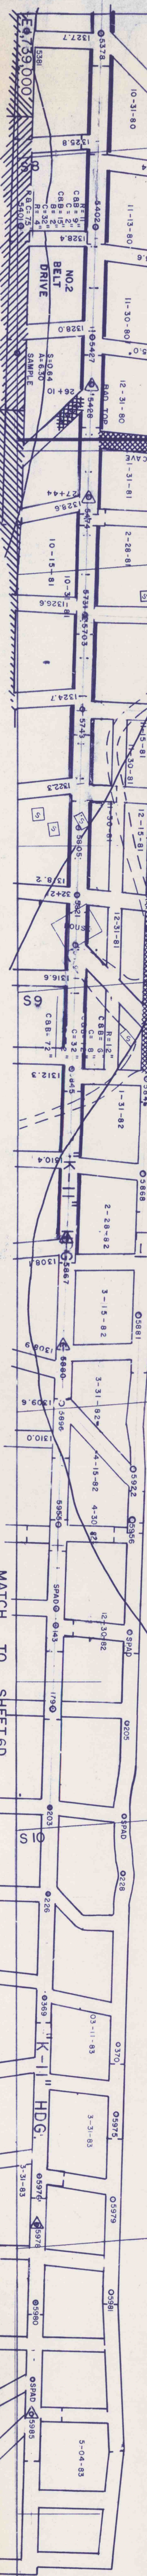

MATCH TO SHEET 6D

FINAL MAPPING DATE: 01-29-86

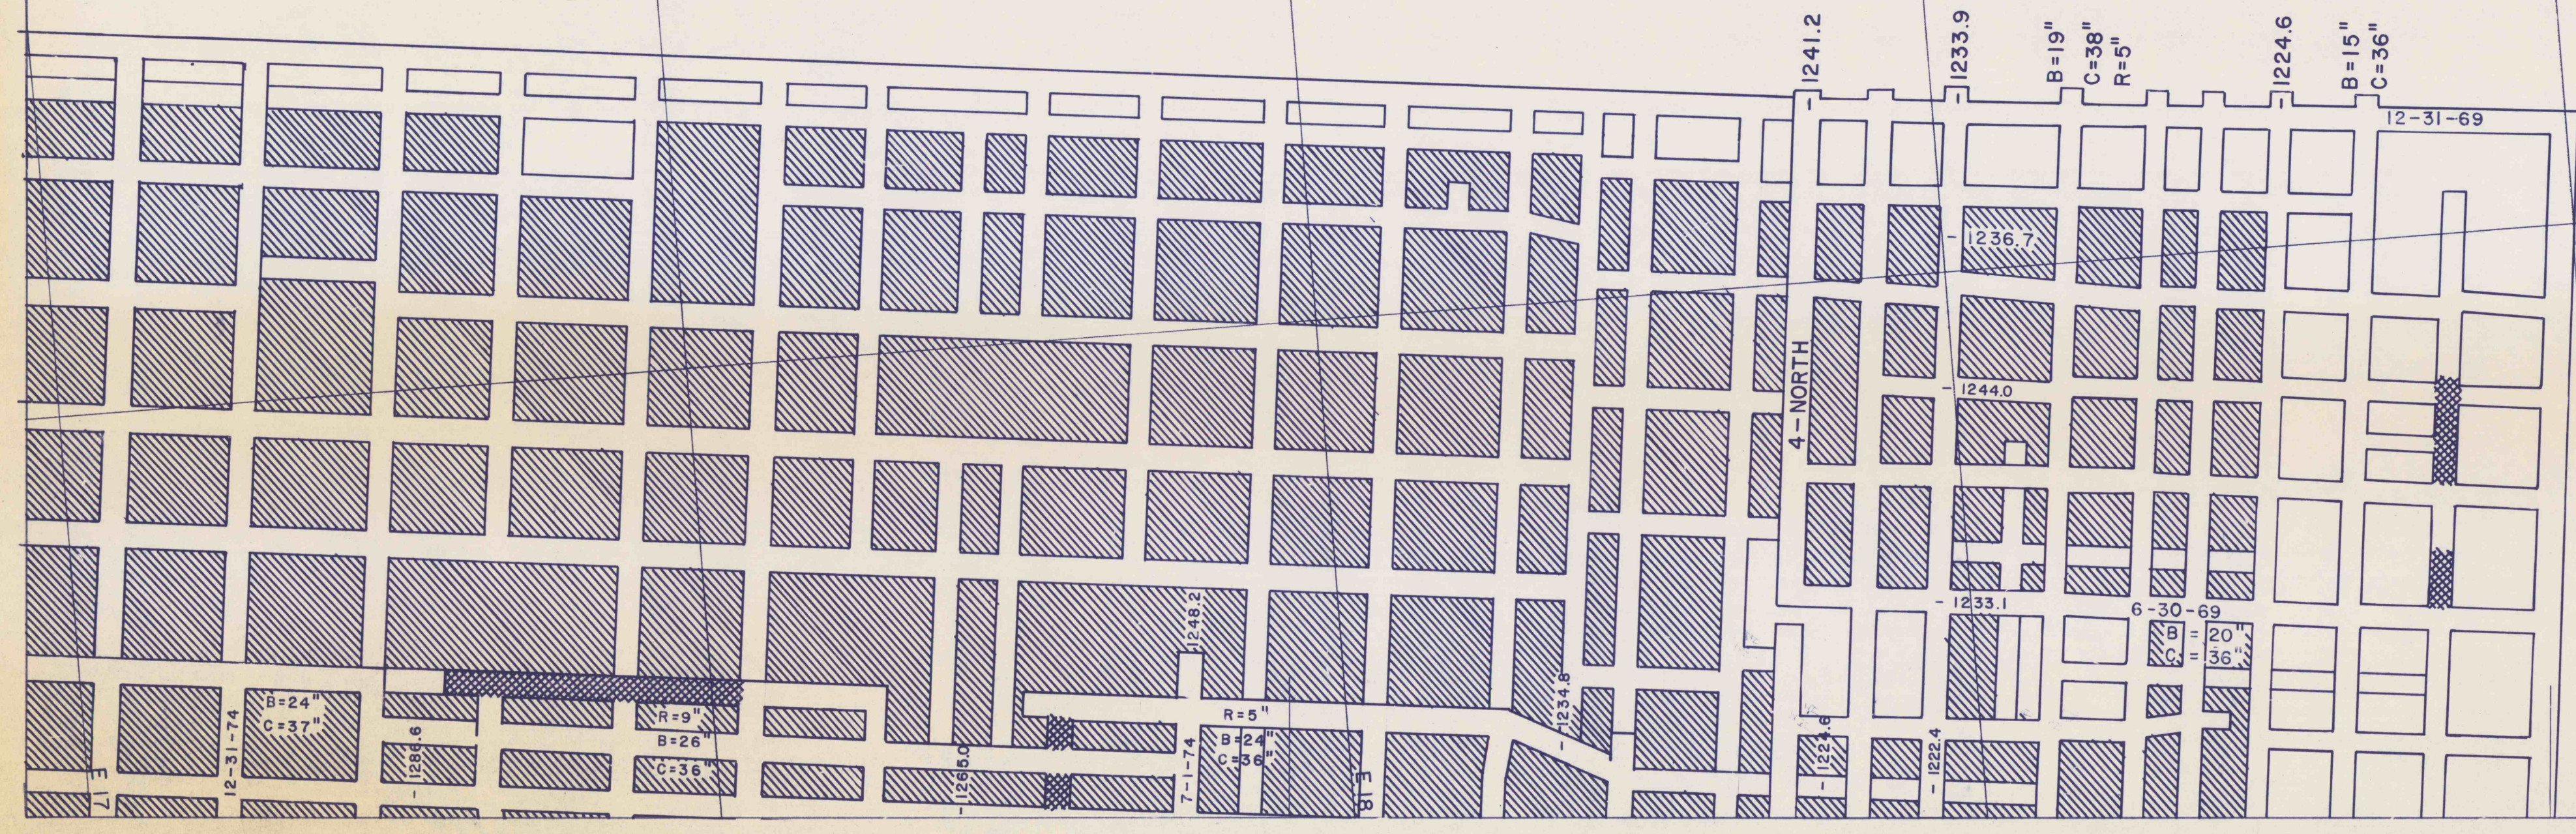

BARNES & TUCKER COMPANY  
LANCASTER NO. 20 MINE  
EAST CARROLL TOWNSHIP, CAMBRIA COUNTY, PENNSYLVANIA  
SCALE 1"=100'  
DATE: JULY, 1976

6E