


MATCH TO SHEET 1C

N 458,000
E 1736,000

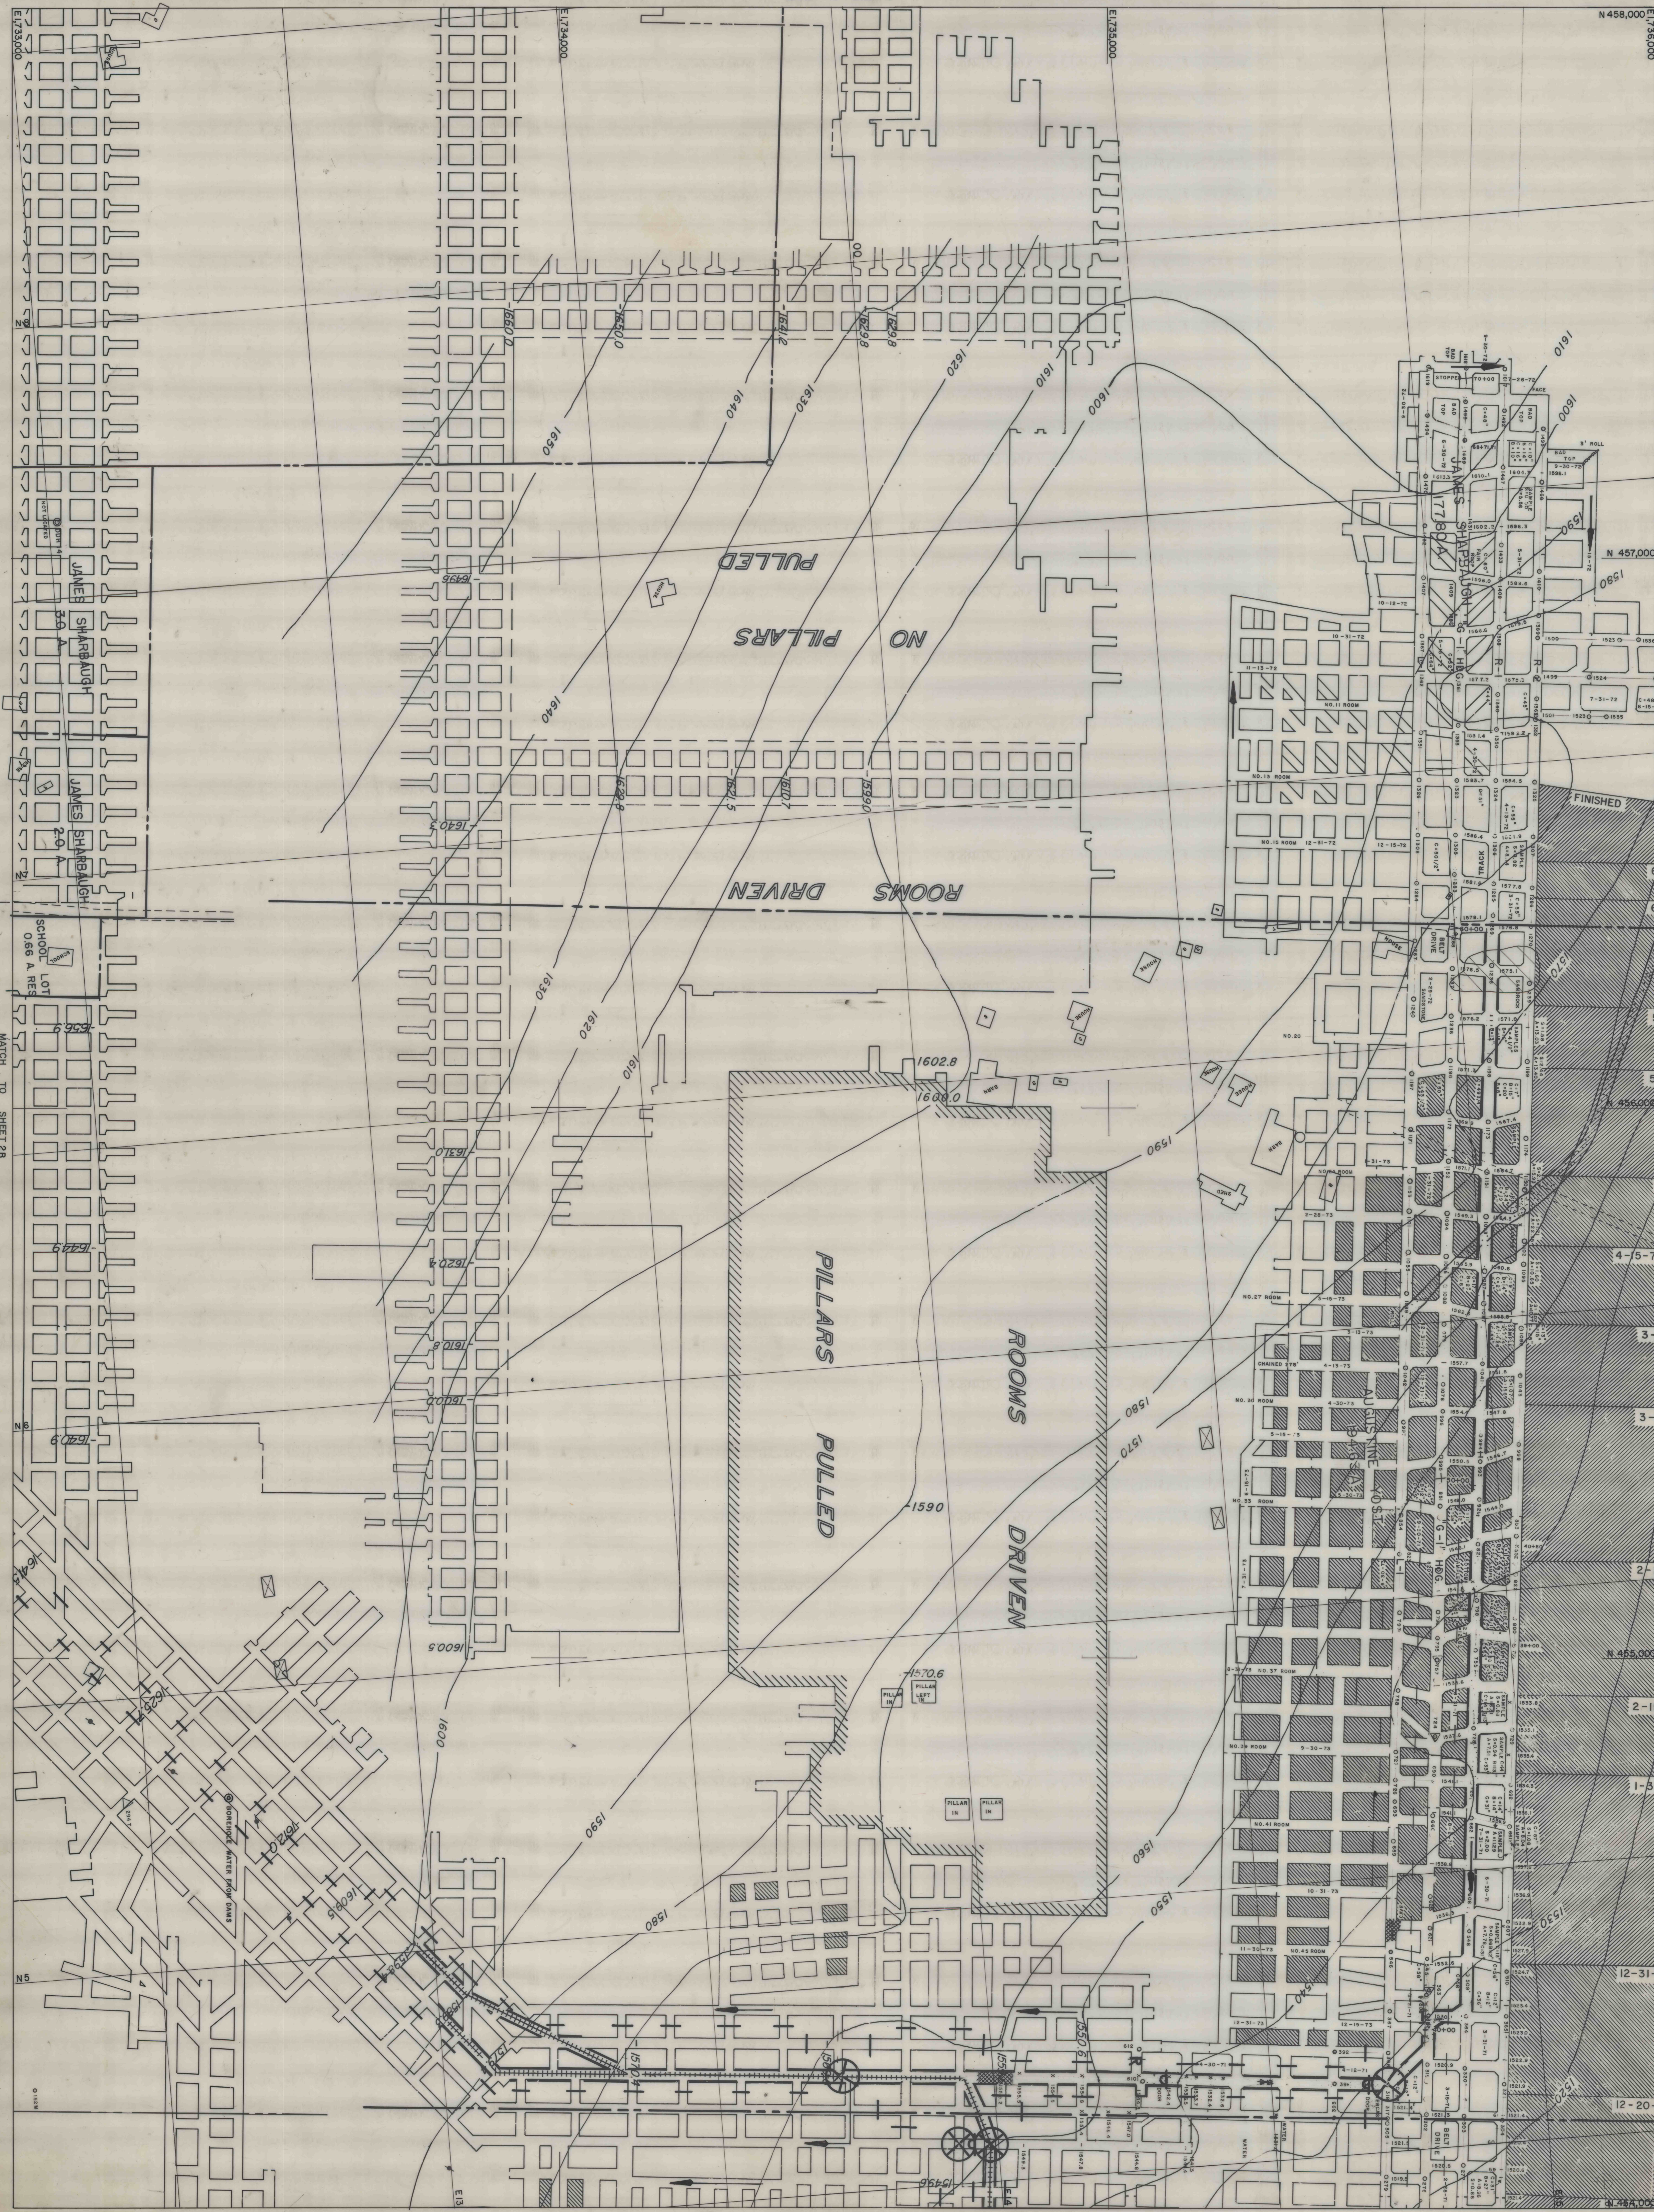

N 457,000

N 456,000







MATCH TO SHEET 3C

MATCH TO SHEET 2D

MATCH TO SHEET 2B



FINAL MAPPING DATE: 01-29-86

BARNES & TUCKER COMPANY
 LANCASTER NO. 20 MINE
 EAST CARROLL TOWNSHIP, CAMBRIA COUNTY, PENNSYLVANIA
 SCALE: 1"=100'
 DATE: JULY, 1976