

E1733,000  
N 462,000

N 461,000

N 460,000  
MATCH TO SHEET C


N 459,000

N 458,000

E1732,000

E1731,000

E1730,000

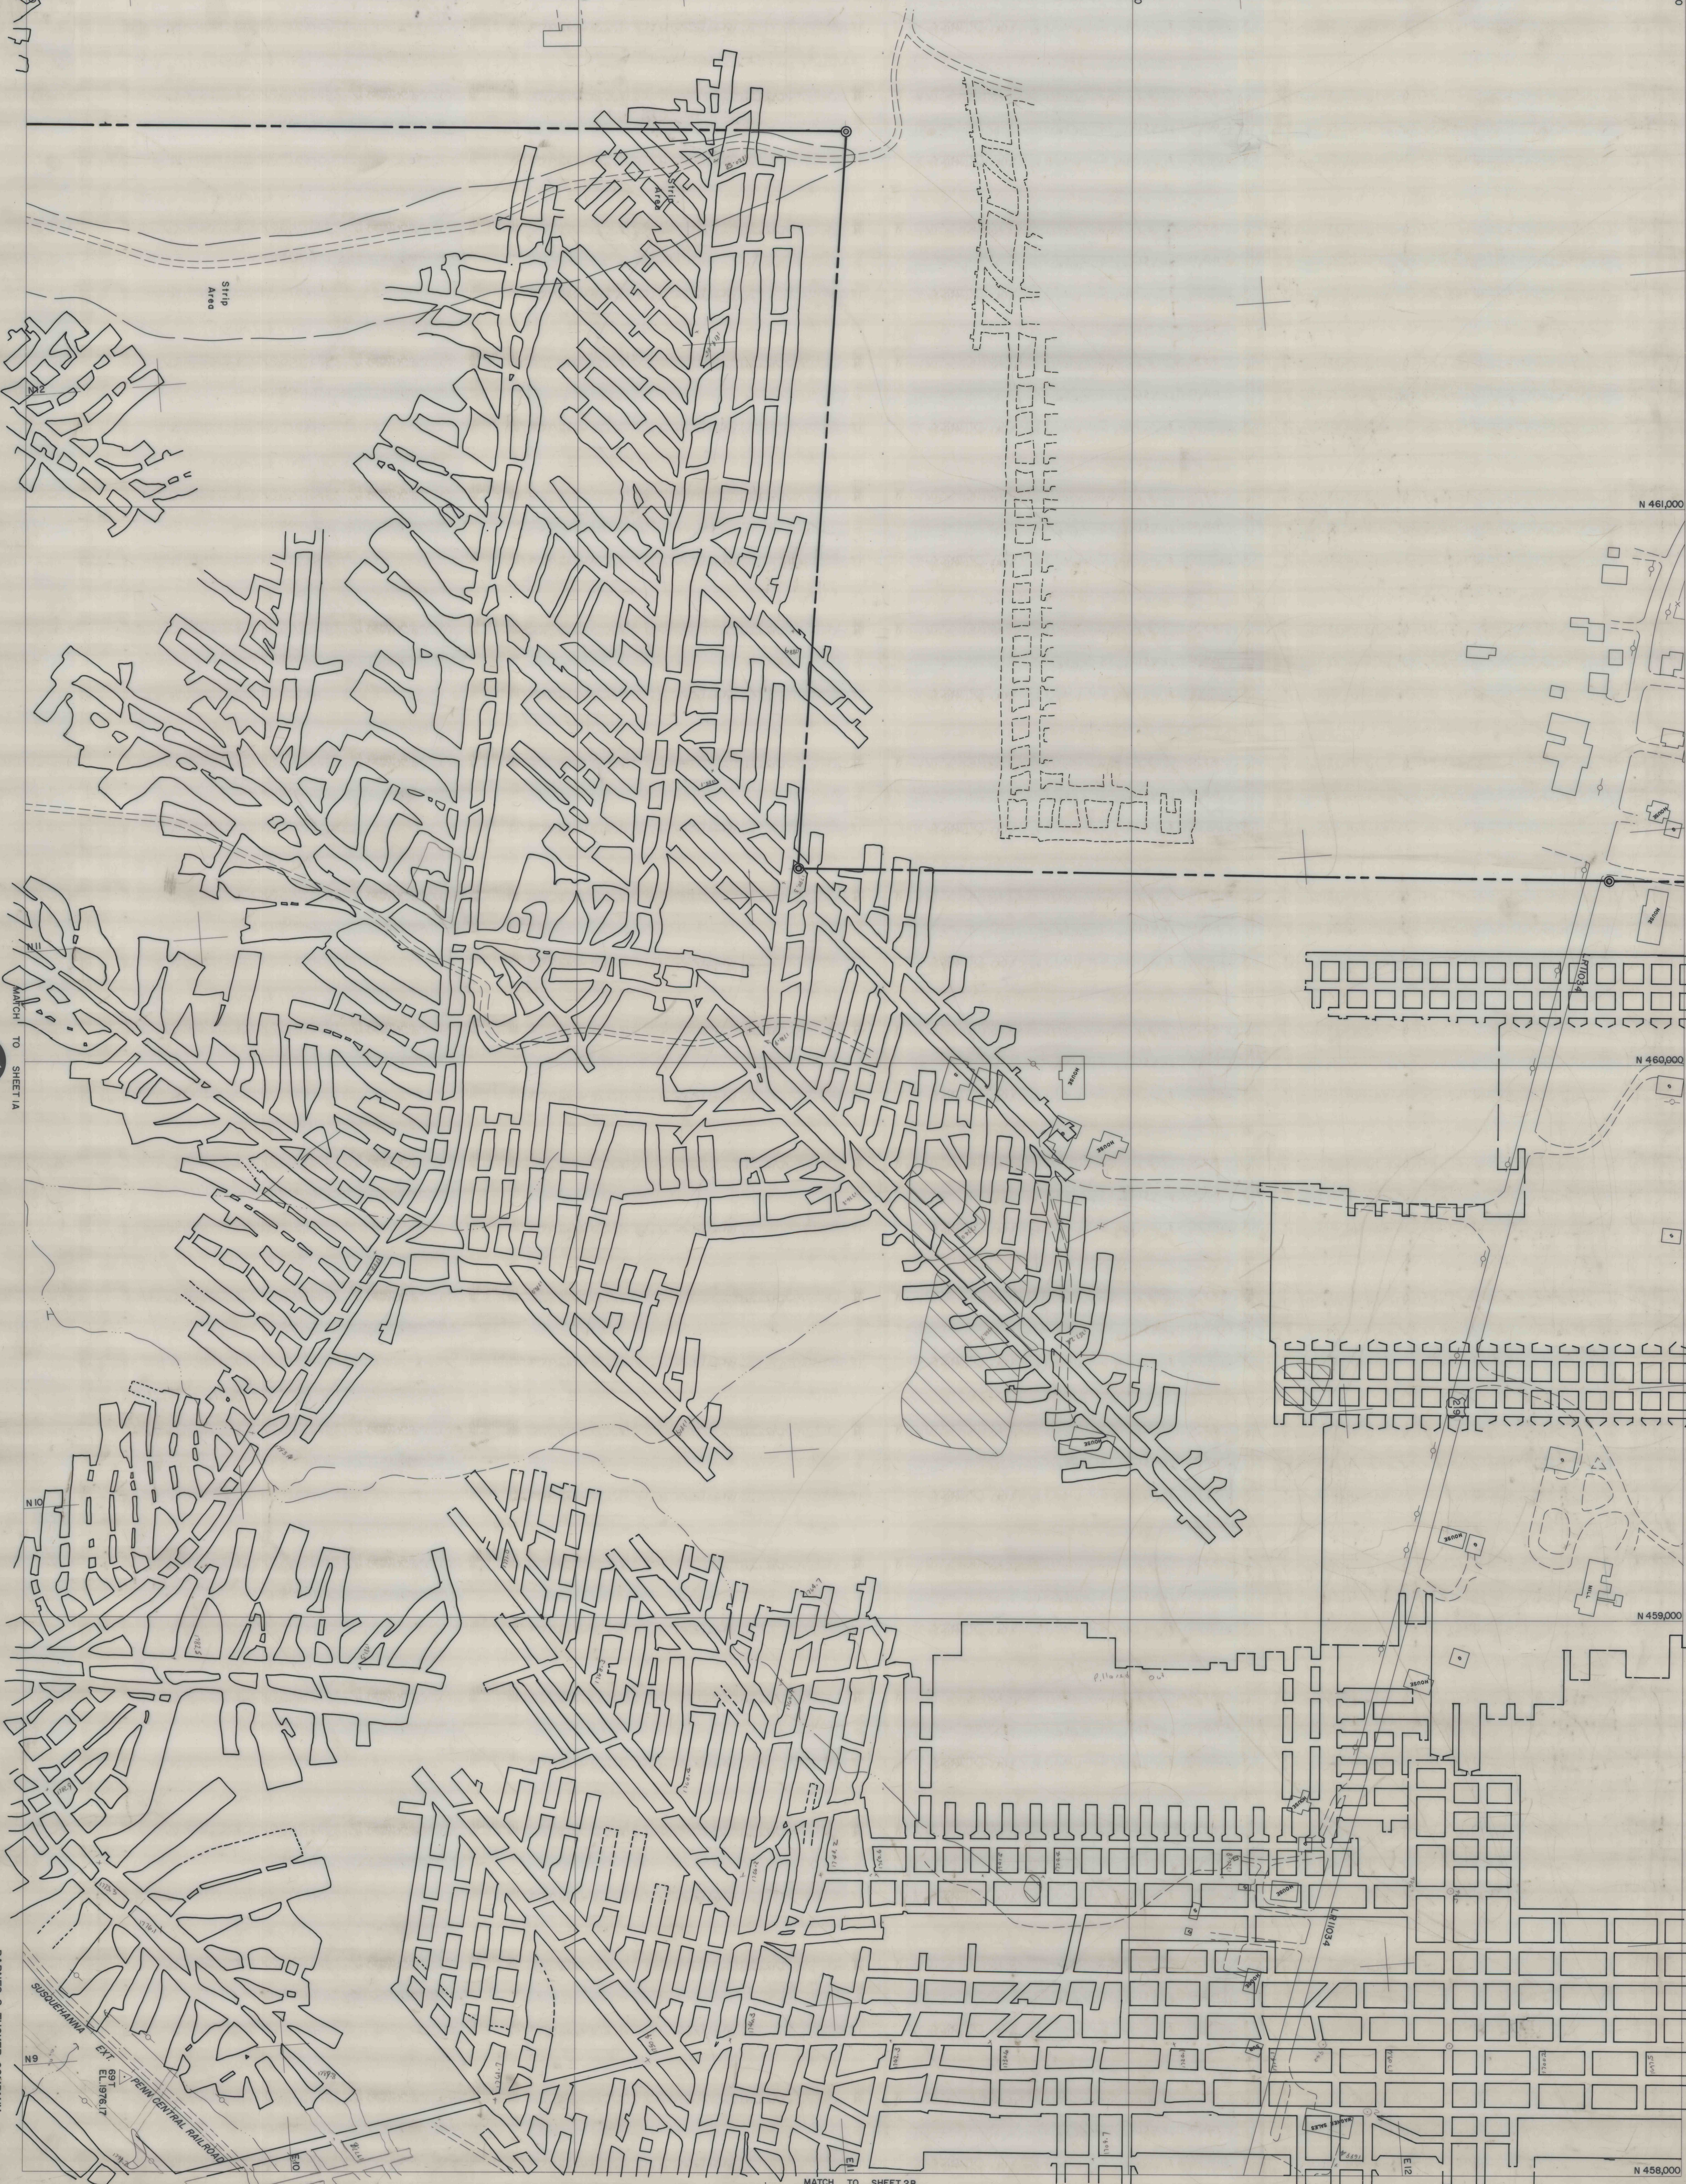

FINAL MAPPING DATE: 01-29-86

4420

BARNES & TUCKER COMPANY  
 LANCASTER NO 20 MINE  
 EAST CARROLL TOWNSHIP, CAMBERIA COUNTY, PENNSYLVANIA  
 SCALE 1"=100'  
 DATE JULY, 1976

18

MATCH TO SHEET 2B