

MATCH TO SHEET 5E

N 442,000  
E 1742,000

N 441,000

N 440,000

N 439,000

N 438,000

E 1741,000

E 1740,000


JAMES PHALEN  
126.52 A.

T. J. ILLIG  
59.86 A.

JOHN J. TIERNEY  
22.04 A.

MICHAEL NOON  
110.54 A.

● DOW 4  
NOT LOCATED

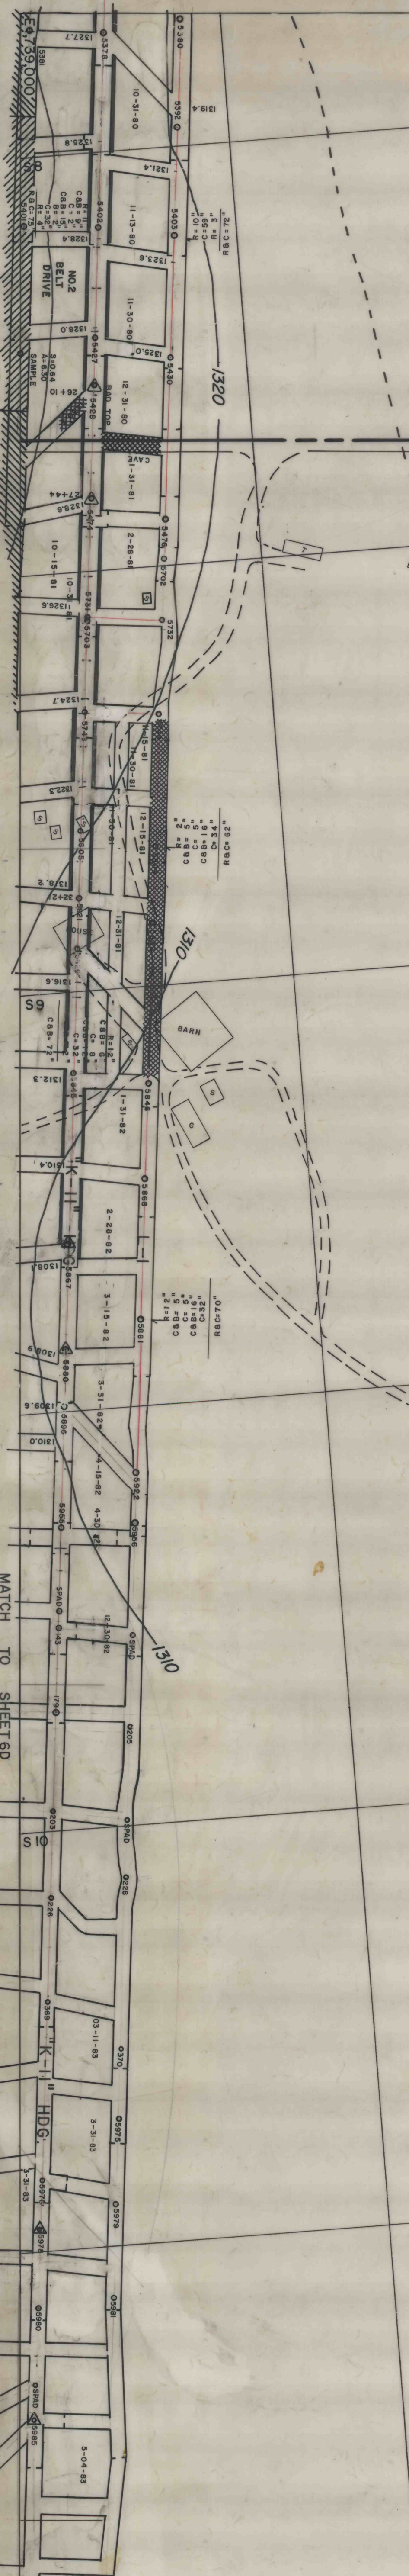


MATCH TO SHEET 5D

FINAL MAPPING DATE: 01-29-86

4420

BARNES & TUCKER COMPANY  
LANCASTER NO. 20 MAP  
EAST CARROLL TOWNSHIP, CAMBRIA COUNTY, PENNSYLVANIA  
SCALE: 1"=100'  
DATE: JULY 1978

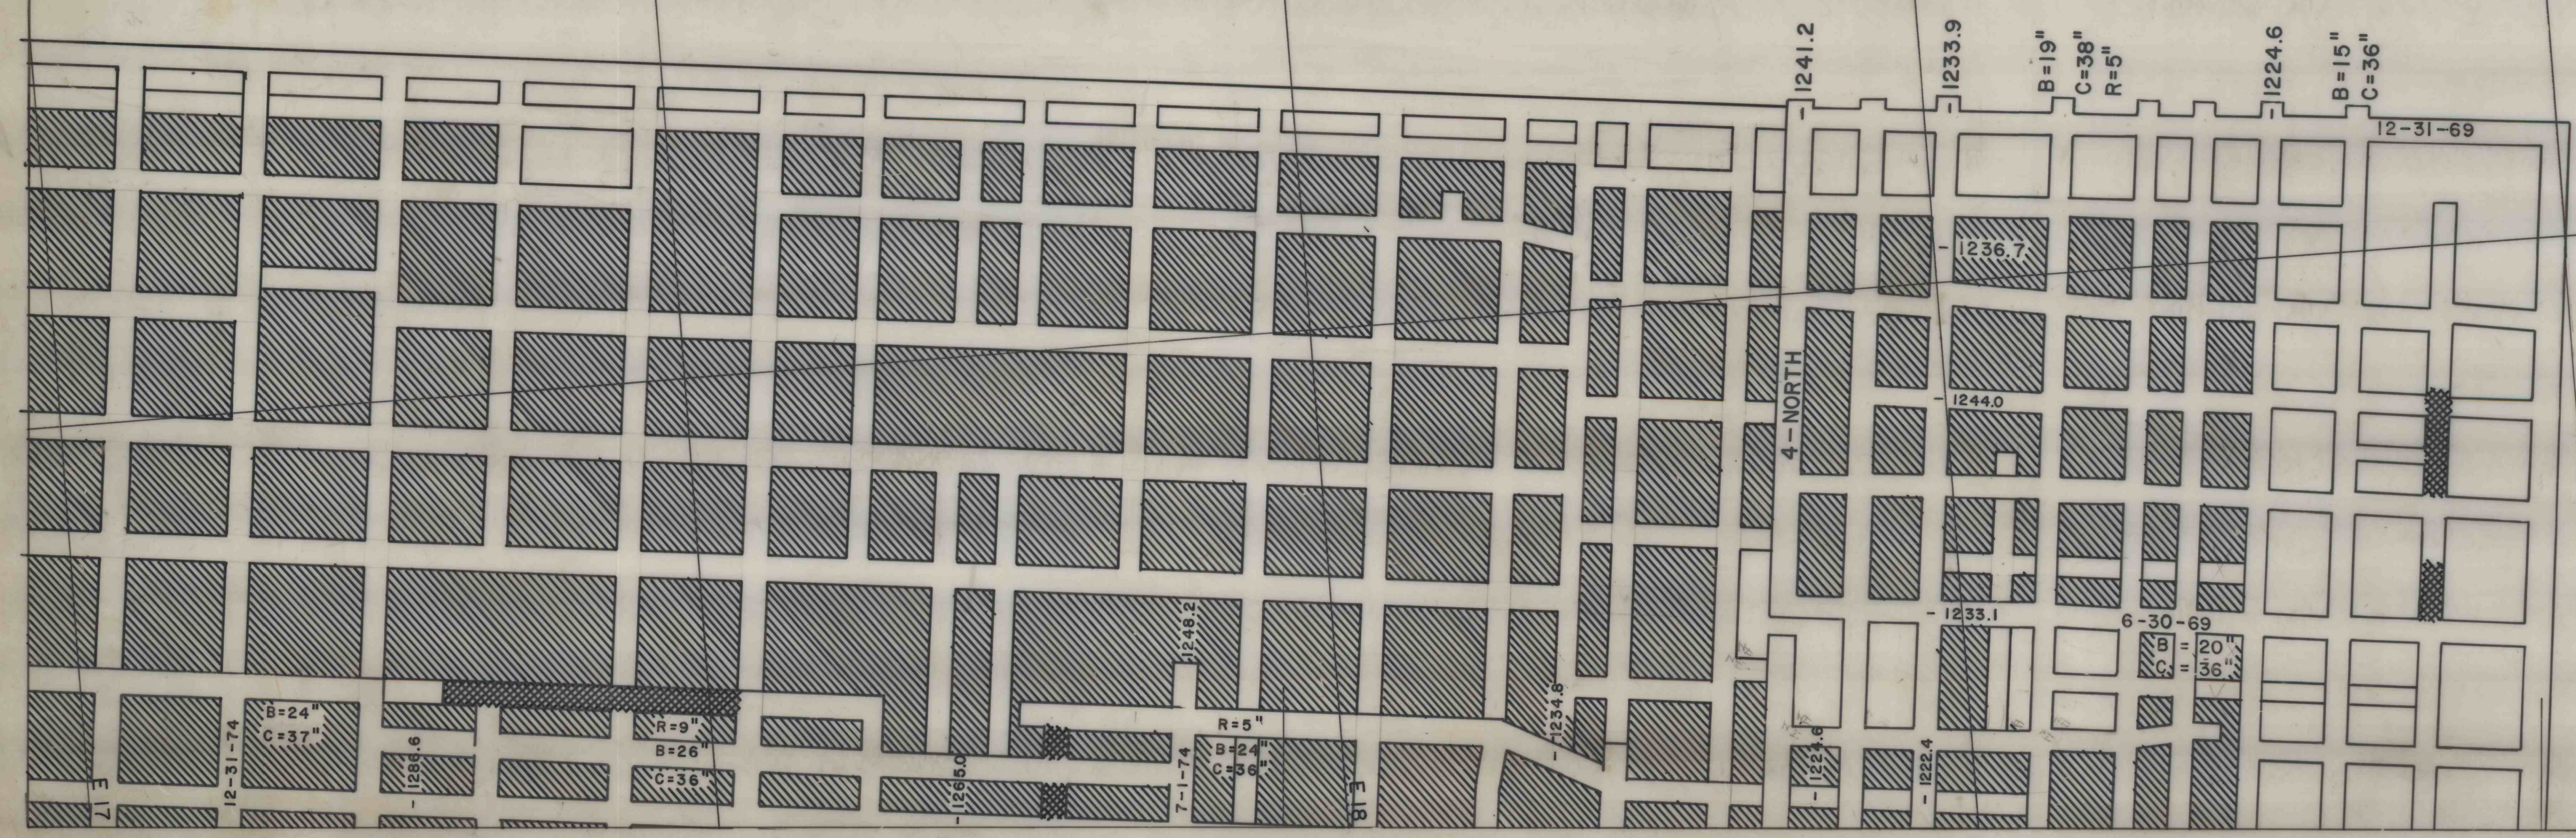

MATCH TO SHEET 6F