


4421



BARNES & TUCKER COMPANY
LANCASHIRE NO. 20 MINE
EAST CARROLL TOWNSHIP, CAMBRIA COUNTY, PENNSYLVANIA
SCALE: 1" = 40'
DATE: JULY 1978

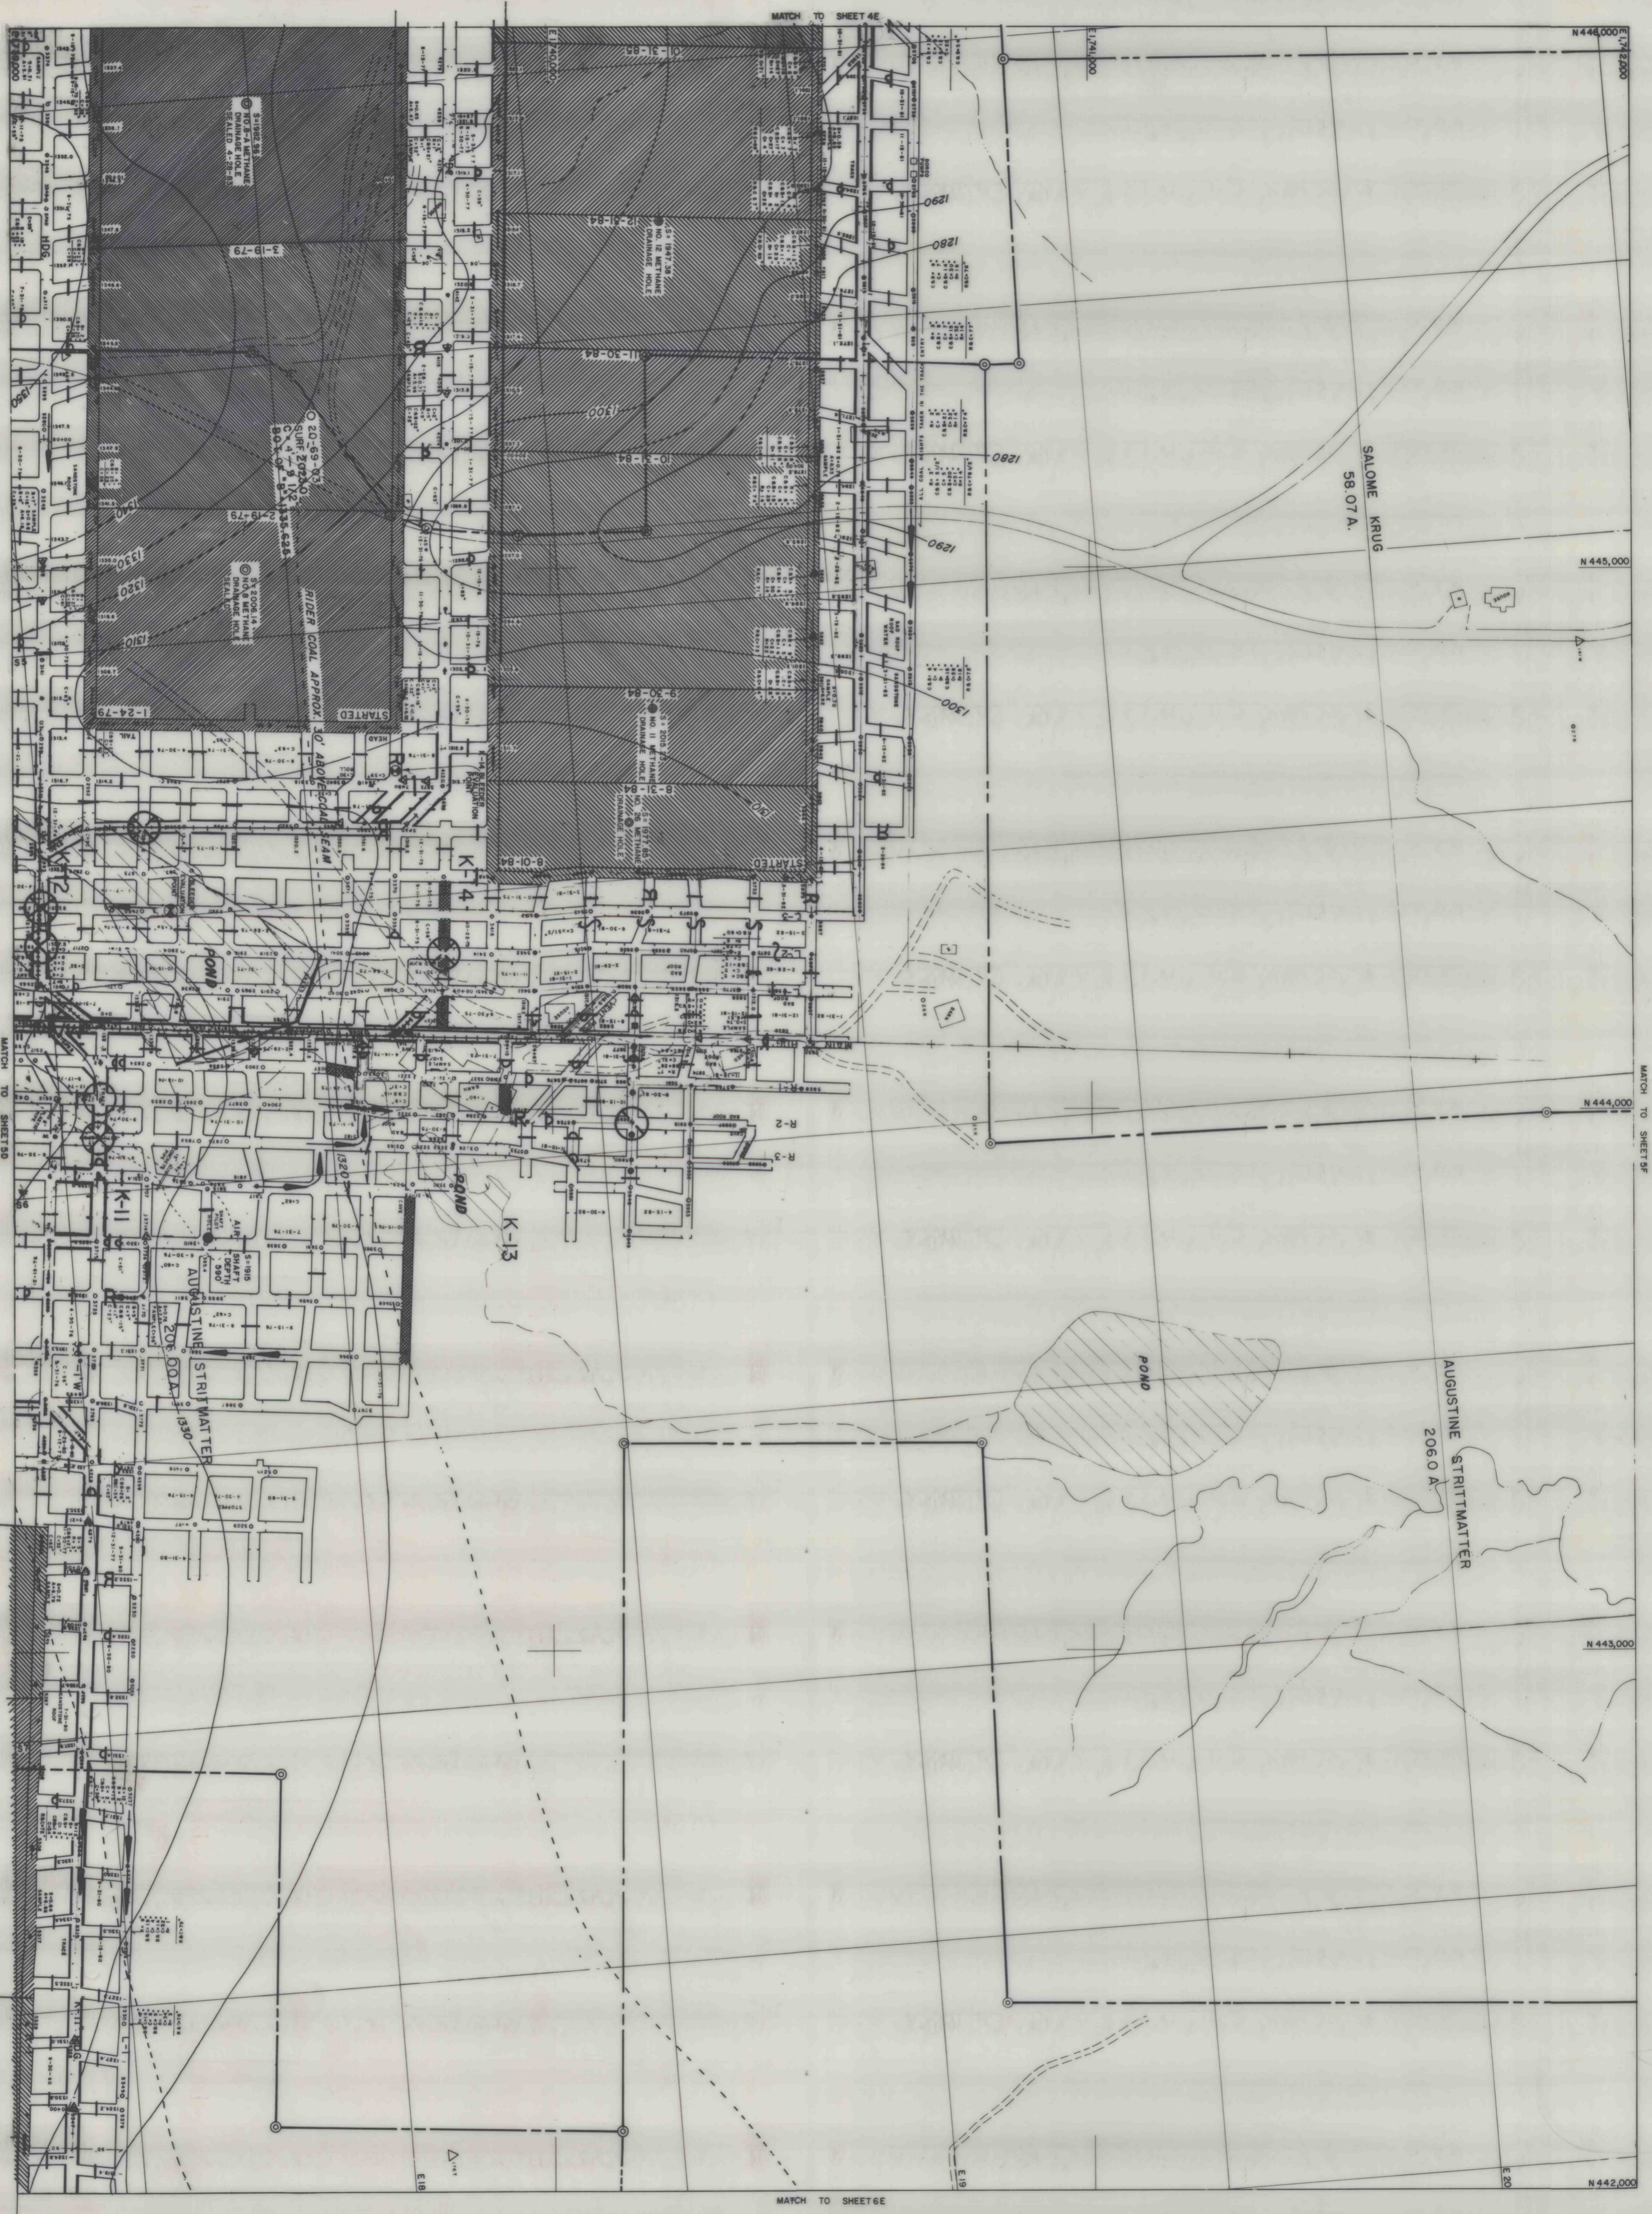


MATCH TO SHEET 4E

MATCH TO SHEET 6E

MATCH TO SHEET 5F

N 446,000
N 445,000
N 444,000
N 443,000
N 442,000
