


4421

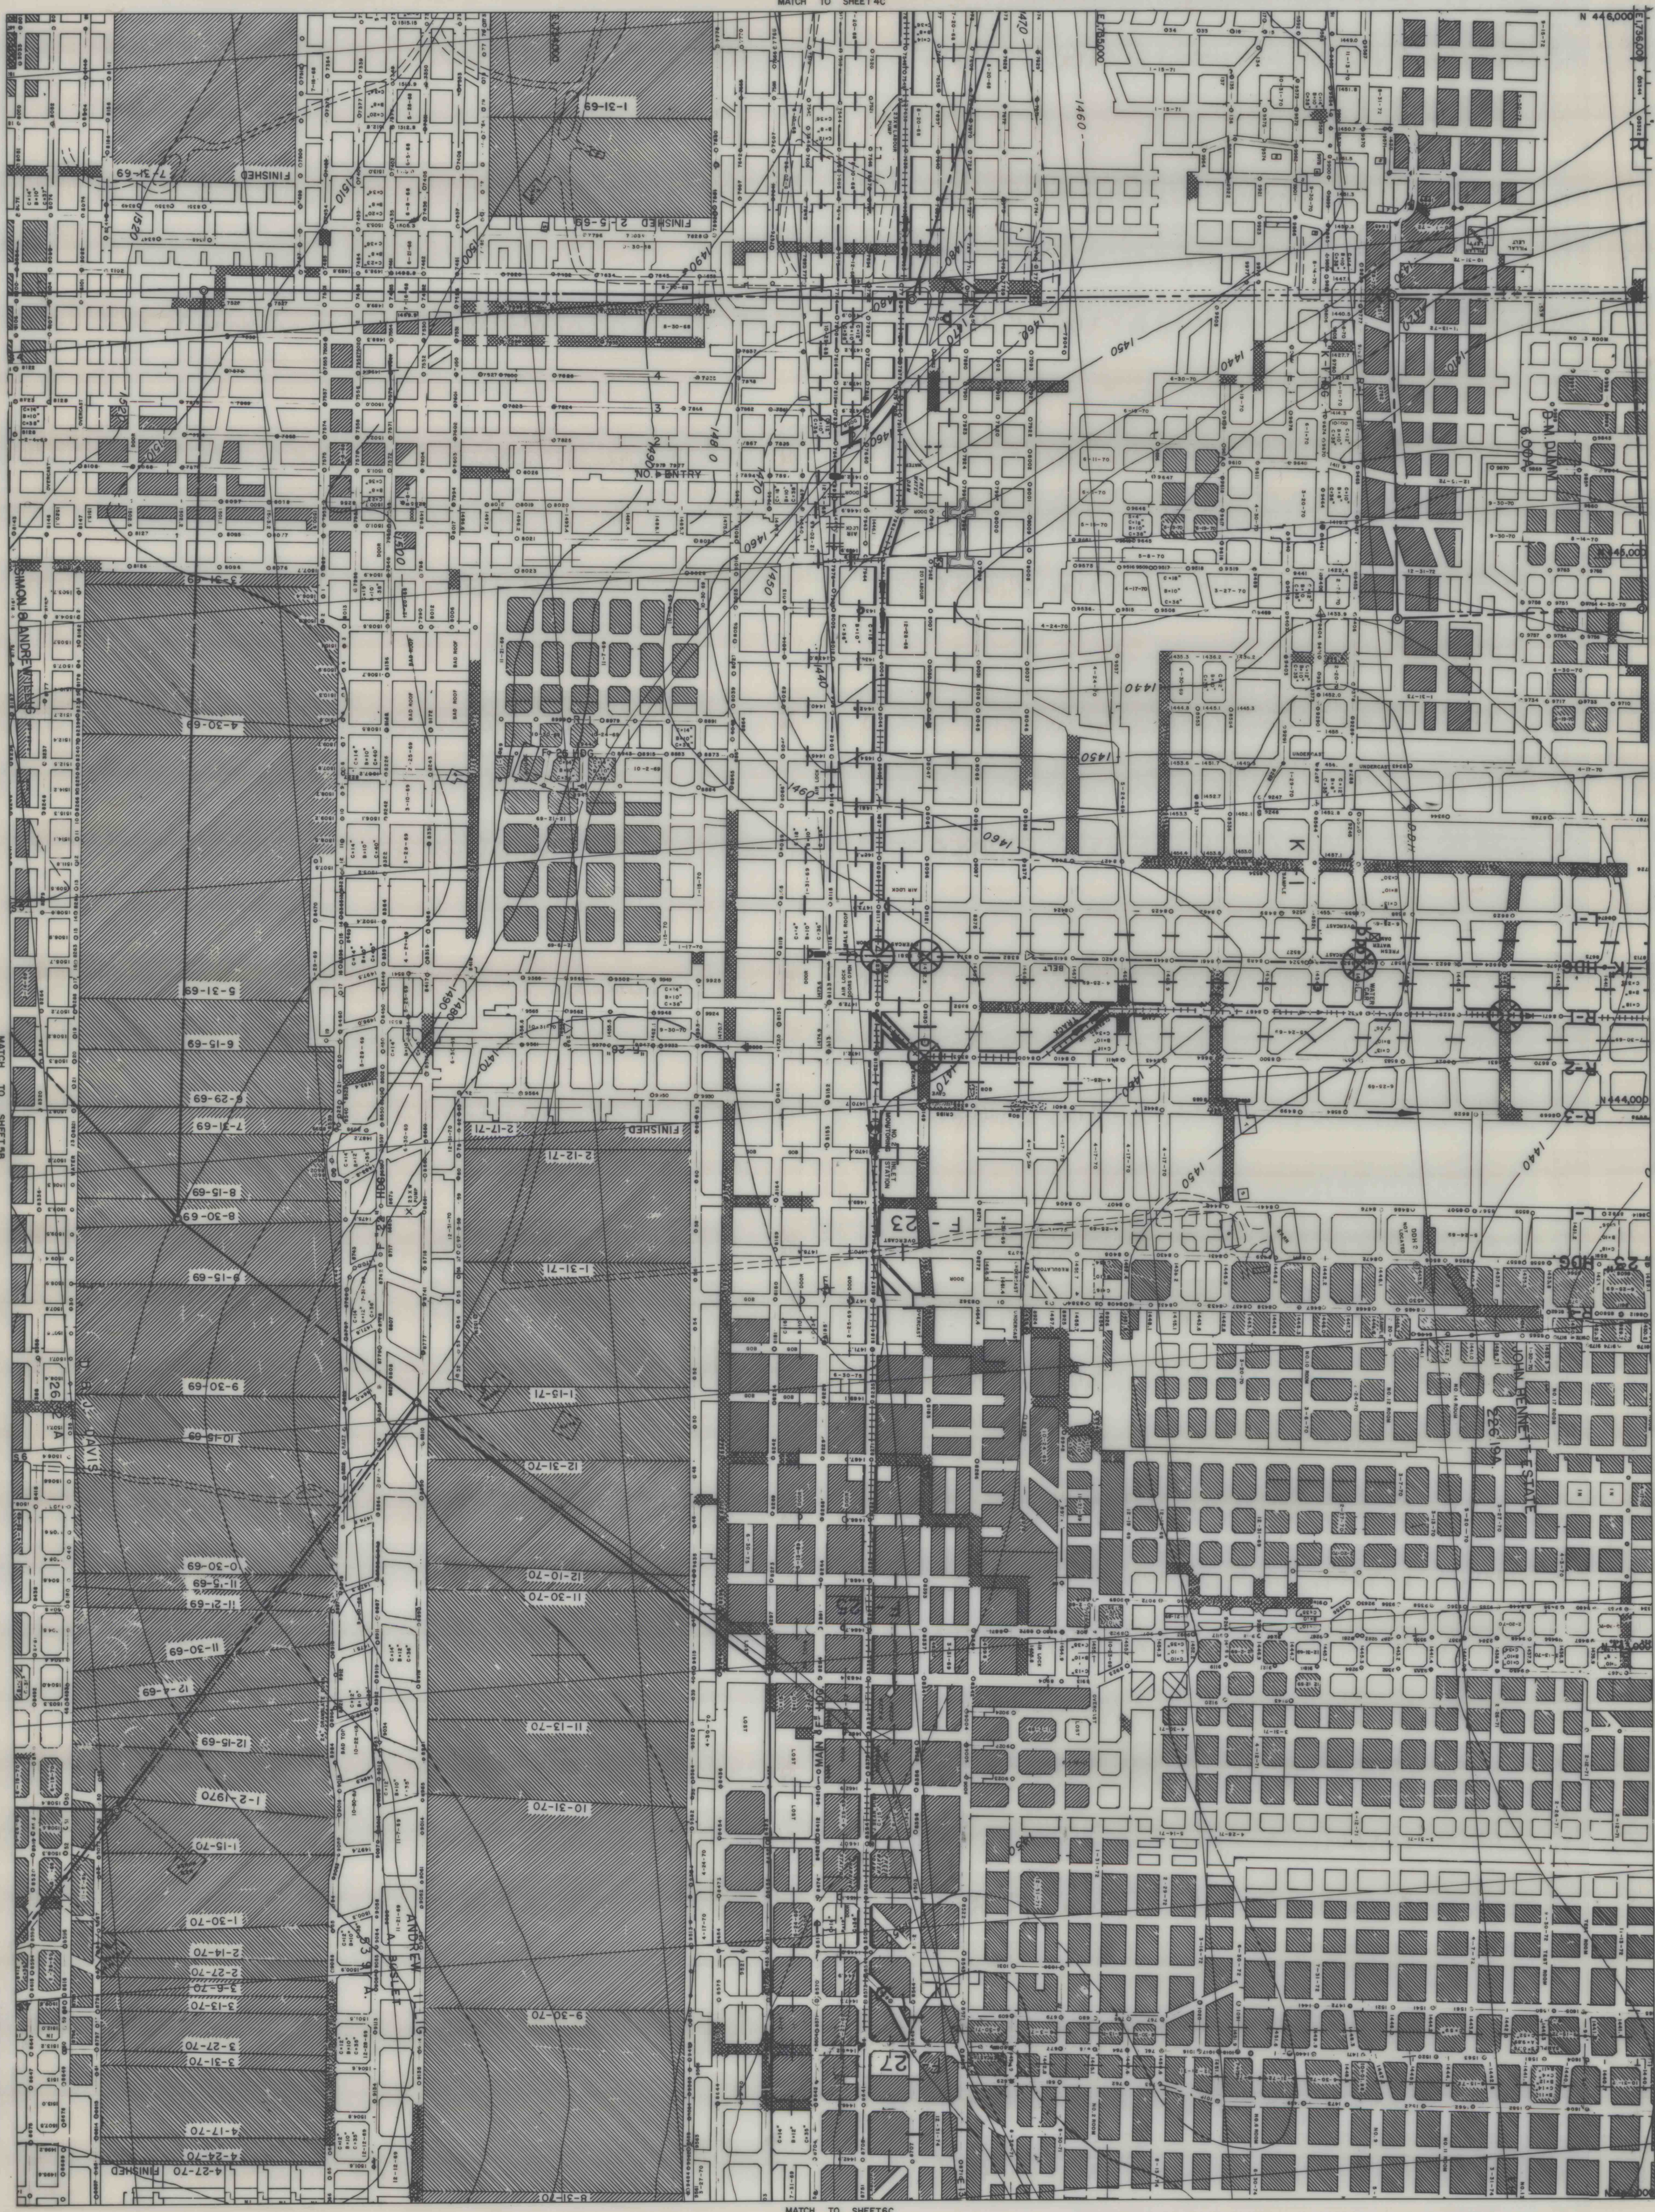

BARNES & TUCKER COMPANY
 LANCASTER NO. 20 MINE
 EAST CARROLL TOWNSHIP, CAMBRIA COUNTY, PENNSYLVANIA
 DATE JULY 1976

