


MATCH TO SHEET 3E

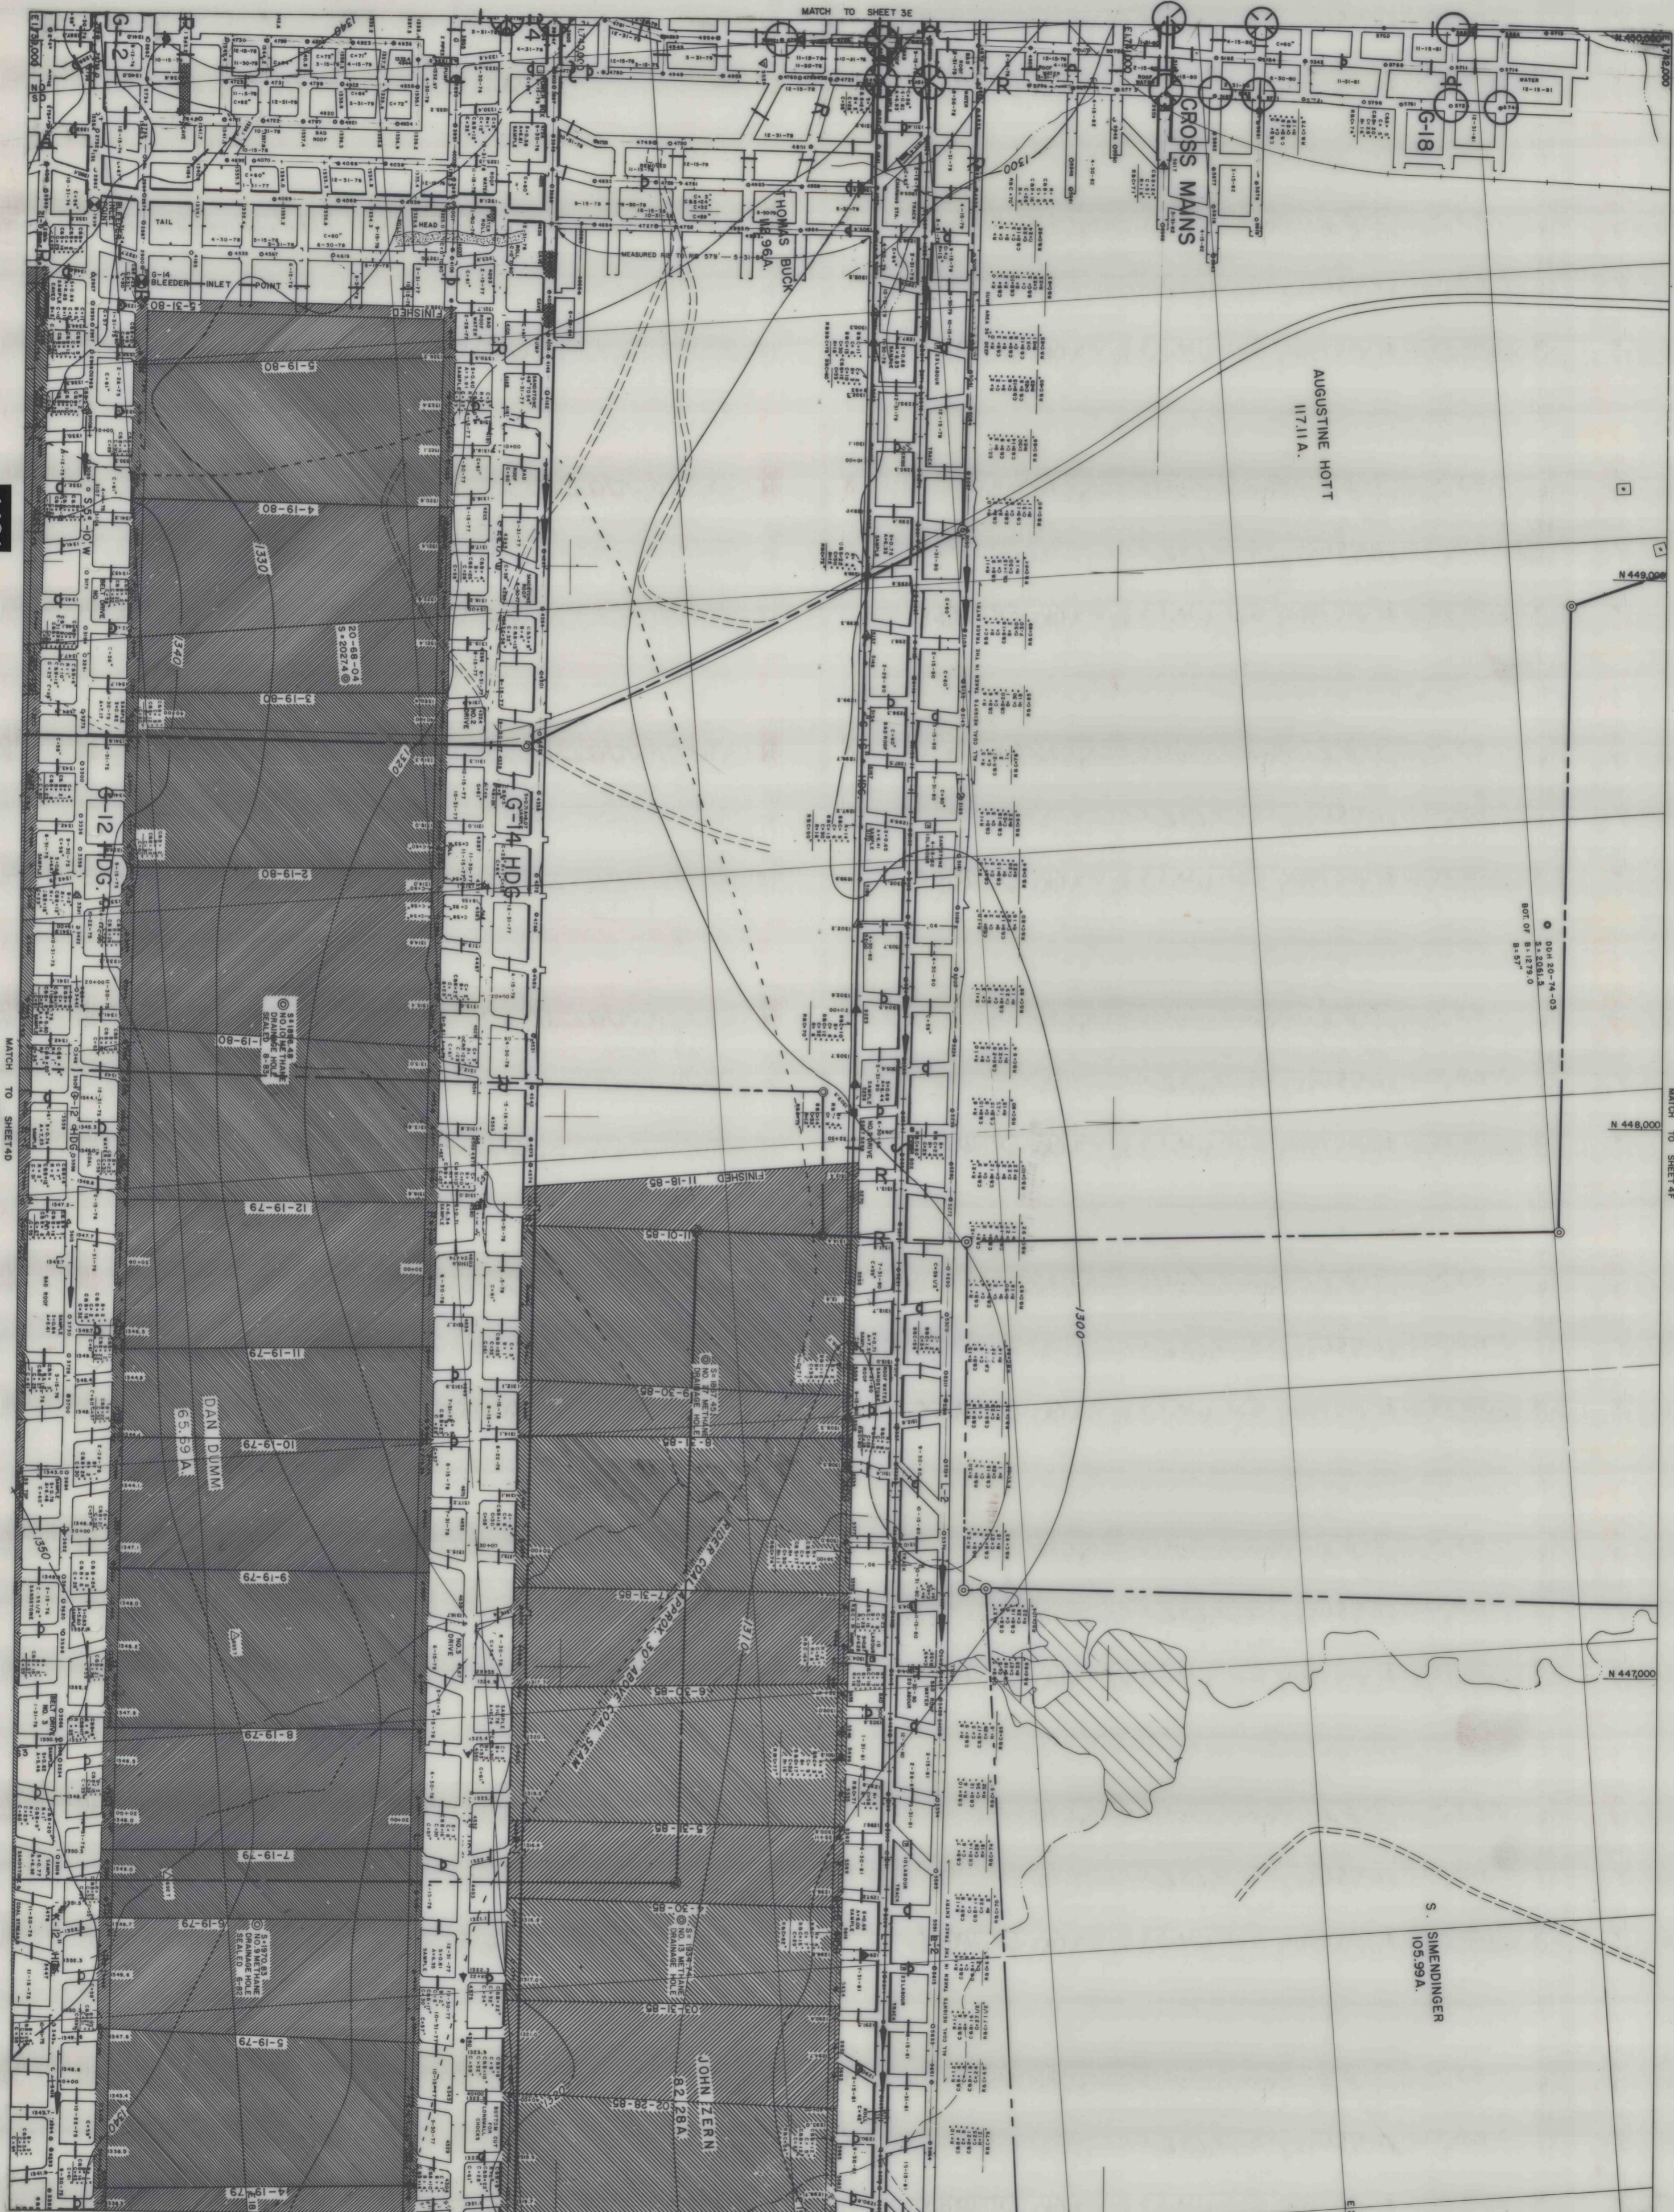

AUGUSTINE HOTT
11711 A.

CROSS MAINS

THOMAS BUCK
11711 A

4-19-80

3-19-80

2-19-80

1-19-80

12-19-79

11-19-79

10-19-79

9-19-79

8-19-79

7-19-79

6-19-79

5-19-79

4-19-79

DAN DUNN
65,591 A.

JOHN ZERN
82,281 A.

4421

MATCH TO SHEET 4D



MATCH TO SHEET 5E

N 449,000

N 448,000

N 447,000

N 446,000

DDH 30-74-03
S. 2081.5
BOT OF 8'-1279.0
8'-4.07'

S. SIMENDINGER
105,99 A.

BARNES & TUCKER COMPANY

4E