


4421

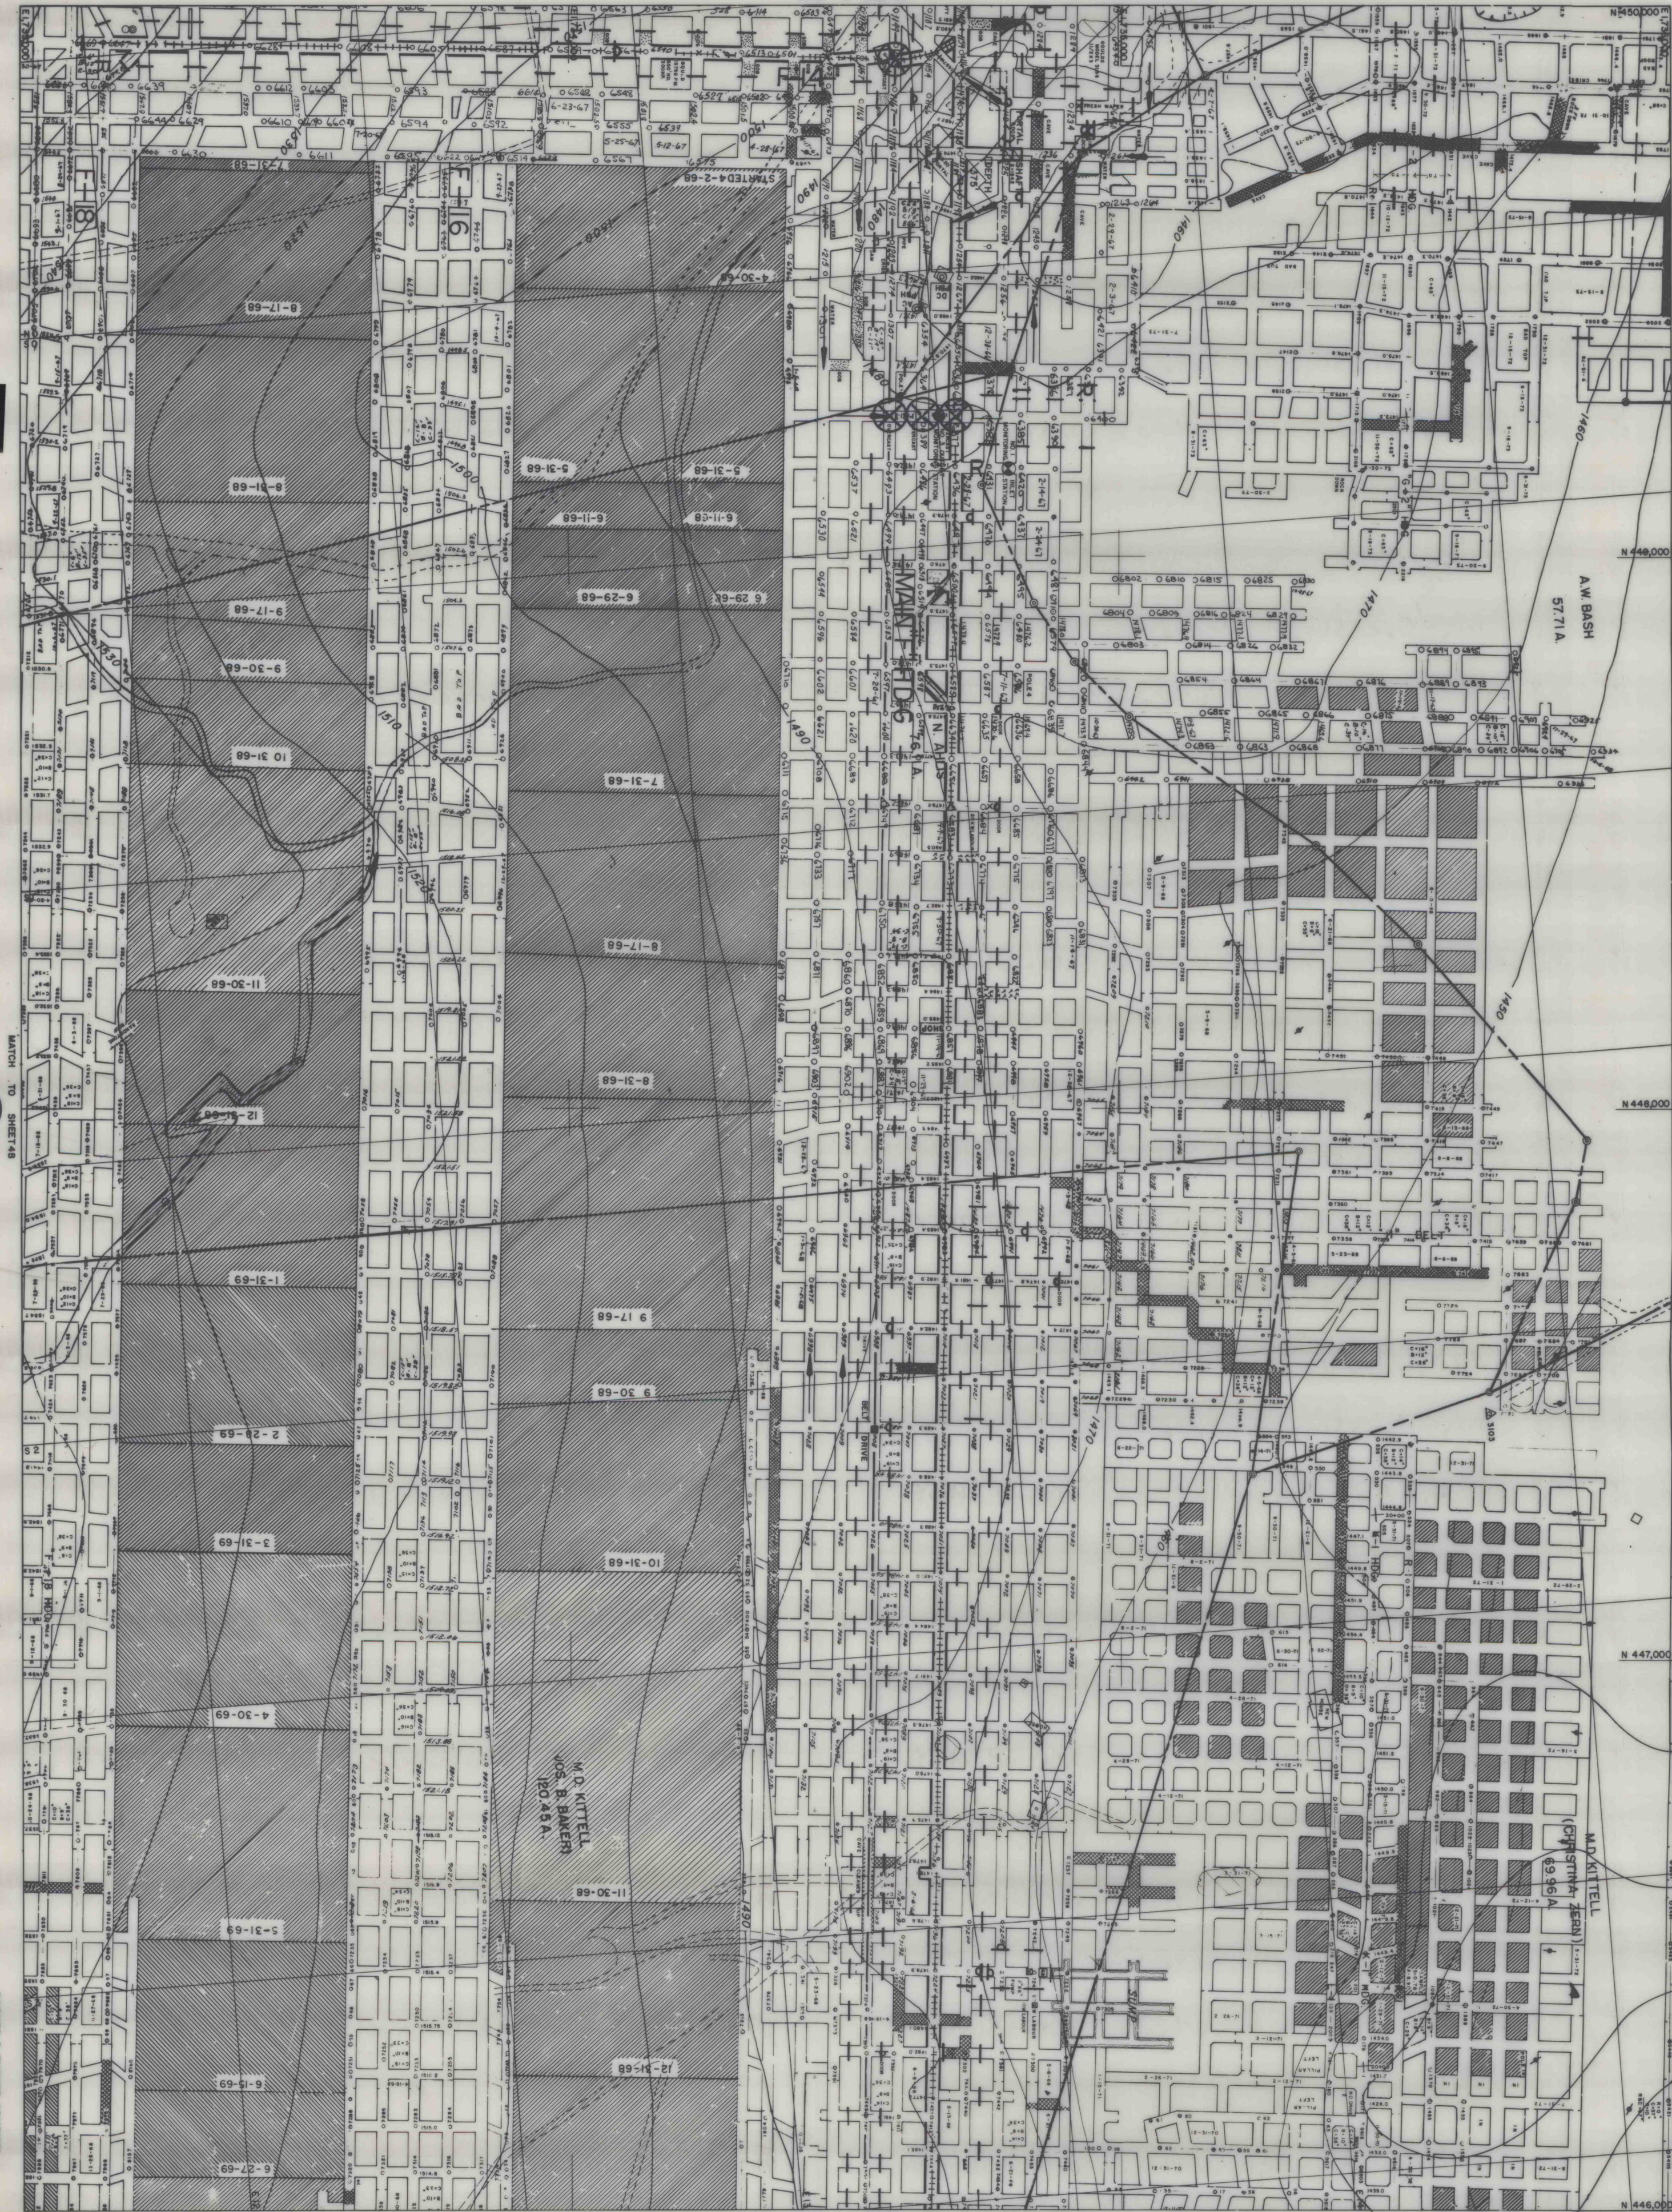

MATCH TO SHEET 4B


