


4421



BARNES & TUCKER COMPANY
LANCASHIRE NO. 20 MINE
EAST CARROLL TOWNSHIP, CAMBRIA COUNTY, PENNSYLVANIA
DATE: JULY, 1976

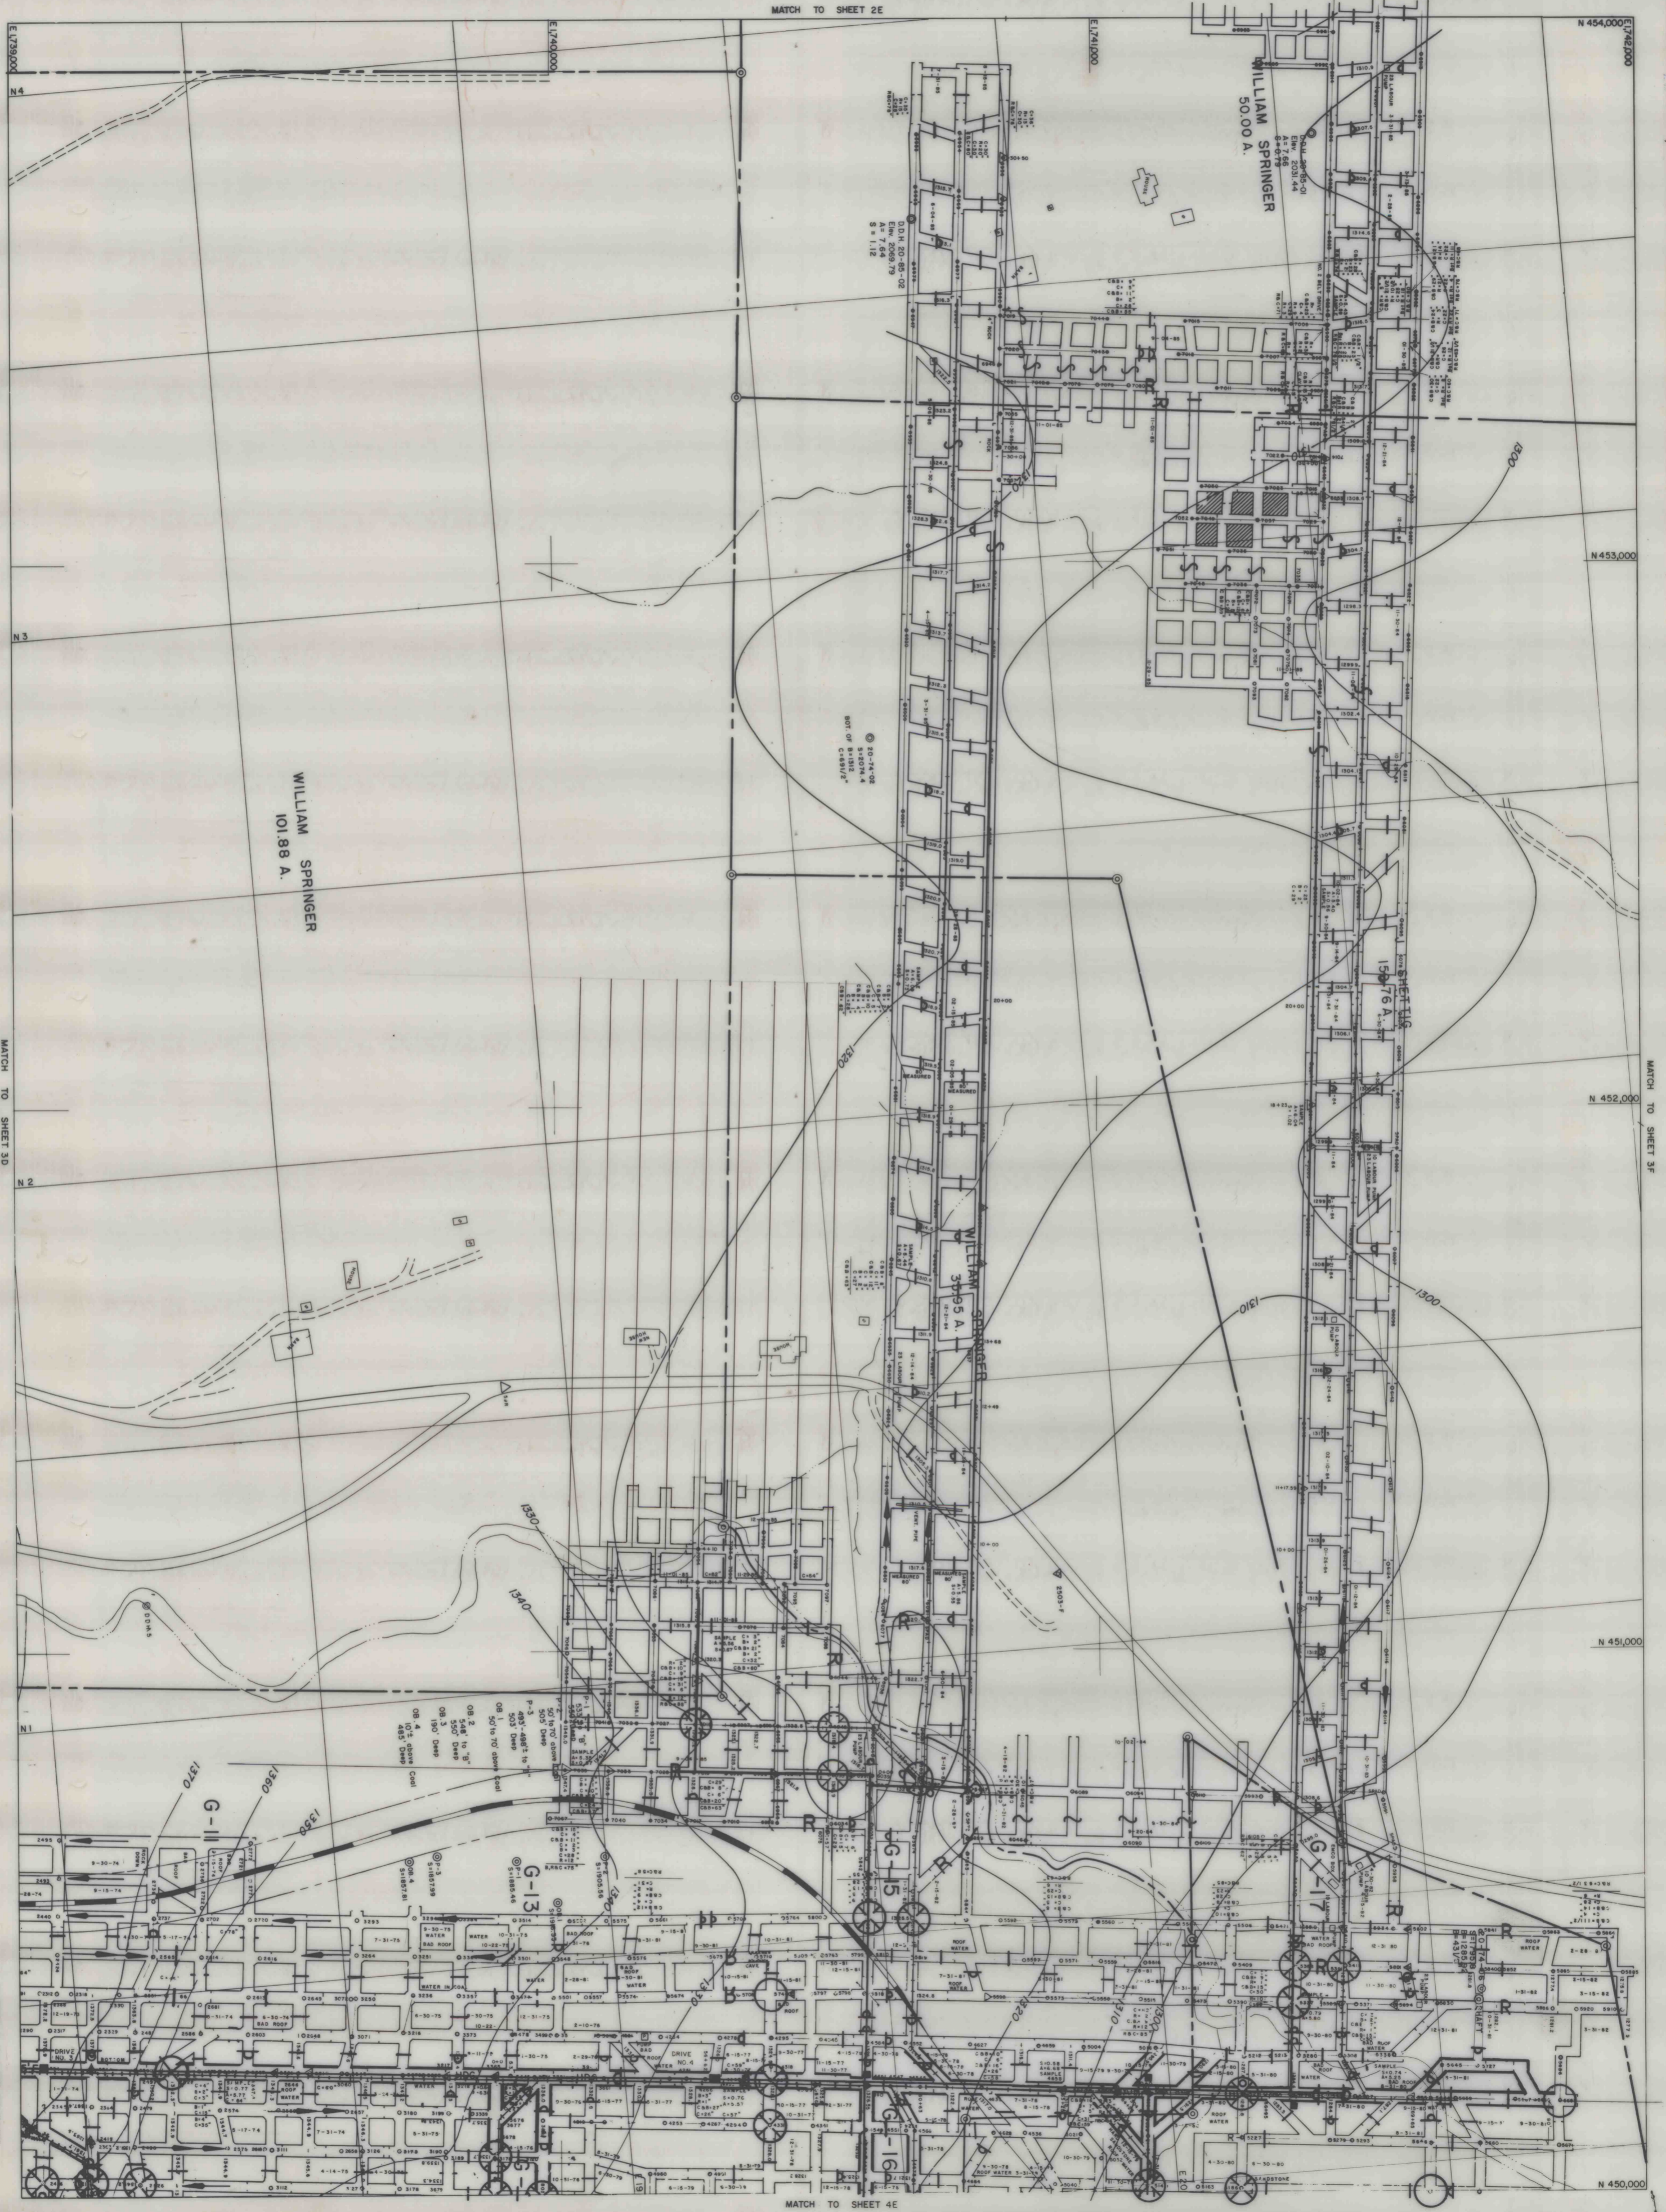

MATCH TO SHEET 3D

MATCH TO SHEET 3F