


4421

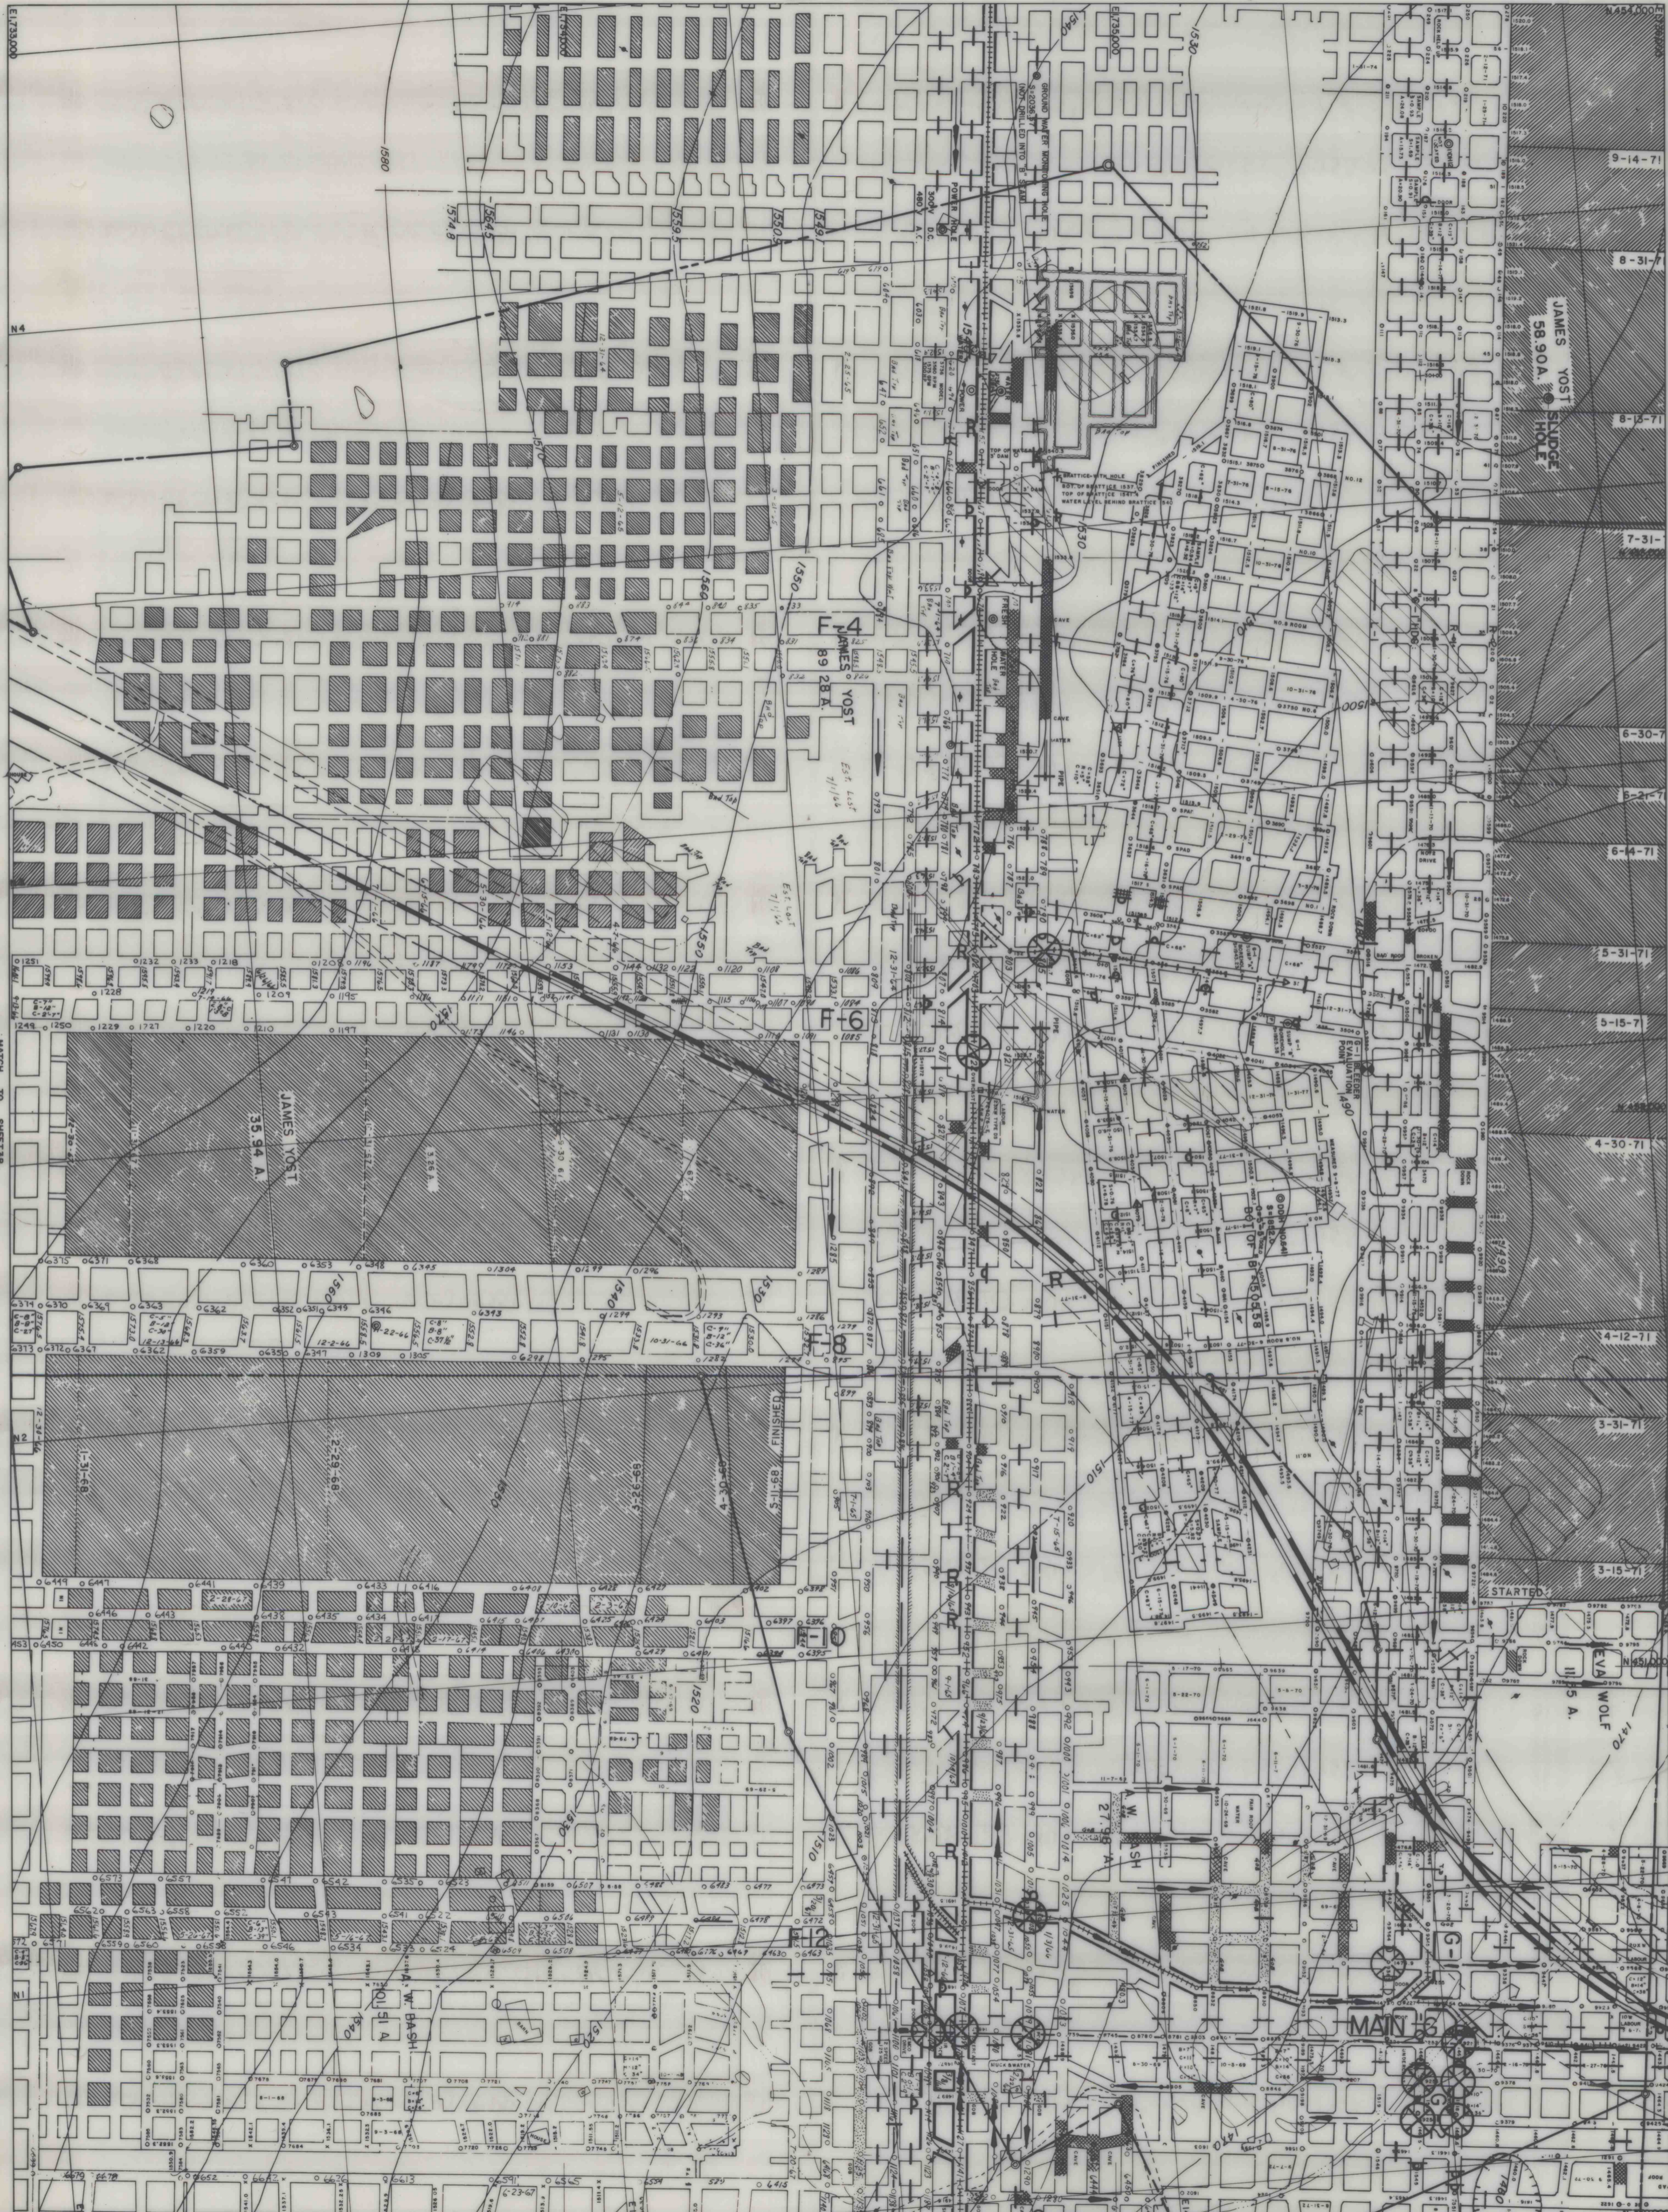

MATCH TO SHEET 3B



MATCH TO SHEET 3D

BARNES & TUCKER COMPANY  
 LANCASTER NO. 20 MINE  
 EAST CARROLL TOWNSHIP, CAMBERIA COUNTY, PENNSYLVANIA  
 SCALE 1"=100'  
 DATE JULY, 1918

3C