


Exhibit A

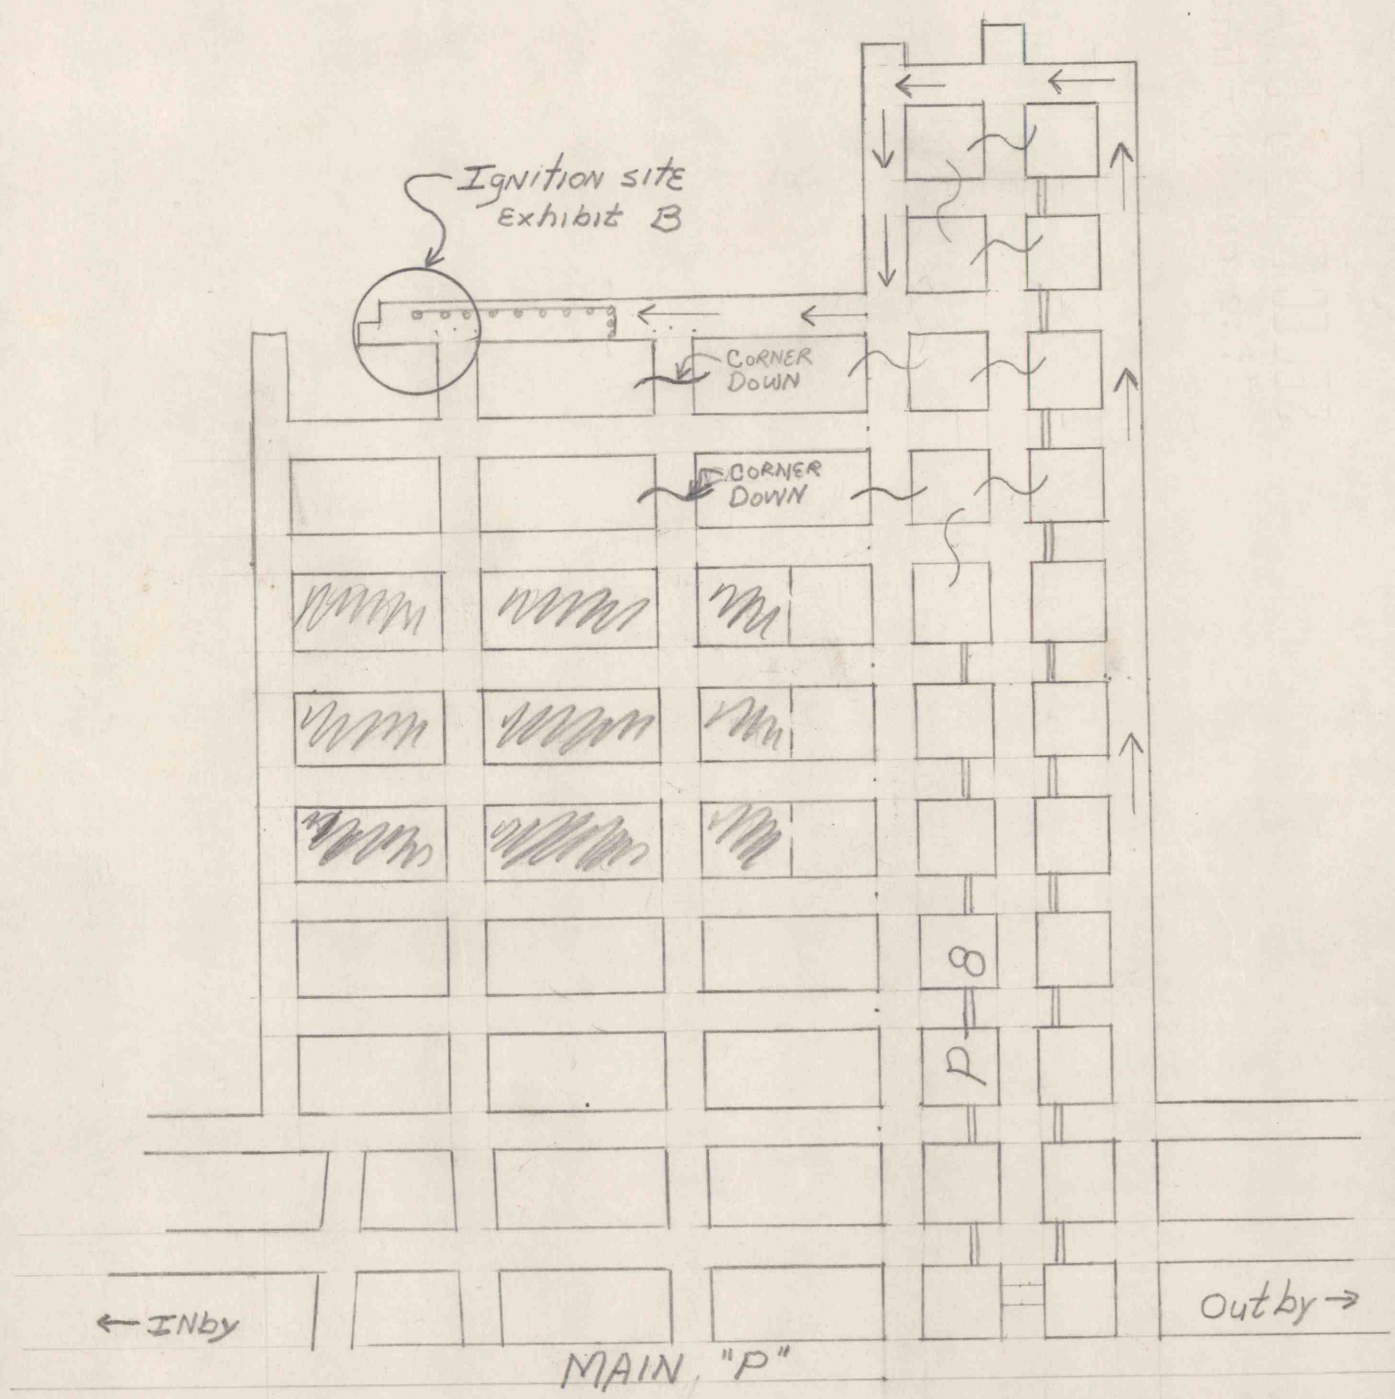

BARNES & TUCKER Co
LANCASHIRE #15
P-8 Heading
Ignition Sight
SCALE: 1"=100'
9/27/67