


Fatal Accident
 Walter Miller.
 Lane #24 Mine.
 Bseam section A-5
 April 19, 1967 6:40 PM.
 Scale 1" = 100'

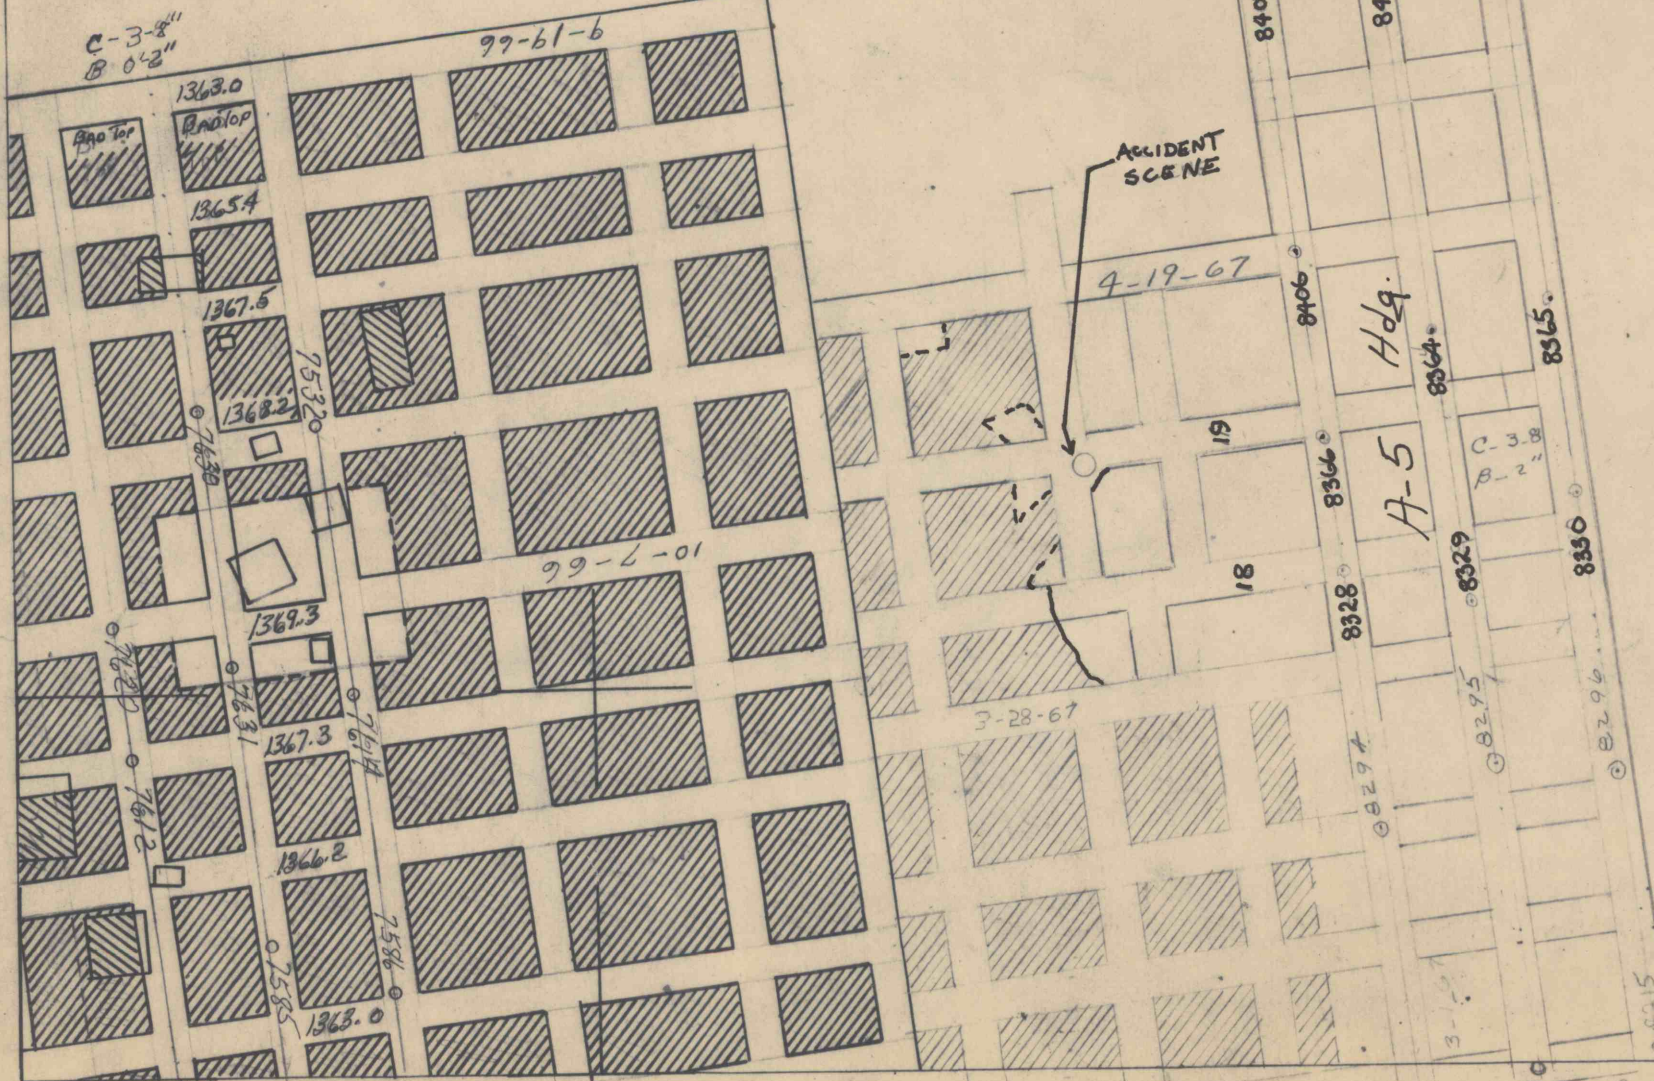

Matt. 70 18